


Township 3.N., Range 22 E.W.M.

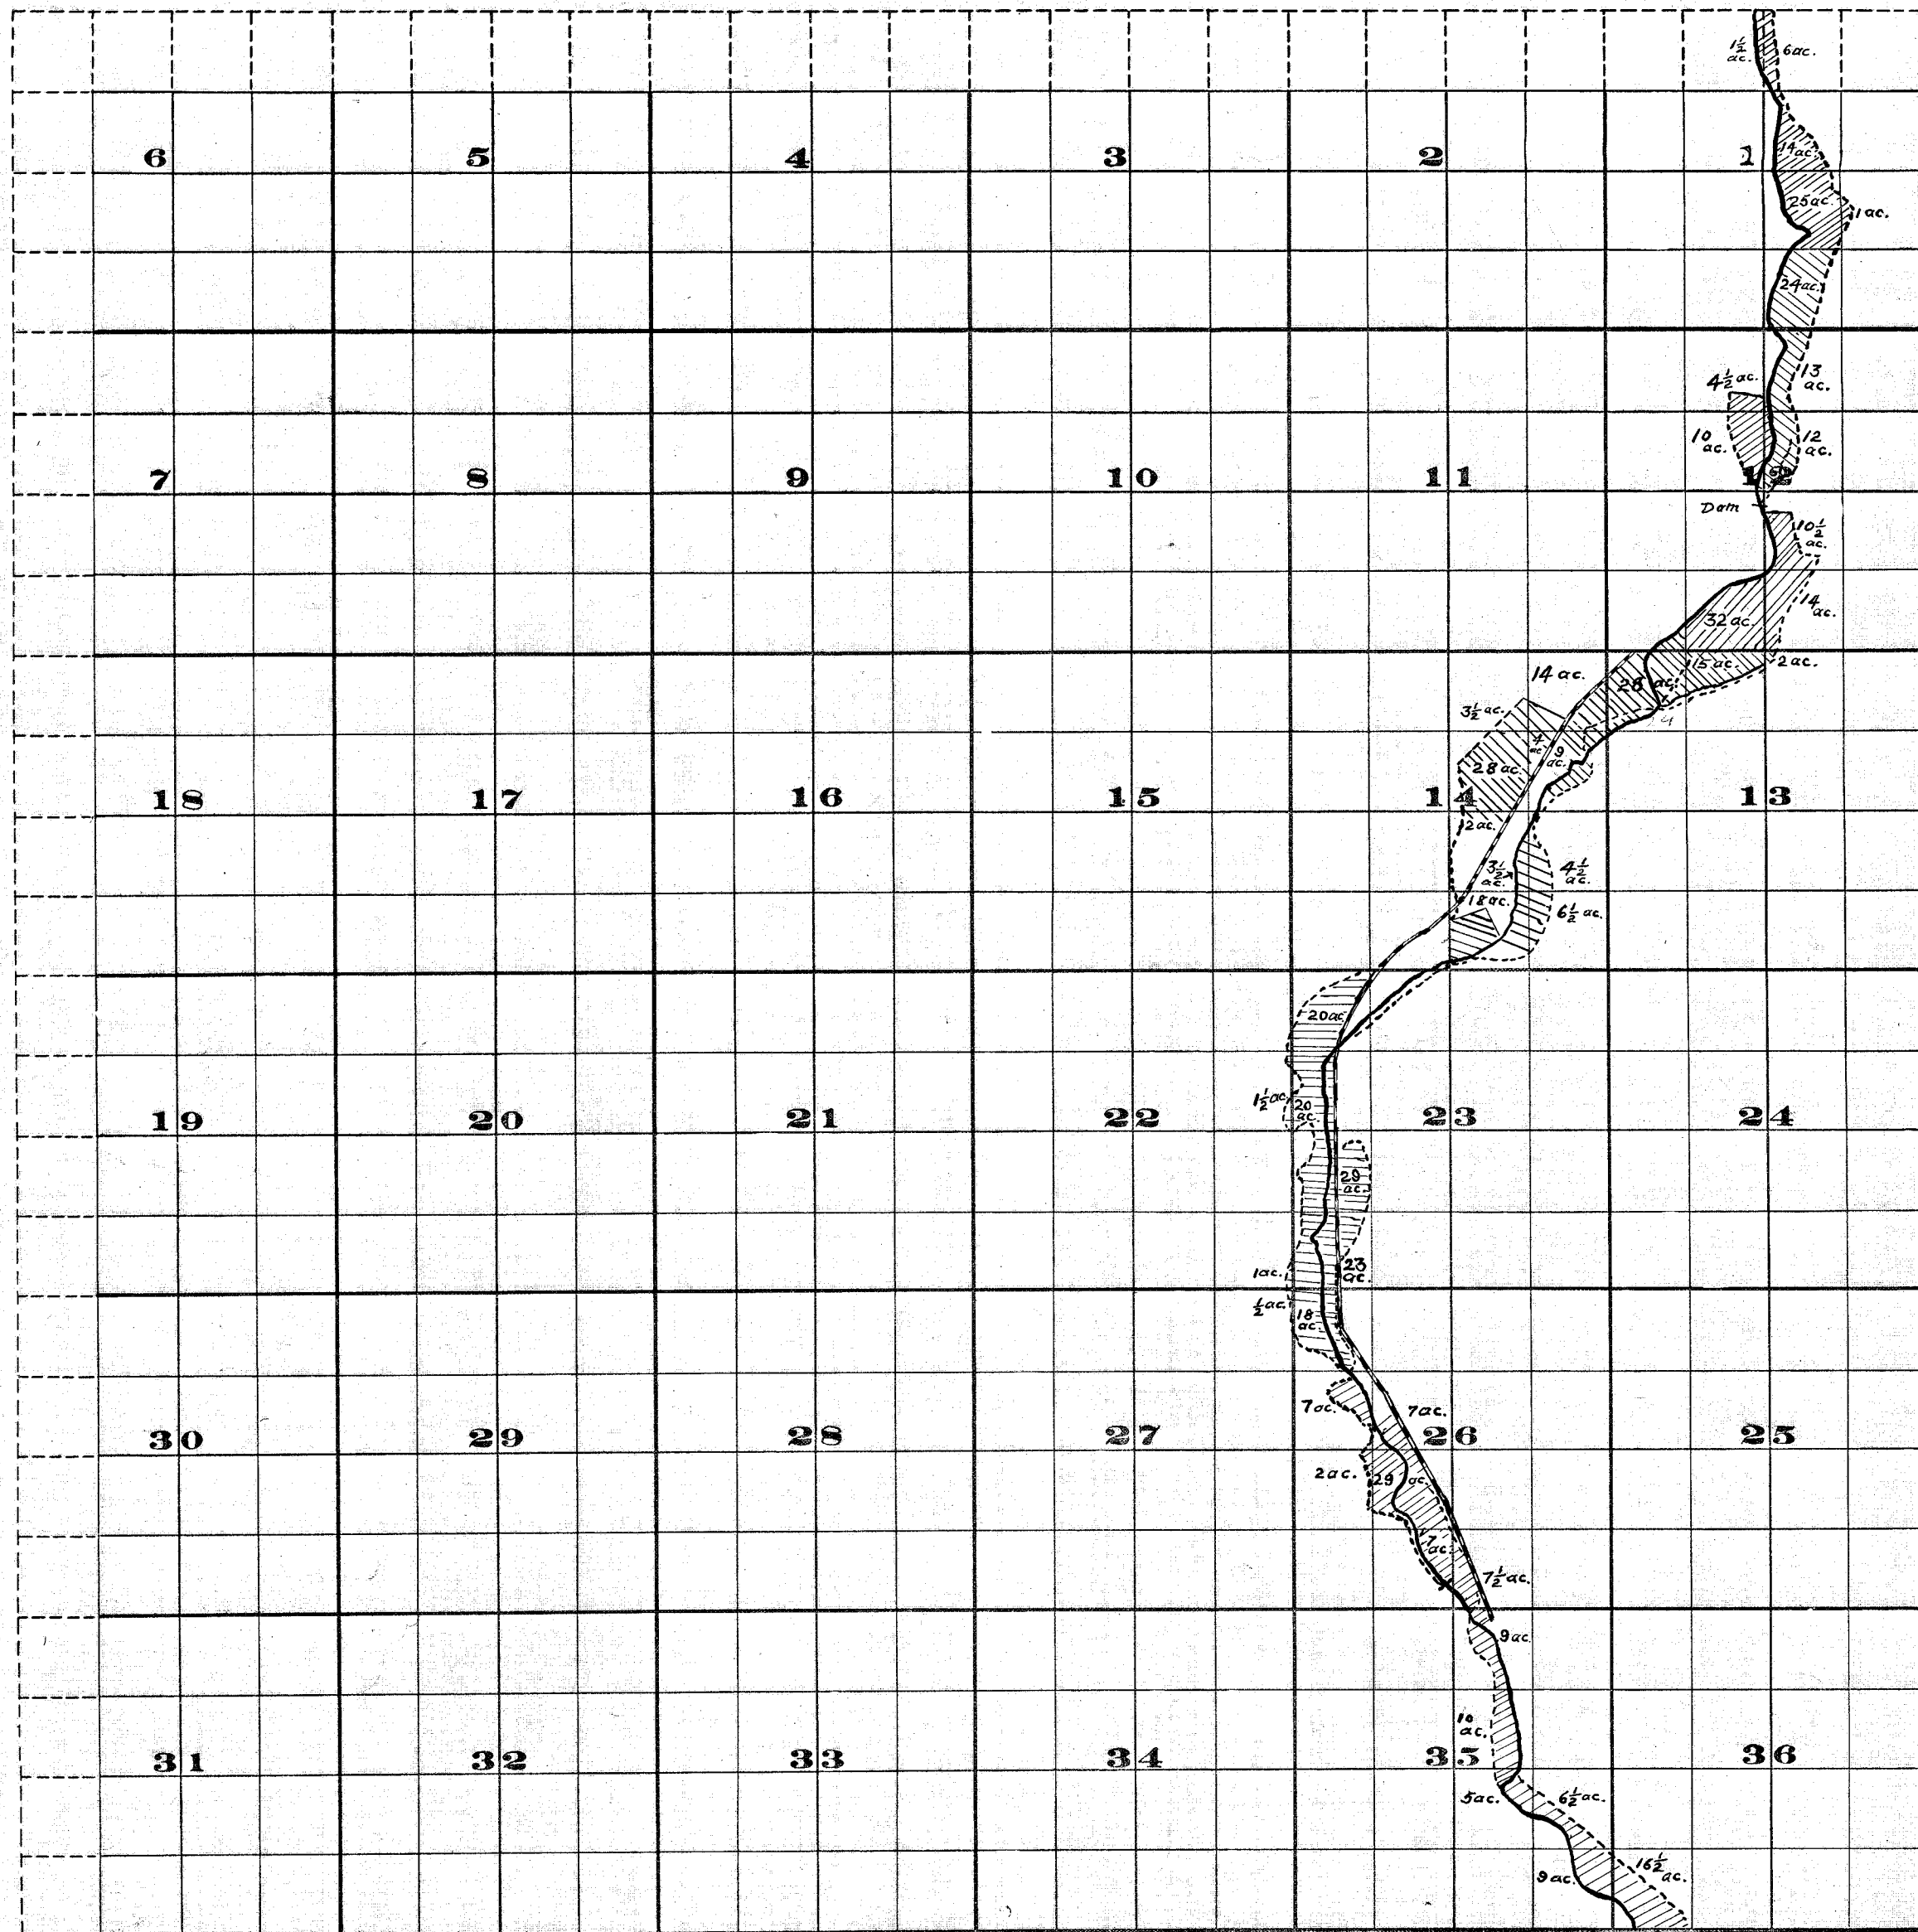

THE S. BRISTOL CO., PRINTERS & BOOKBINDERS, CHEYENNE, WYO

FROM OFFICE OF THE STATE ENGINEER, SALEM, OREGON

Surveyed by H.K. Donnelly July 1909
 John H. Lewis - State Engineer
 Examined - July 14, 1909

Willow Creek Adjudication.