
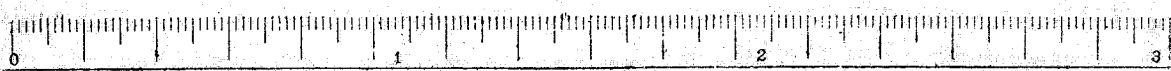


Township 175, Range 44E. W.M.

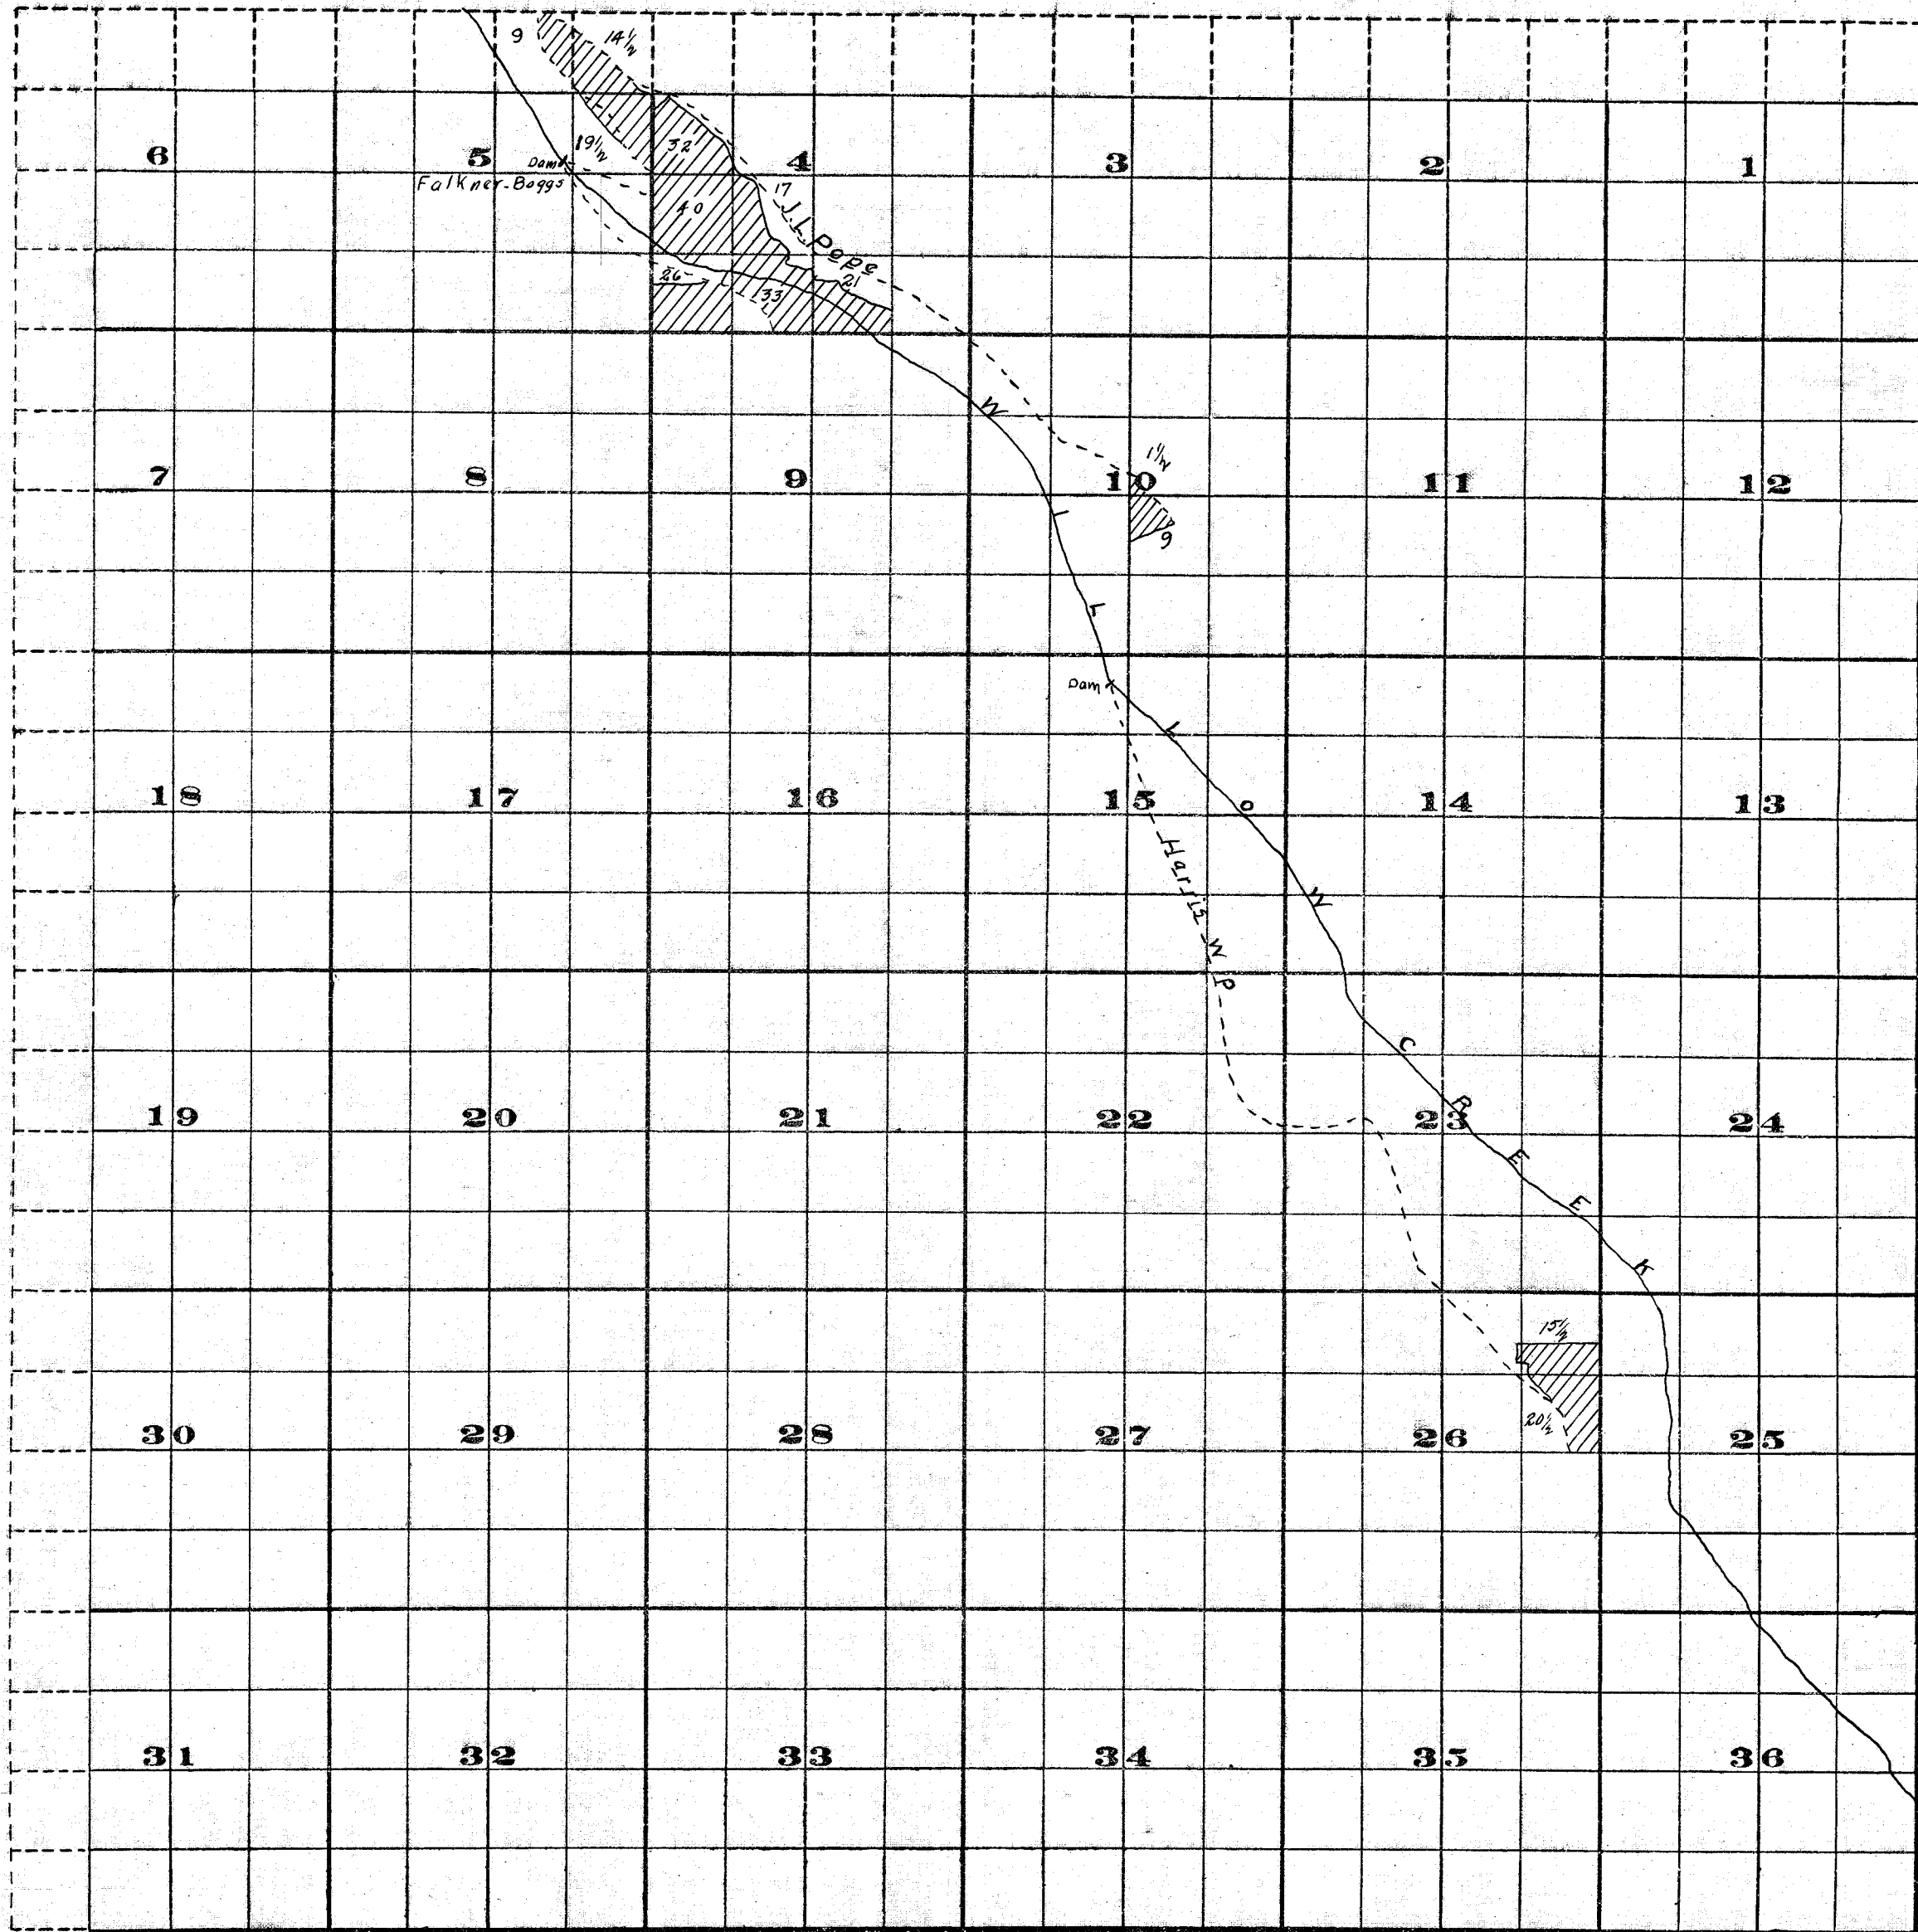

John H. Lewis State Eng.  
 Examined Aug 24, 1910

FROM OFFICE OF THE STATE ENGINEER, SALEM, OREGON  
 Survey By Rhea Luper Rhea Luper  
 Nov. 1909

Adjudication - Willow Creek - Malheur Co,

3d - 241.5 ac.  
 7 1/2 mi.