35–5–8

Township 1 N. , Range 23 E.W.M.

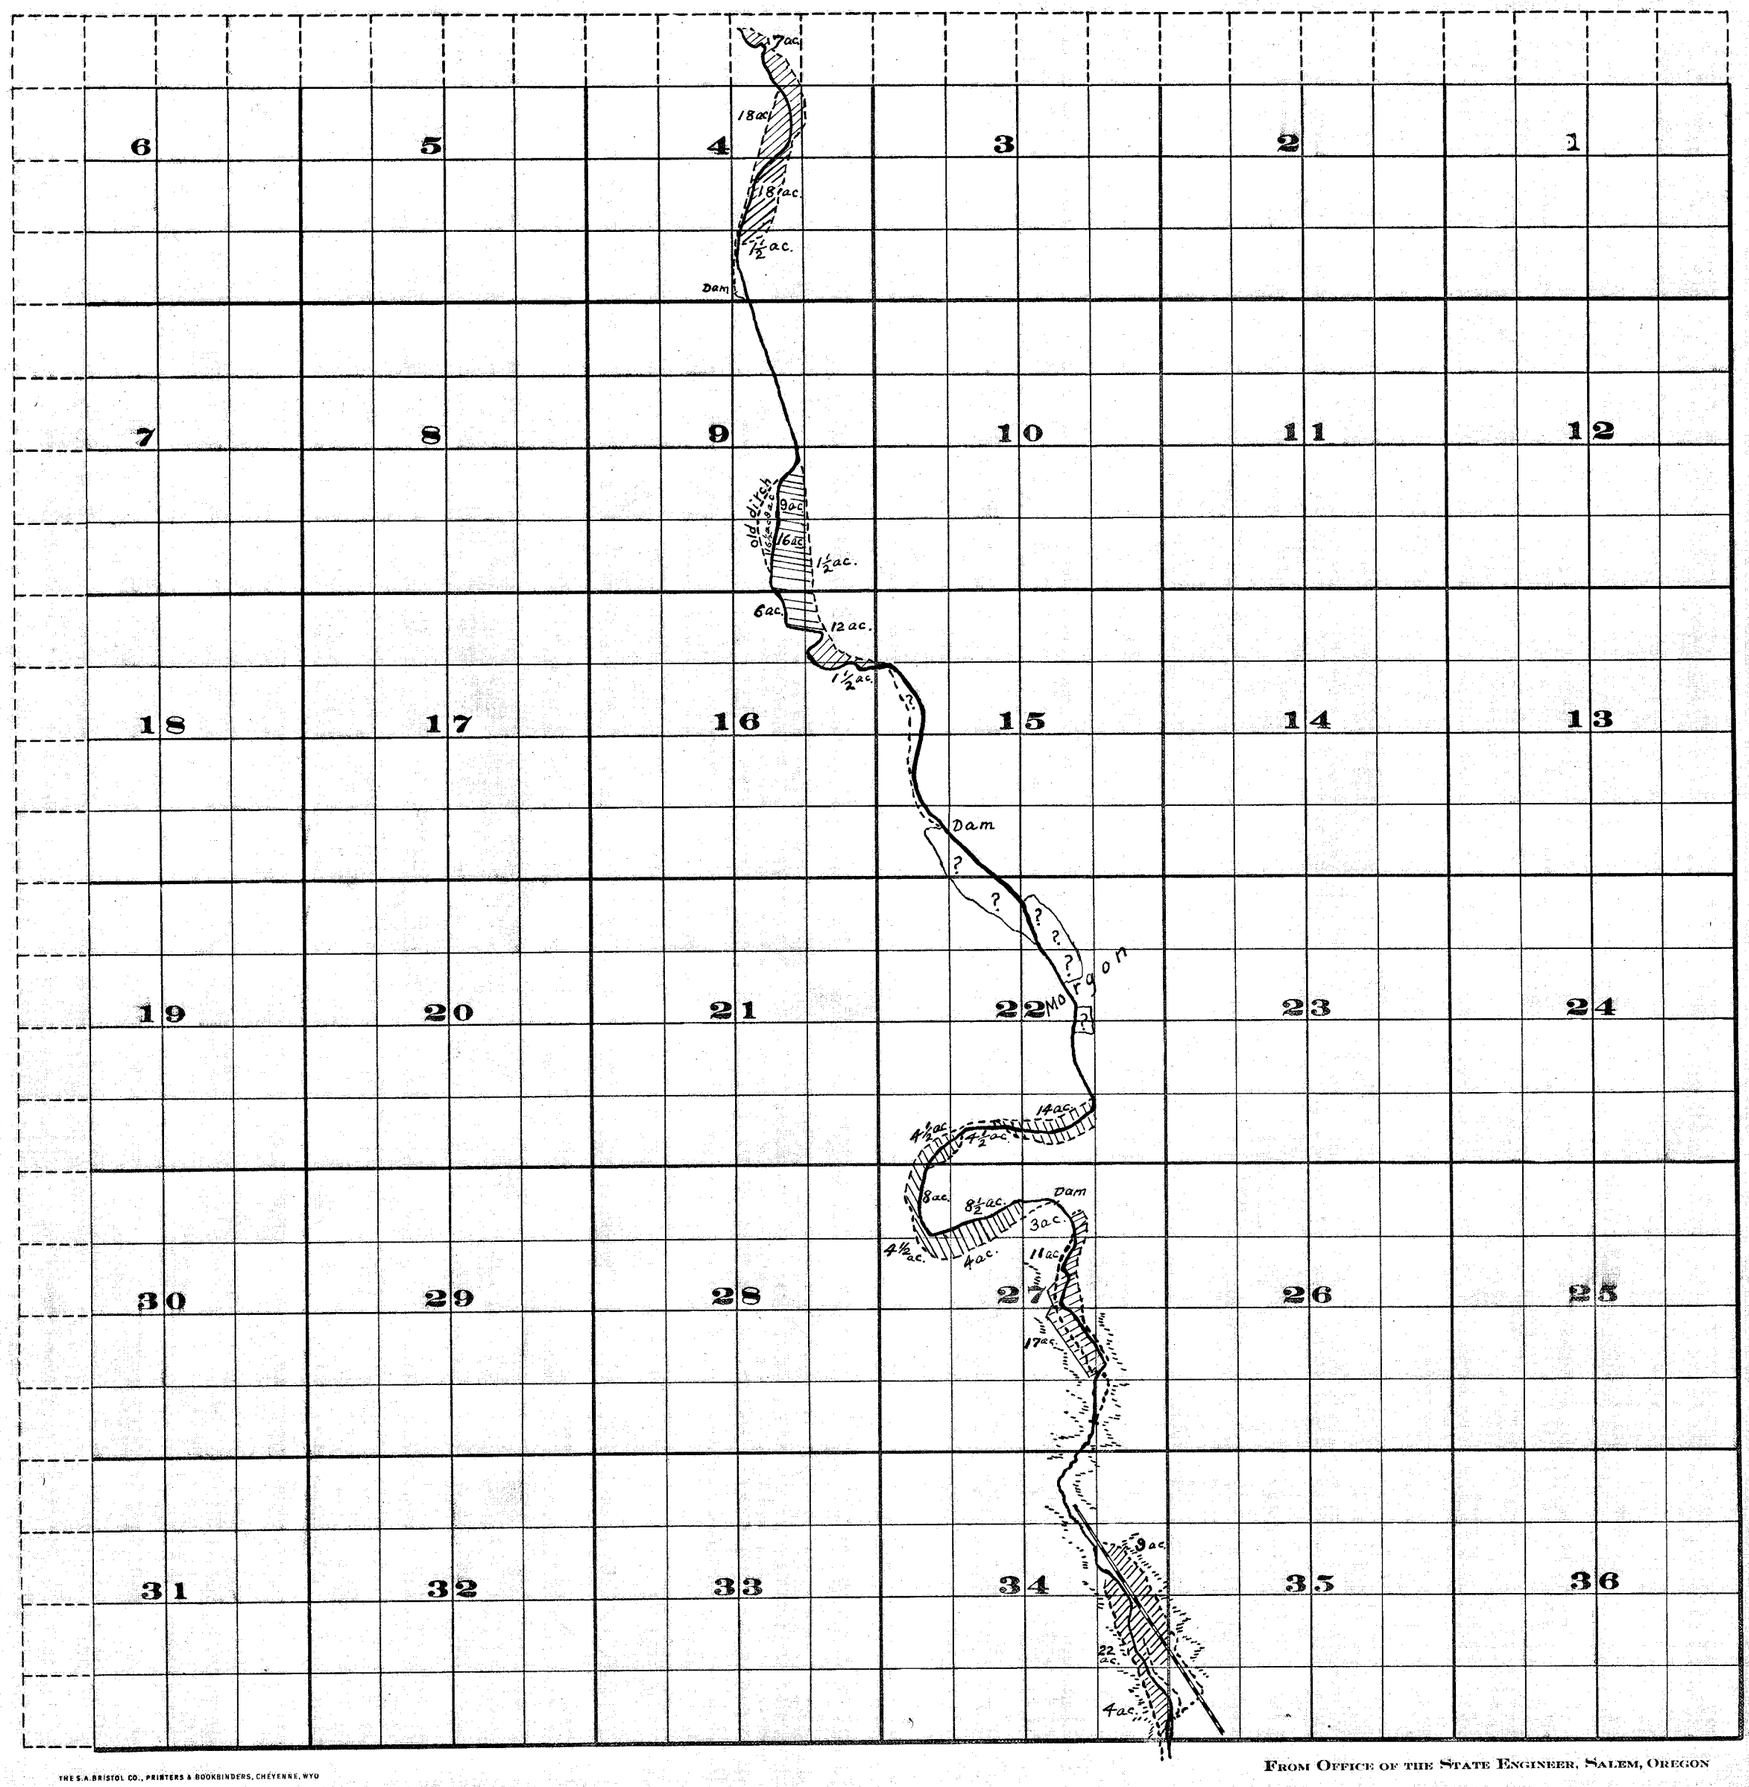

THE S.A. BRISTOL CO., PRINTERS & BOOKBINDERS, CHEYENNE, WYO

FROM OFFICE OF THE STATE ENGINEER, SALEM, OREGON

Surveyed by H. K. Donnelly July 1909, S. 27 North

Surveyed by R. D. Cooper July 1909, S. 27 South

John H. Lewis - State Engineer

Examined July 14, 1909.

Willow Creek Adjudication

4

1 N. 23 E.