

WATER SUPPLY WELL REPORT - Map with location identified must be attached and shall include an approximate scale and north arrow

YAMH 57913

4/23/2018

RECEIVED

MAY 15 2019

Map of Hole

OWRD

STATE OF OREGON
WELL LOCATION MAP

Oregon Water Resources Department

725 Summer St NE, Salem OR 97301
(503)986-0900



This map is supplemental to the WATER SUPPLY WELL REPORT

LOCATION OF WELL

Latitude: 45.2883891063 Datum: WGS84

Longitude: -123.10557648089

Township/Range/Section/Quarter-Quarter Section:

WM 3S 3W 19 SESW

Address of Well:


10501 NE ABBEY RD. CARLTON, CARLTON, OR 97111

Well Label: 127722

Printed: April 23, 2018

DISCLAIMER: This map is intended to represent the approximate location the well. It is not intended to be construed as survey accurate in any manner.

Provided by well constructor

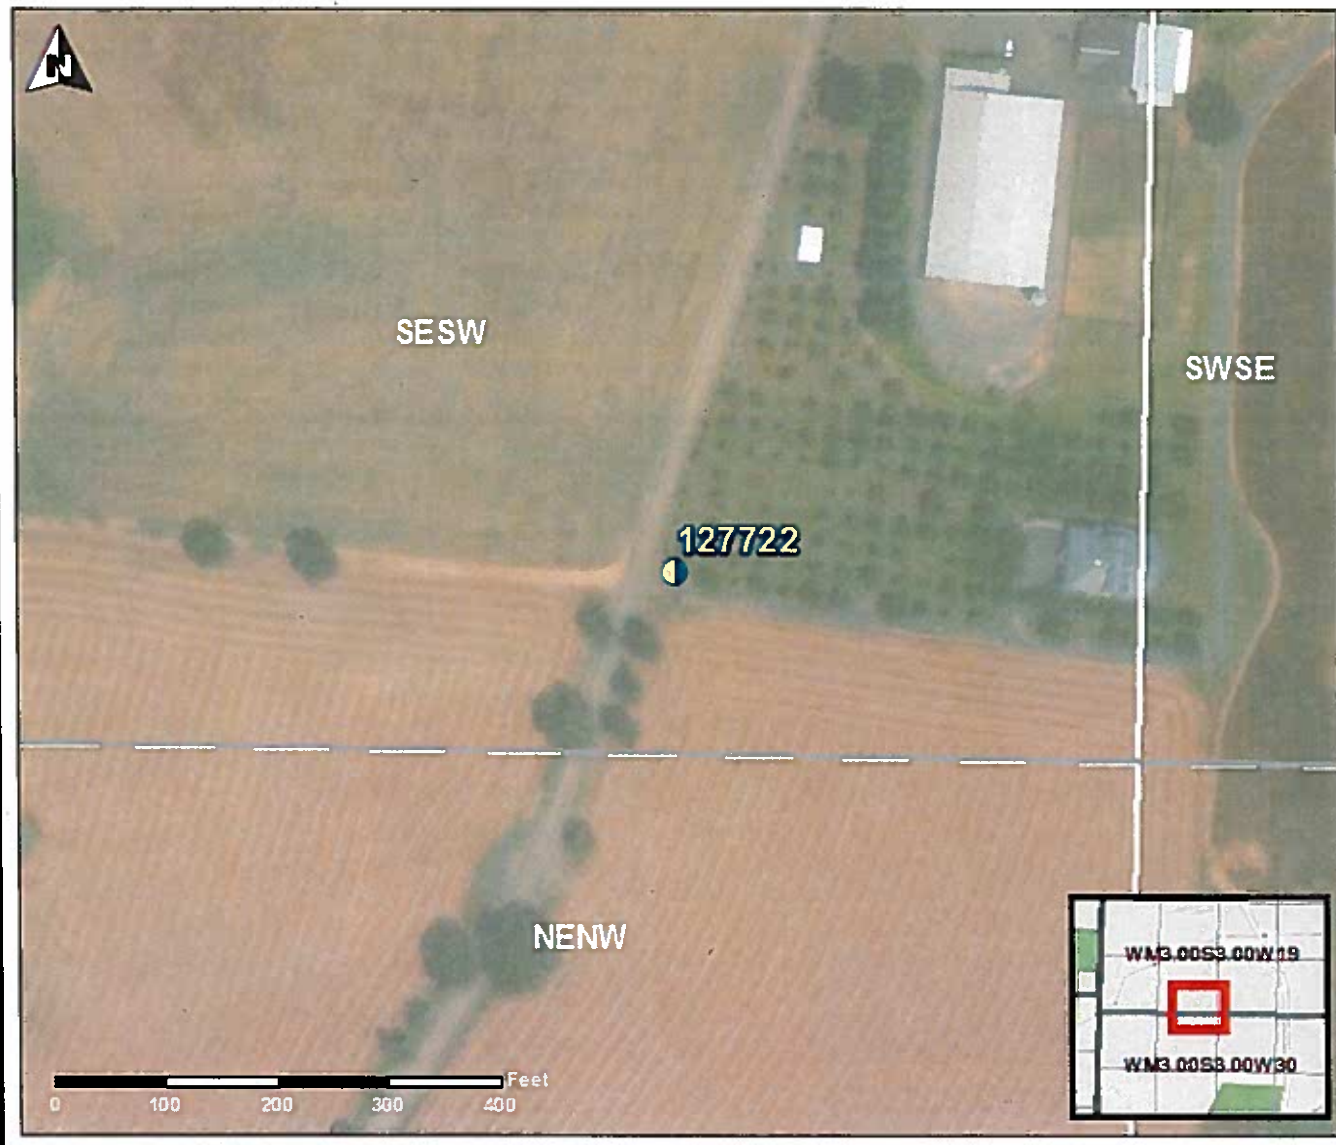

LL-1783

WATER SUPPLY WELL REPORT - Map with location identified must be attached and shall include an approximate scale and north arrow

YAMH 57912

4/23/2018

RECEIVED

MAY 15 2019

Map of Hole

OWRD

STATE OF OREGON
WELL LOCATION MAP

This map is supplemental to the WATER SUPPLY WELL REPORT

Oregon Water Resources Department

725 Summer St NE, Salem OR 97301
(503)988-0900



LOCATION OF WELL

Latitude: 45.2892646852 Datum: WGS84

Longitude: -123.10517280844

Township/Range/Section/Quarter-Quarter Section:

WM 3S 3W 19 SESW

Address of Well:

10501 NE ABBEY RD. CARLTON

Well Label: 127721

Printed: April 21, 2018

DISCLAIMER: This map is intended to represent the approximate location the well. It is not intended to be construed as survey accurate in any manner.

Provided by well constructor



LL-1783