

3267

Application No. GR

Certificate No. GR 3039

Stream Index, Page No. 2-9421 ✓

FEEES PAID

Date	Amount	Receipt No.
7-31-58	\$15.00	19016

FEEES REFUNDED

Date	Amount	Check No.

Name Aage Gribskov

By

Address Junction City, Oregon

Date filed July 31, 1958 2:45 PM

Tentative priority 1945

Action suspended until

Well log filed

CONSTRUCTION

Date for completion

Extended to

Date for application of water

Extended to

PROSECUTION OF WORK

Form "B" filed


Form "C" filed

ASSIGNMENTS

Date	To Whom	Address	Volume	Page

REMARKS

A well irrigates 21.76 acres near Willamette River - Lane County

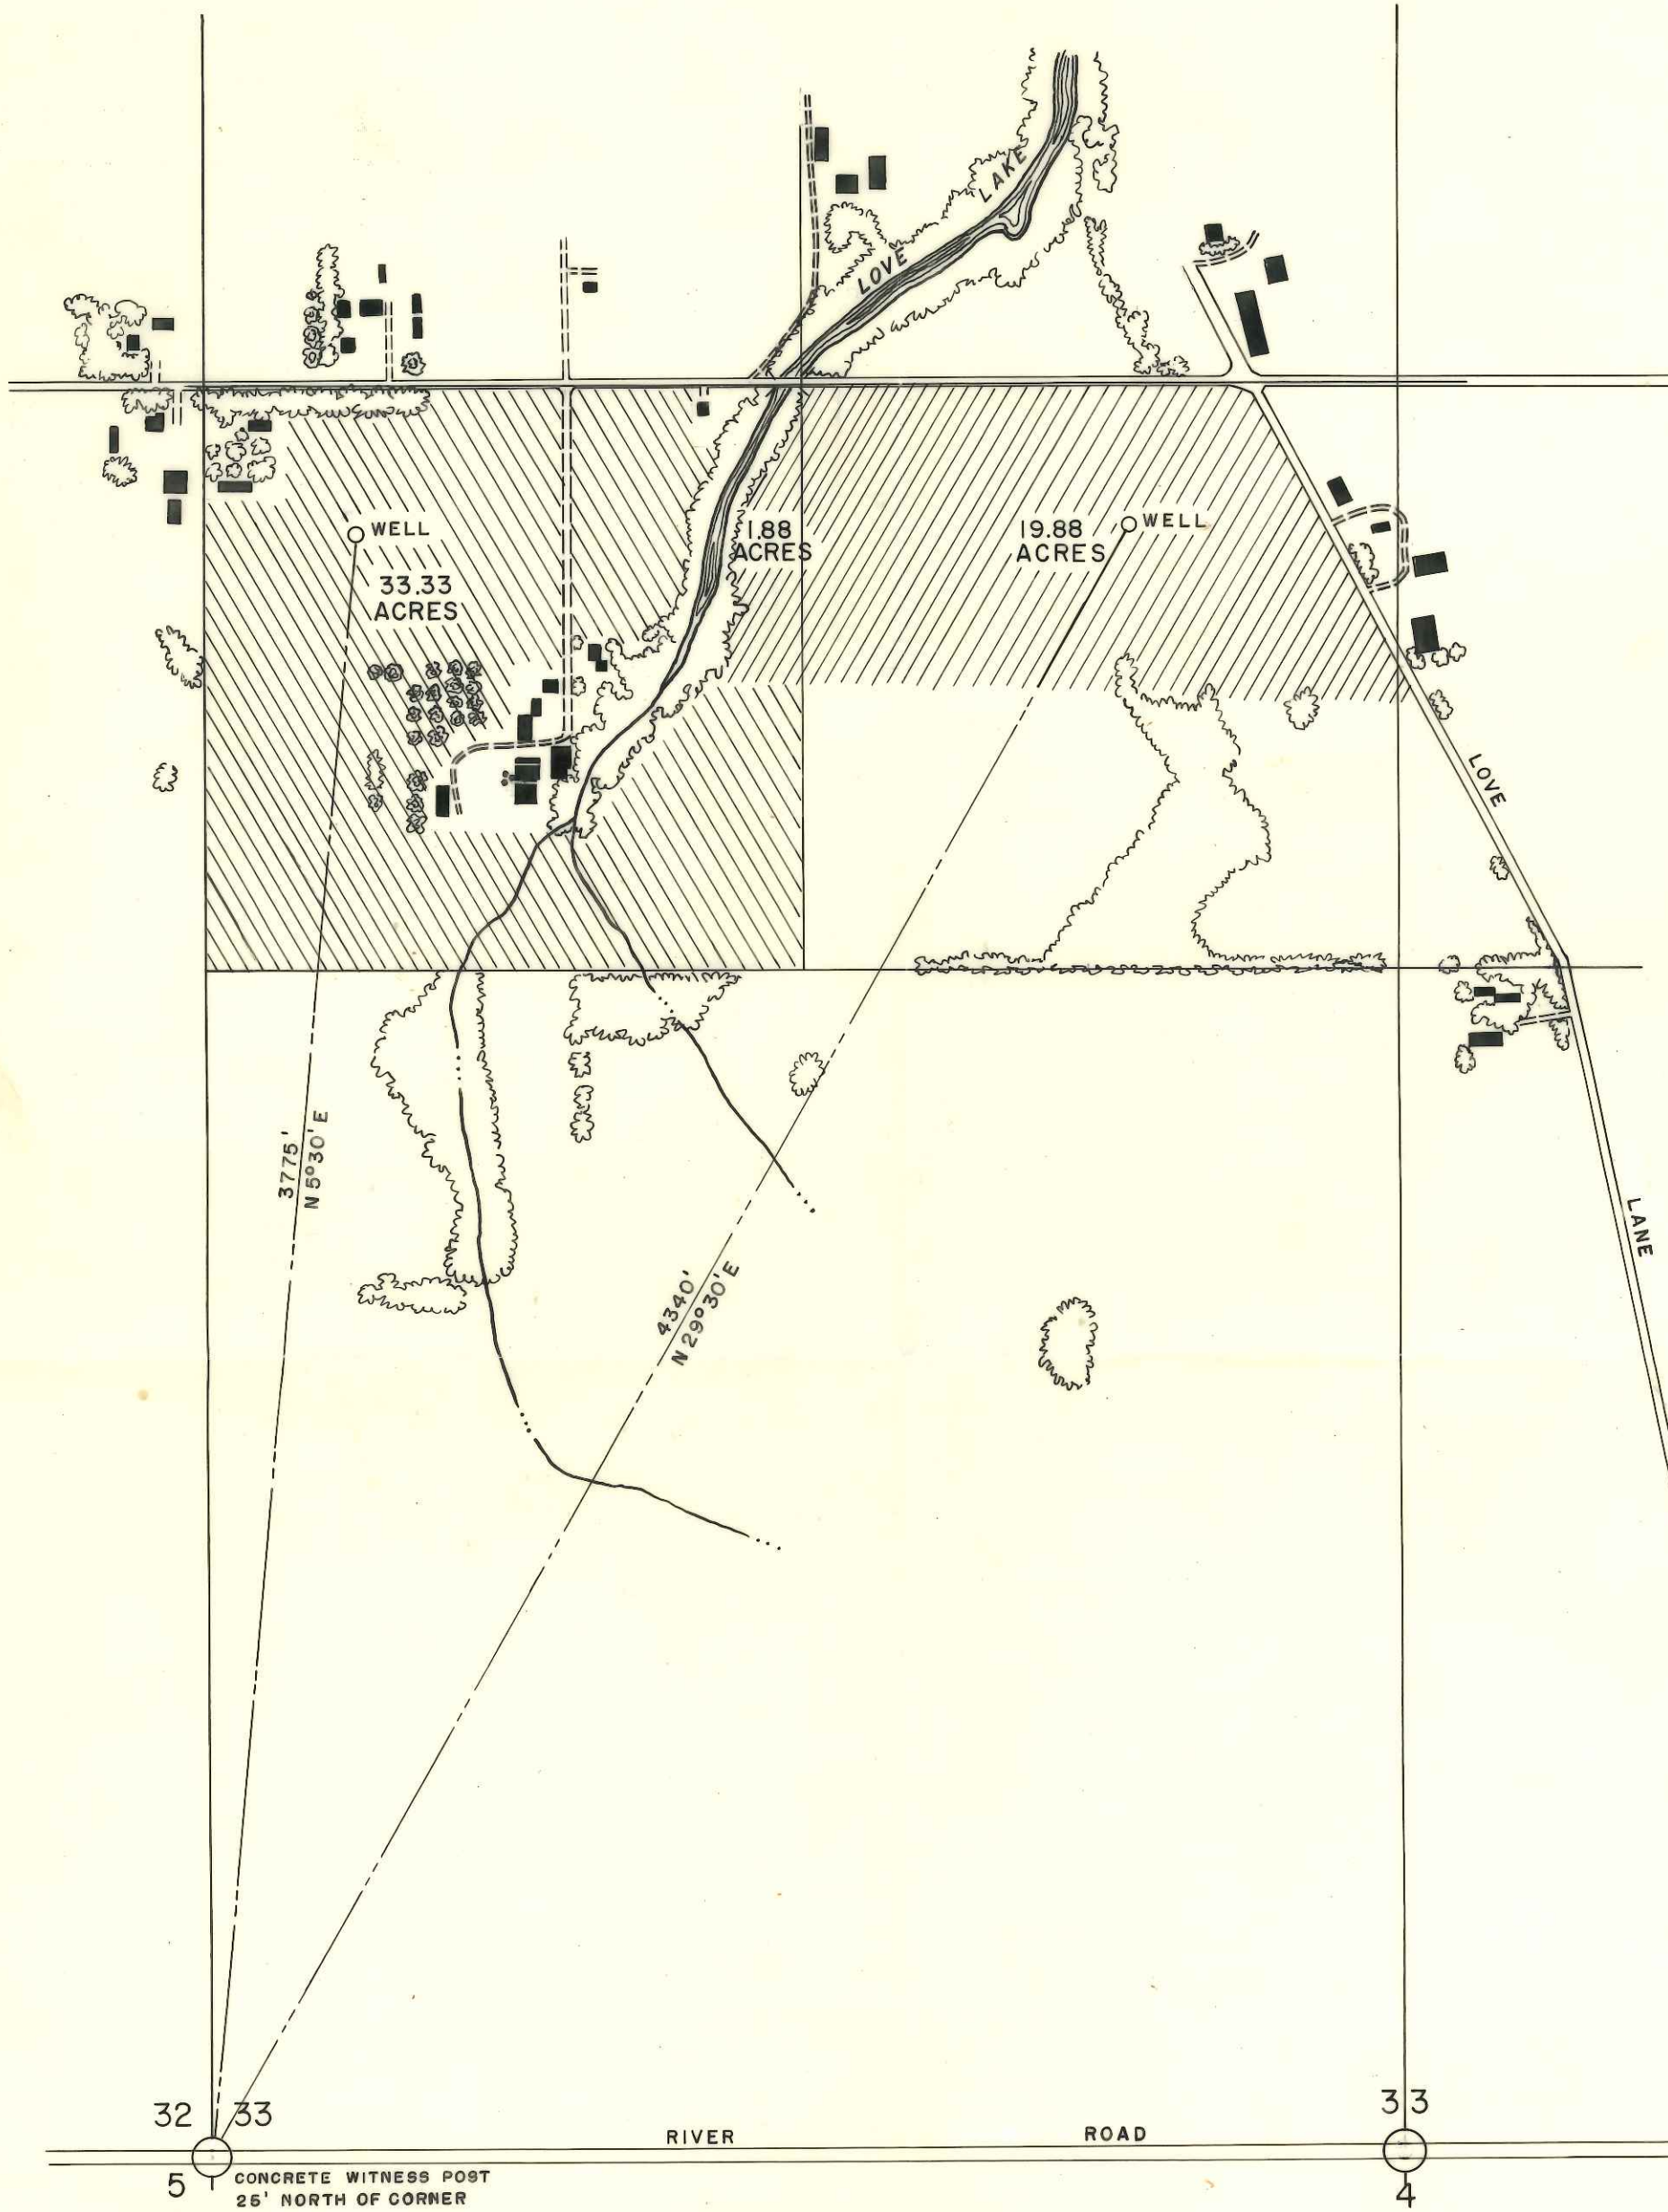

A290
NEIL GRIBSKOV PROPERTY
 SCALE 1" = 400

Prepared by the Office of H.G. Chickering Jr.
 Consulting Photogrammetrist Inc. Eugene,
 Oregon, from Vertical Aerial Photography
 Dated 1952. Map Compiled 3-5-58.



GR 3267

June 30, 1959

Aage Gribskov
Junction City
Oregon

Dear Mr. Gribskov:

GR 3267
GR 3039