


Township 1 N., Range 23 E.W.M.

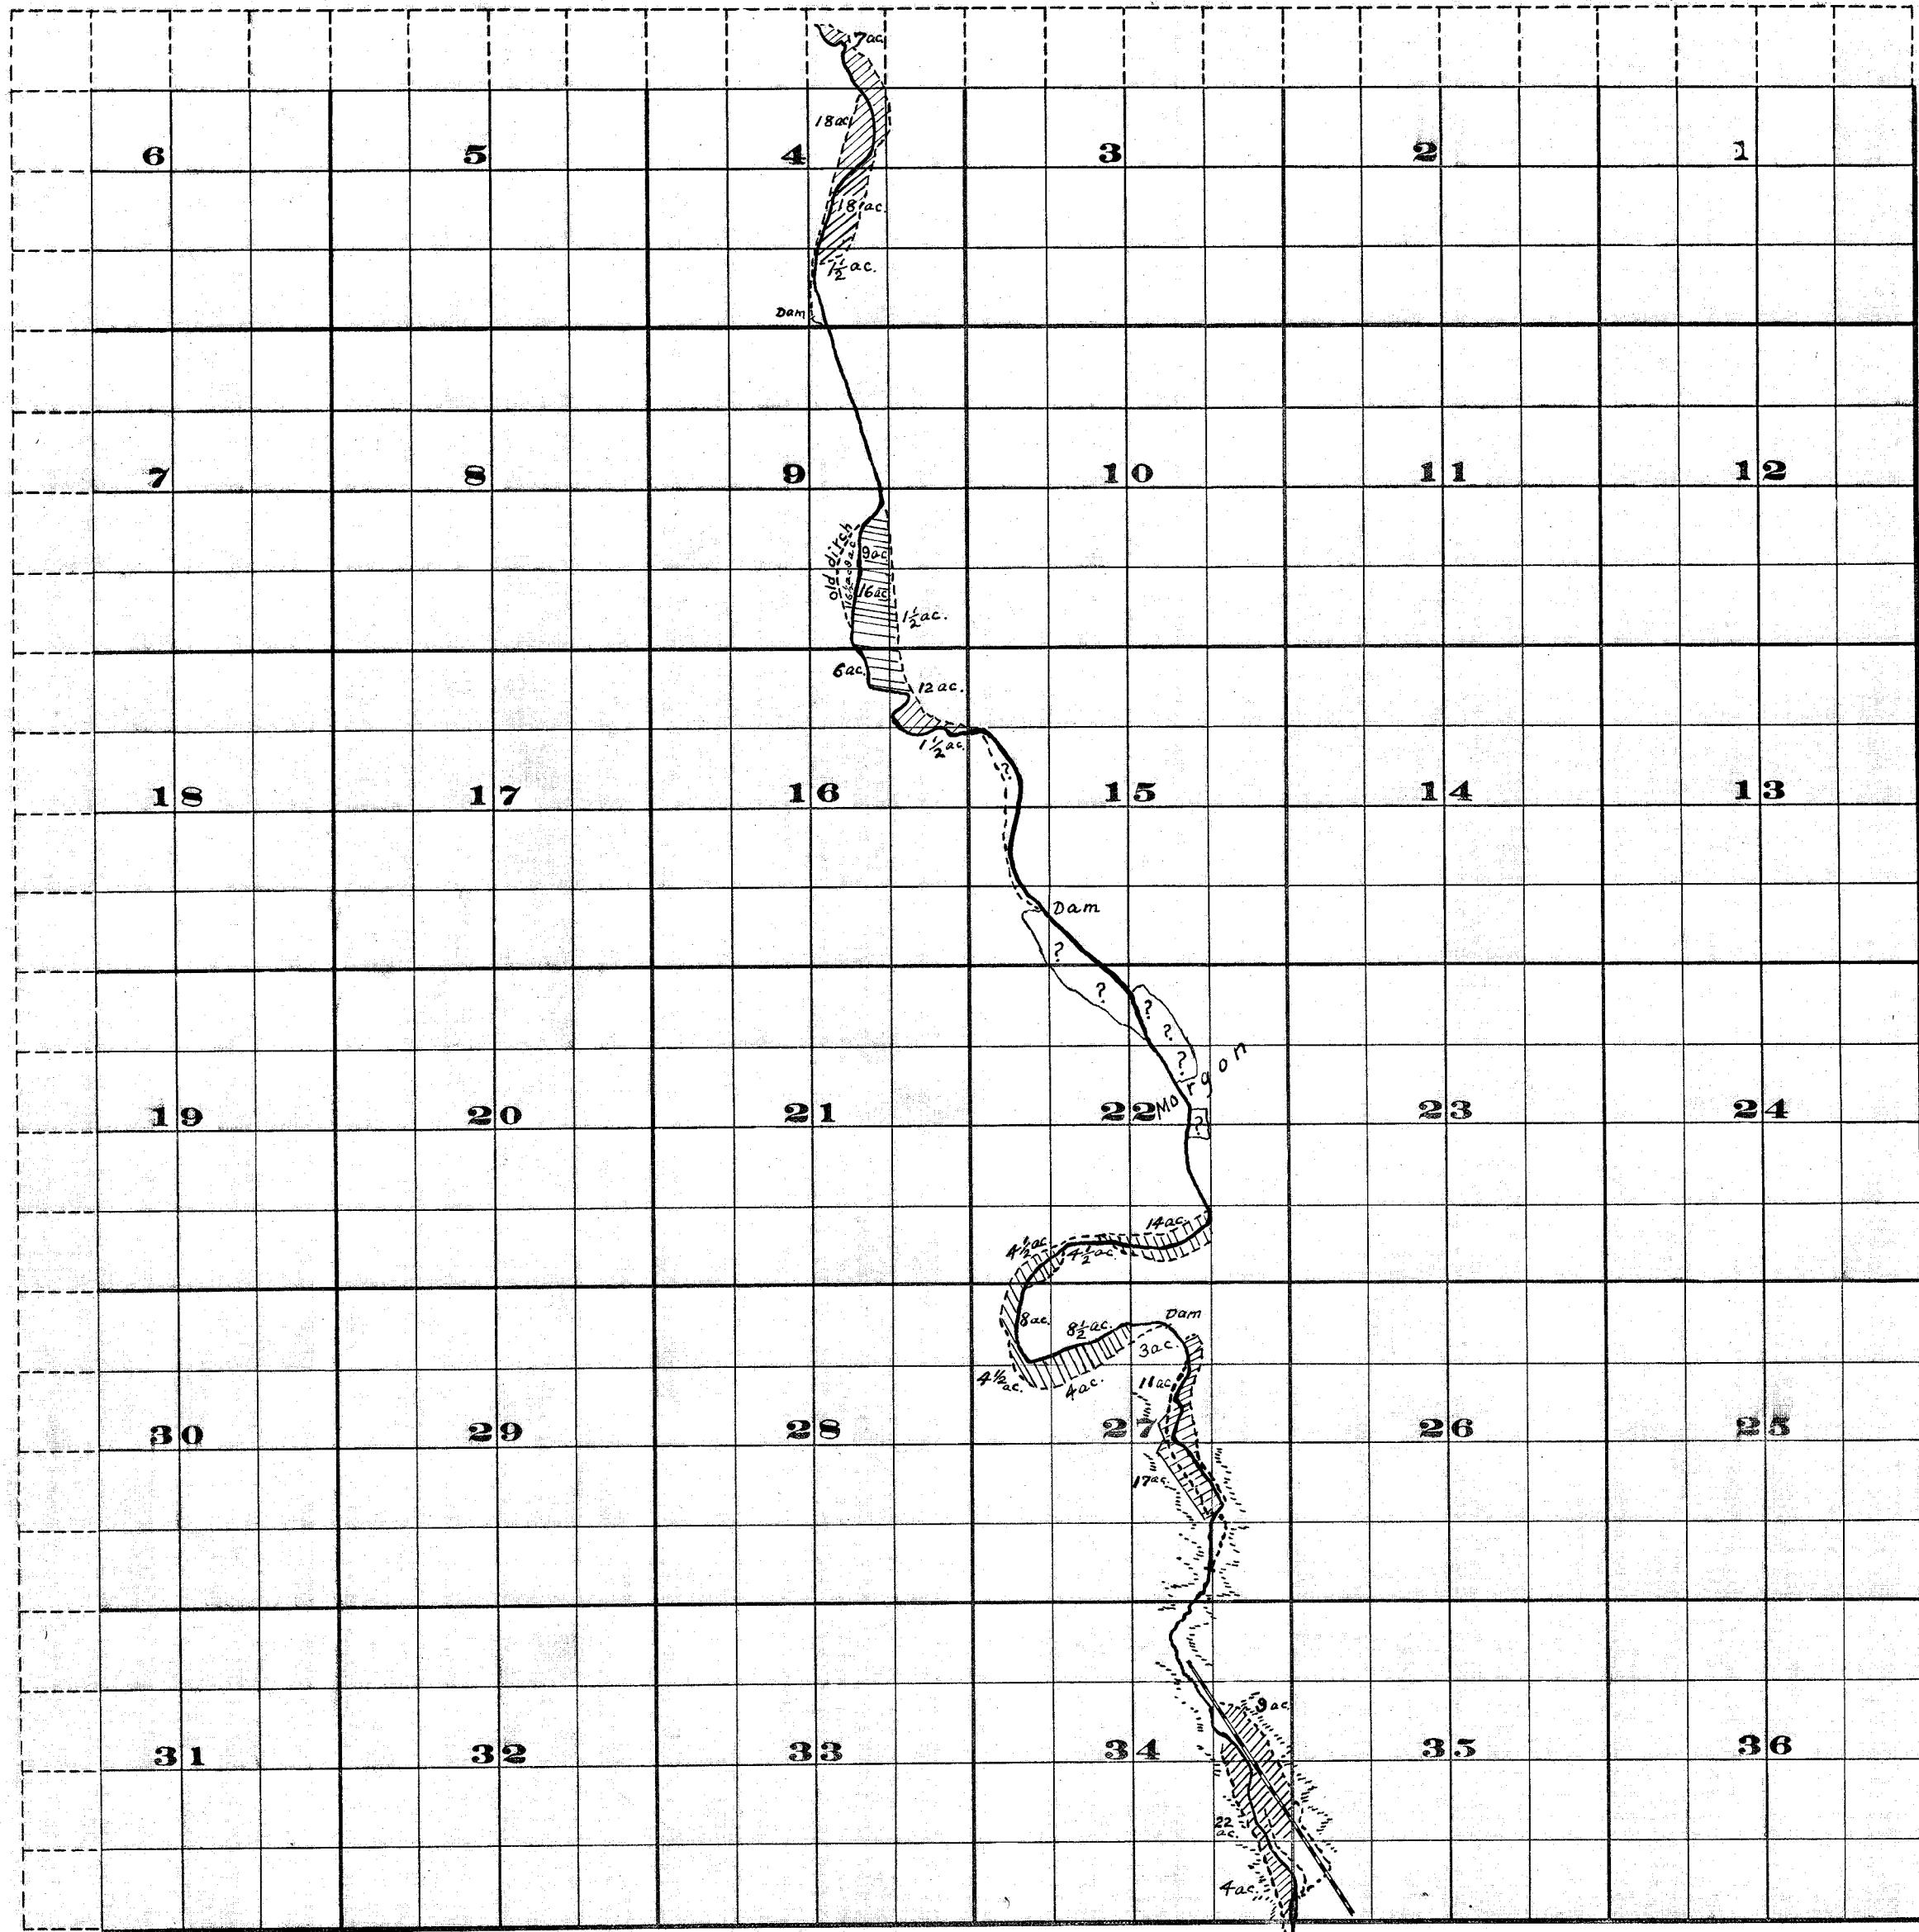

THE S.A. BRISTOL CO., PRINTERS & BOOKBINDERS, CHEYENNE, WYO

FROM OFFICE OF THE STATE ENGINEER, SALEM, OREGON

Surveyed by H.H. Donnelly July 1909, S. 27 North
Surveyed by R.D. Cooper July 1909, S. 27 South

Willow Creek Adjudication

John H. Lewis - State Engineer

Examined July 14, 1909.

A

1 N. 23 E.