


Township: 12S
Range: 3W
Section: 3

NWSW

well is
350 FT EAST
500 FT SOUTH
East Corner
1"=1320'

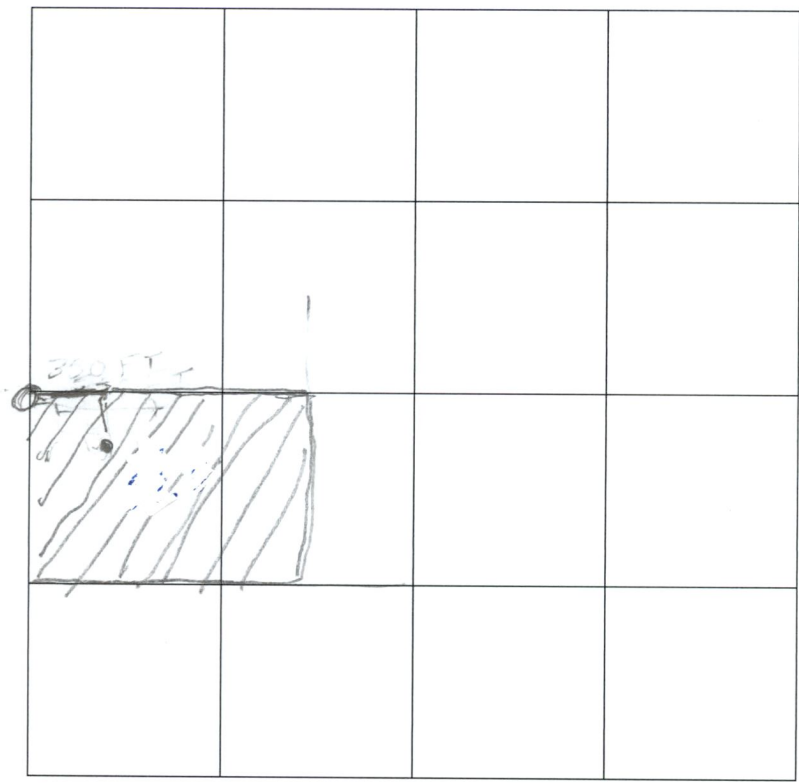

Applicant: Khao Saetern

Application #: _____ Permit #: _____

RECEIVED

MAY 21 2019

OWRD

G-18827