


S.E. 1/4 SEC. 4 T. 8S. R. 4W. WM.

Township 8 S  
Range 4 W  
Section 4 D  
1/4 1/4 SWSE  
Tax Lot 1900

4.75 acres on tax lot  
1900  
in 1/4 1/4 SWSE

Two wells as marked with \*

Well #1 1,900' west of SE corner of section 4 and 200' North of SE corner of Section 4  
Well #2 1,860' west of SE corner of Section 4 and 110' North of SE corner of Section 4.

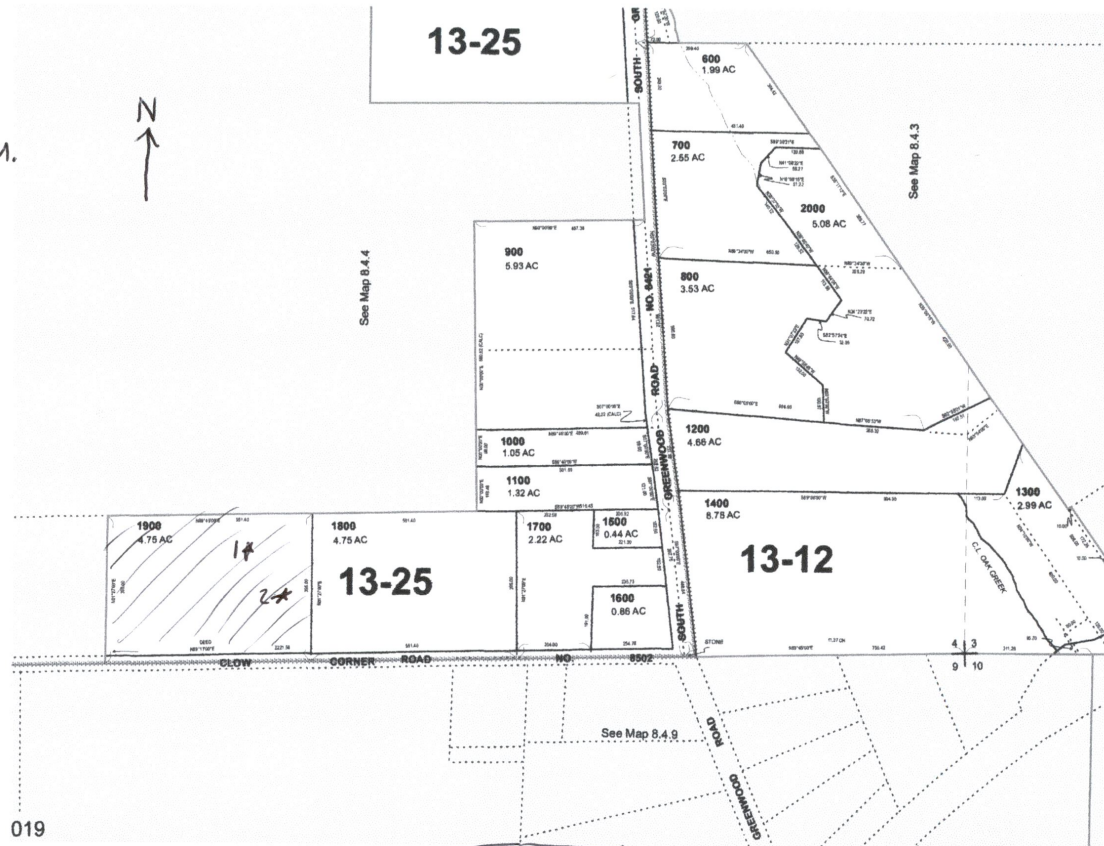

RECEIVED  
MAY 31 2019  
OWRD

G-18826