

IWR Application # 71468 Certificate # _____

STATE OF OREGON

WATER RESOURCES DEPARTMENT

RECEIVED

MAR 28 1991

**Application for Instream Water Right
by Oregon Department of Fish and Wildlife**

WATER RESOURCES DEPARTMENT
SALEM, OREGON

There is no fee required for this application.

Applicant: Randy Fisher for Oregon Department of Fish and Wildlife, PO Box 59, Portland, OR 97207

1. The name of the stream of the proposed instream water right is Bear Creek, a tributary of Silvies River.
2. The public use this instream water right is based on is providing required stream flows for redband and brook trout.
3. The amount of water (in cubic feet per second) needed by month for each category of public use is as follows:

USE(S): Migration, spawning, egg incubation, fry emergence, and juvenile rearing.

JAN	FEB	MAR	APR	MAY	JUN	JUL	AUG	SEP	OCT	NOV	DEC
6	6/9	12	12	12	12/9	6	6	6	6	6	6

4. The reach of the stream identified for an instream water right is from (upstream end) the headwaters, river mile 27.7, within Section 11, Township 15S, Range 33E W.M., in Grant County...

Downstream to Antelope Creek, river mile 7.4, within the SW quarter of the NE quarter of Section 28, Township 16S, Range 32E W.M., in Grant County.

5. The method used to determine the requested amounts was the Oregon Method.
6. When were the following state agencies notified of the intent to file for the instream water right?

Dept. of Environmental Quality	Date: March 8, 1991
ODFW (Fish, Wldlf, and Habitat)	Date: March 8, 1991
Parks and Recreation Division	Date: March 8, 1991

7. If possible, include recommendations for measuring locations or methods:

Establish a gaging structure at or near the lower limit of

IWR Application # 71468 Certificate # _____

the reach.

8. If possible, include recommendations for assisting the Water Resources Department (WRD) in measuring and monitoring procedures:

Local ODFW personnel will assist the watermaster in establishing a monitoring plan and program.

9. If possible, include other recommendations for methods or conditions necessary for managing the water right to protect the public uses [see OAR 690-77-020 (5)(c)]: None.
10. Remarks: Redband trout is listed as "sensitive" (candidate species for listing under the Threatened and Endangered Species Act if population declines from present level) by ODFW. Population maintenance and recovery depend on instream habitat the requested flows will provide.

An instream water right may be allowed for an instream beneficial use of water subject to existing water rights with an effective date prior to the filing date of this application.

This type of beneficial use is for the benefit of the public and a certificate issued confirming an instream water right shall be held in trust by the Water Resources Department for the people of the State of Oregon, pursuant to ORS 537.341.

Date: 3/25/91

Signed: Nancy M. MacHugh

Oregon Department of Fish and
Wildlife

Assistant Director
Habitat Conservation Div.

File: BEAR11.APP

RECEIVED

MAR 28 1991

WATER RESOURCES DE
SALEM, OREGON

IWR Application # 71468 Certificate # _____

This is to certify that I have examined the foregoing application, together with the accompanying maps and data, and return them for:

In order to retain its priority, this application must be returned to the Water Resources Department with corrections on or before

_____, 19____.

Date: _____, 19____.

This document was first received at the Water Resources Department in Salem, Oregon, on the 28th day of March, 1991, at 8:00 o'clock A.M.

Water Resources Department
3850 Portland Rd. NE
Salem, OR 97310


RECEIVED
MAR 28 1991
WATER RESOURCES DEPT
SALEM, OREGON

Y BASIN

GRA
HARNEY

28 GRANT CO. 29
HARNEY CO.

RECEIVED
MAR 28 1991
WATER RESOURCES DE
SALEM, OREGON

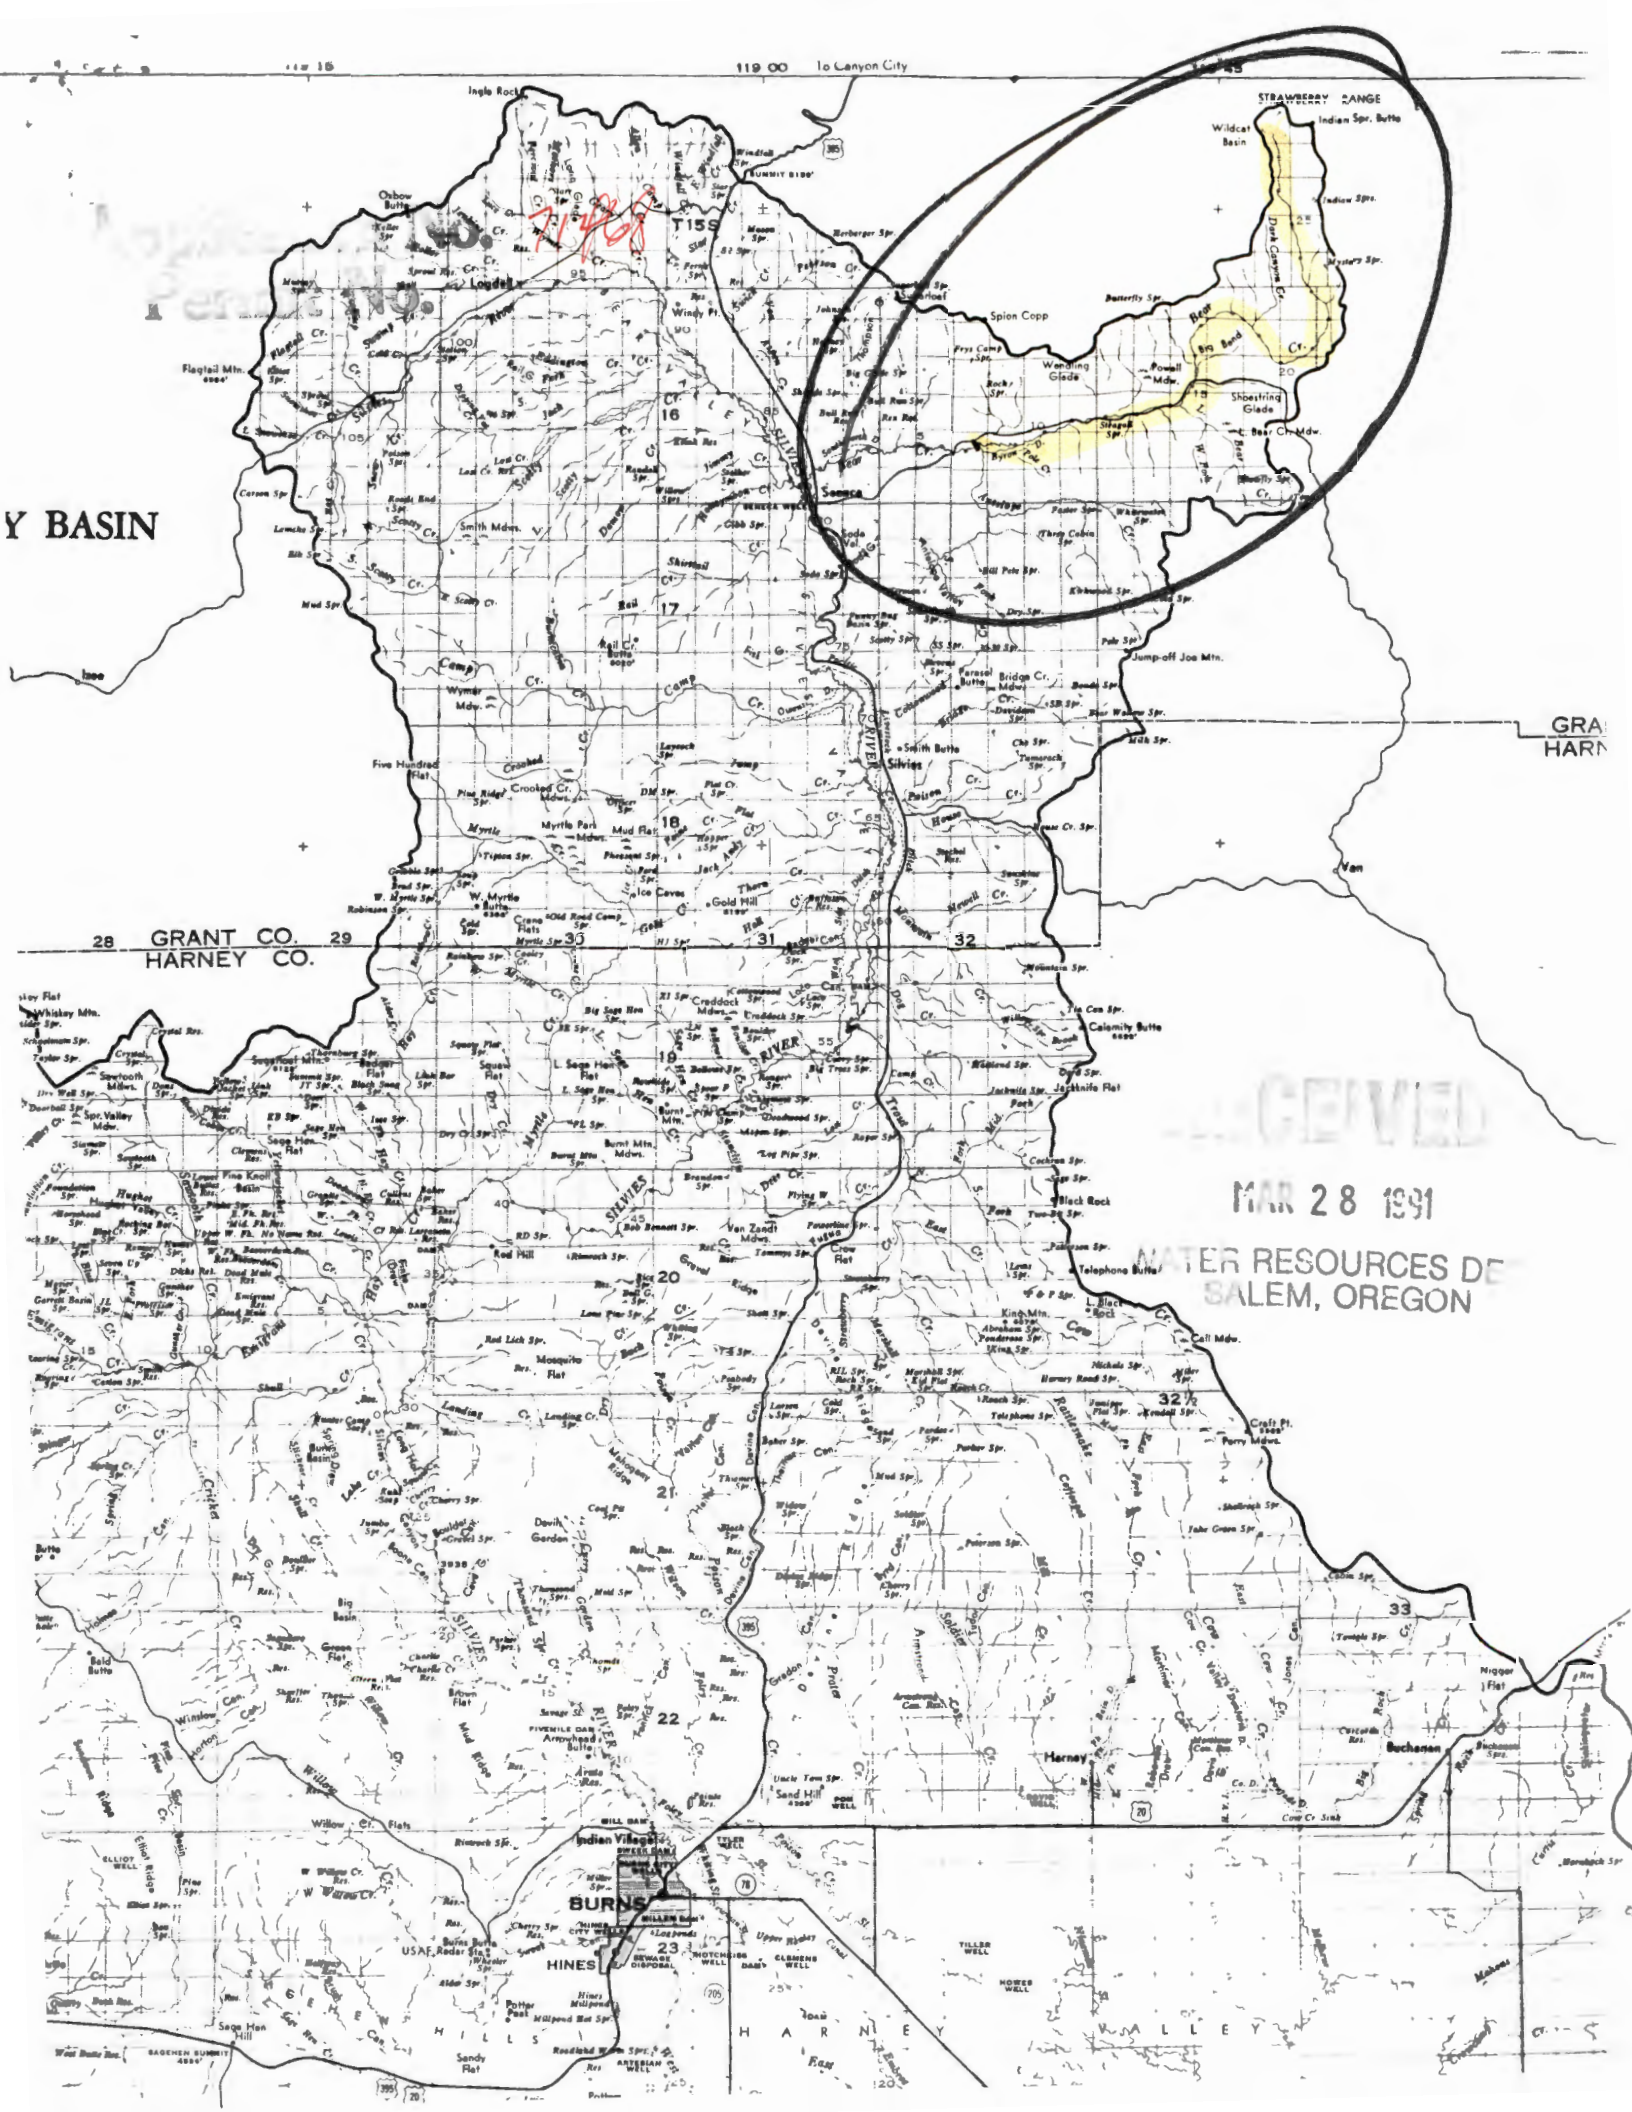

BURNS

HINES

Harney

Buchanan

Malheur