


SAFECO TITLE INS. CO.
 822 MAIN ST. 23
 PHONE: 656-1451
 OREGON CITY, OREGON
 97045

31E 22

PLEASE REFER TO ABOVE
 MAP NUMBER.

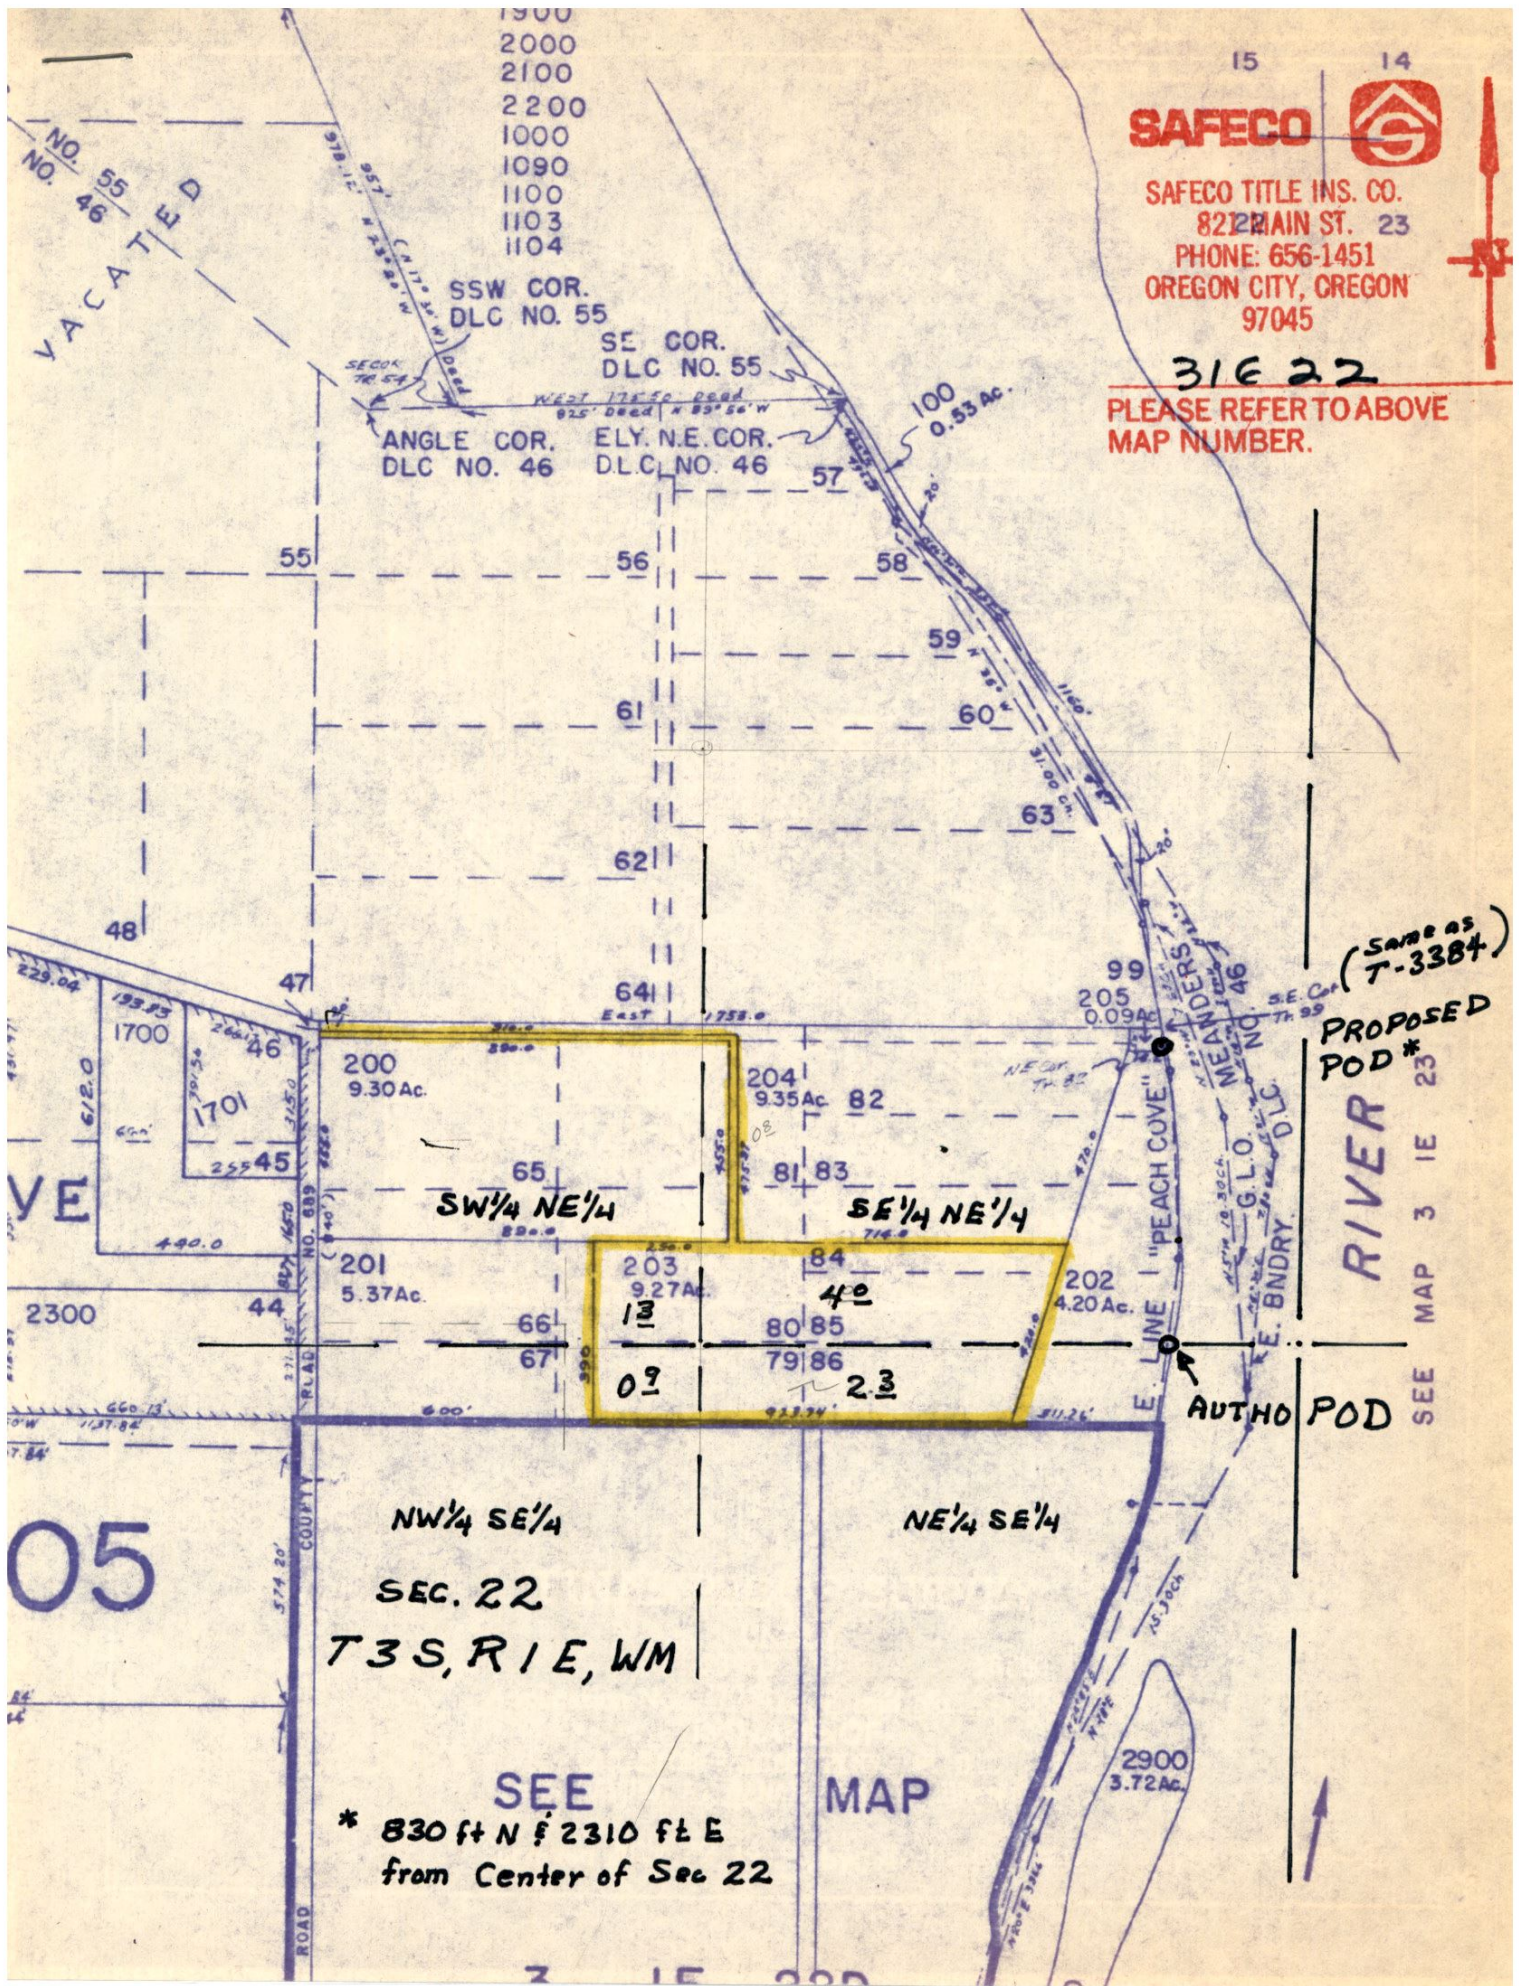

(Same as T-3384)

PROPOSED
 POD*

RIVER
 SEE MAP 3 1E 23

NW 1/4 SE 1/4
 SEC. 22
 T 3 S, R 1 E, WM

SEE MAP

* 830 ft N & 2310 ft E
 from Center of Sec 22