


# OWYHEE IRRIGATION DISTRICT

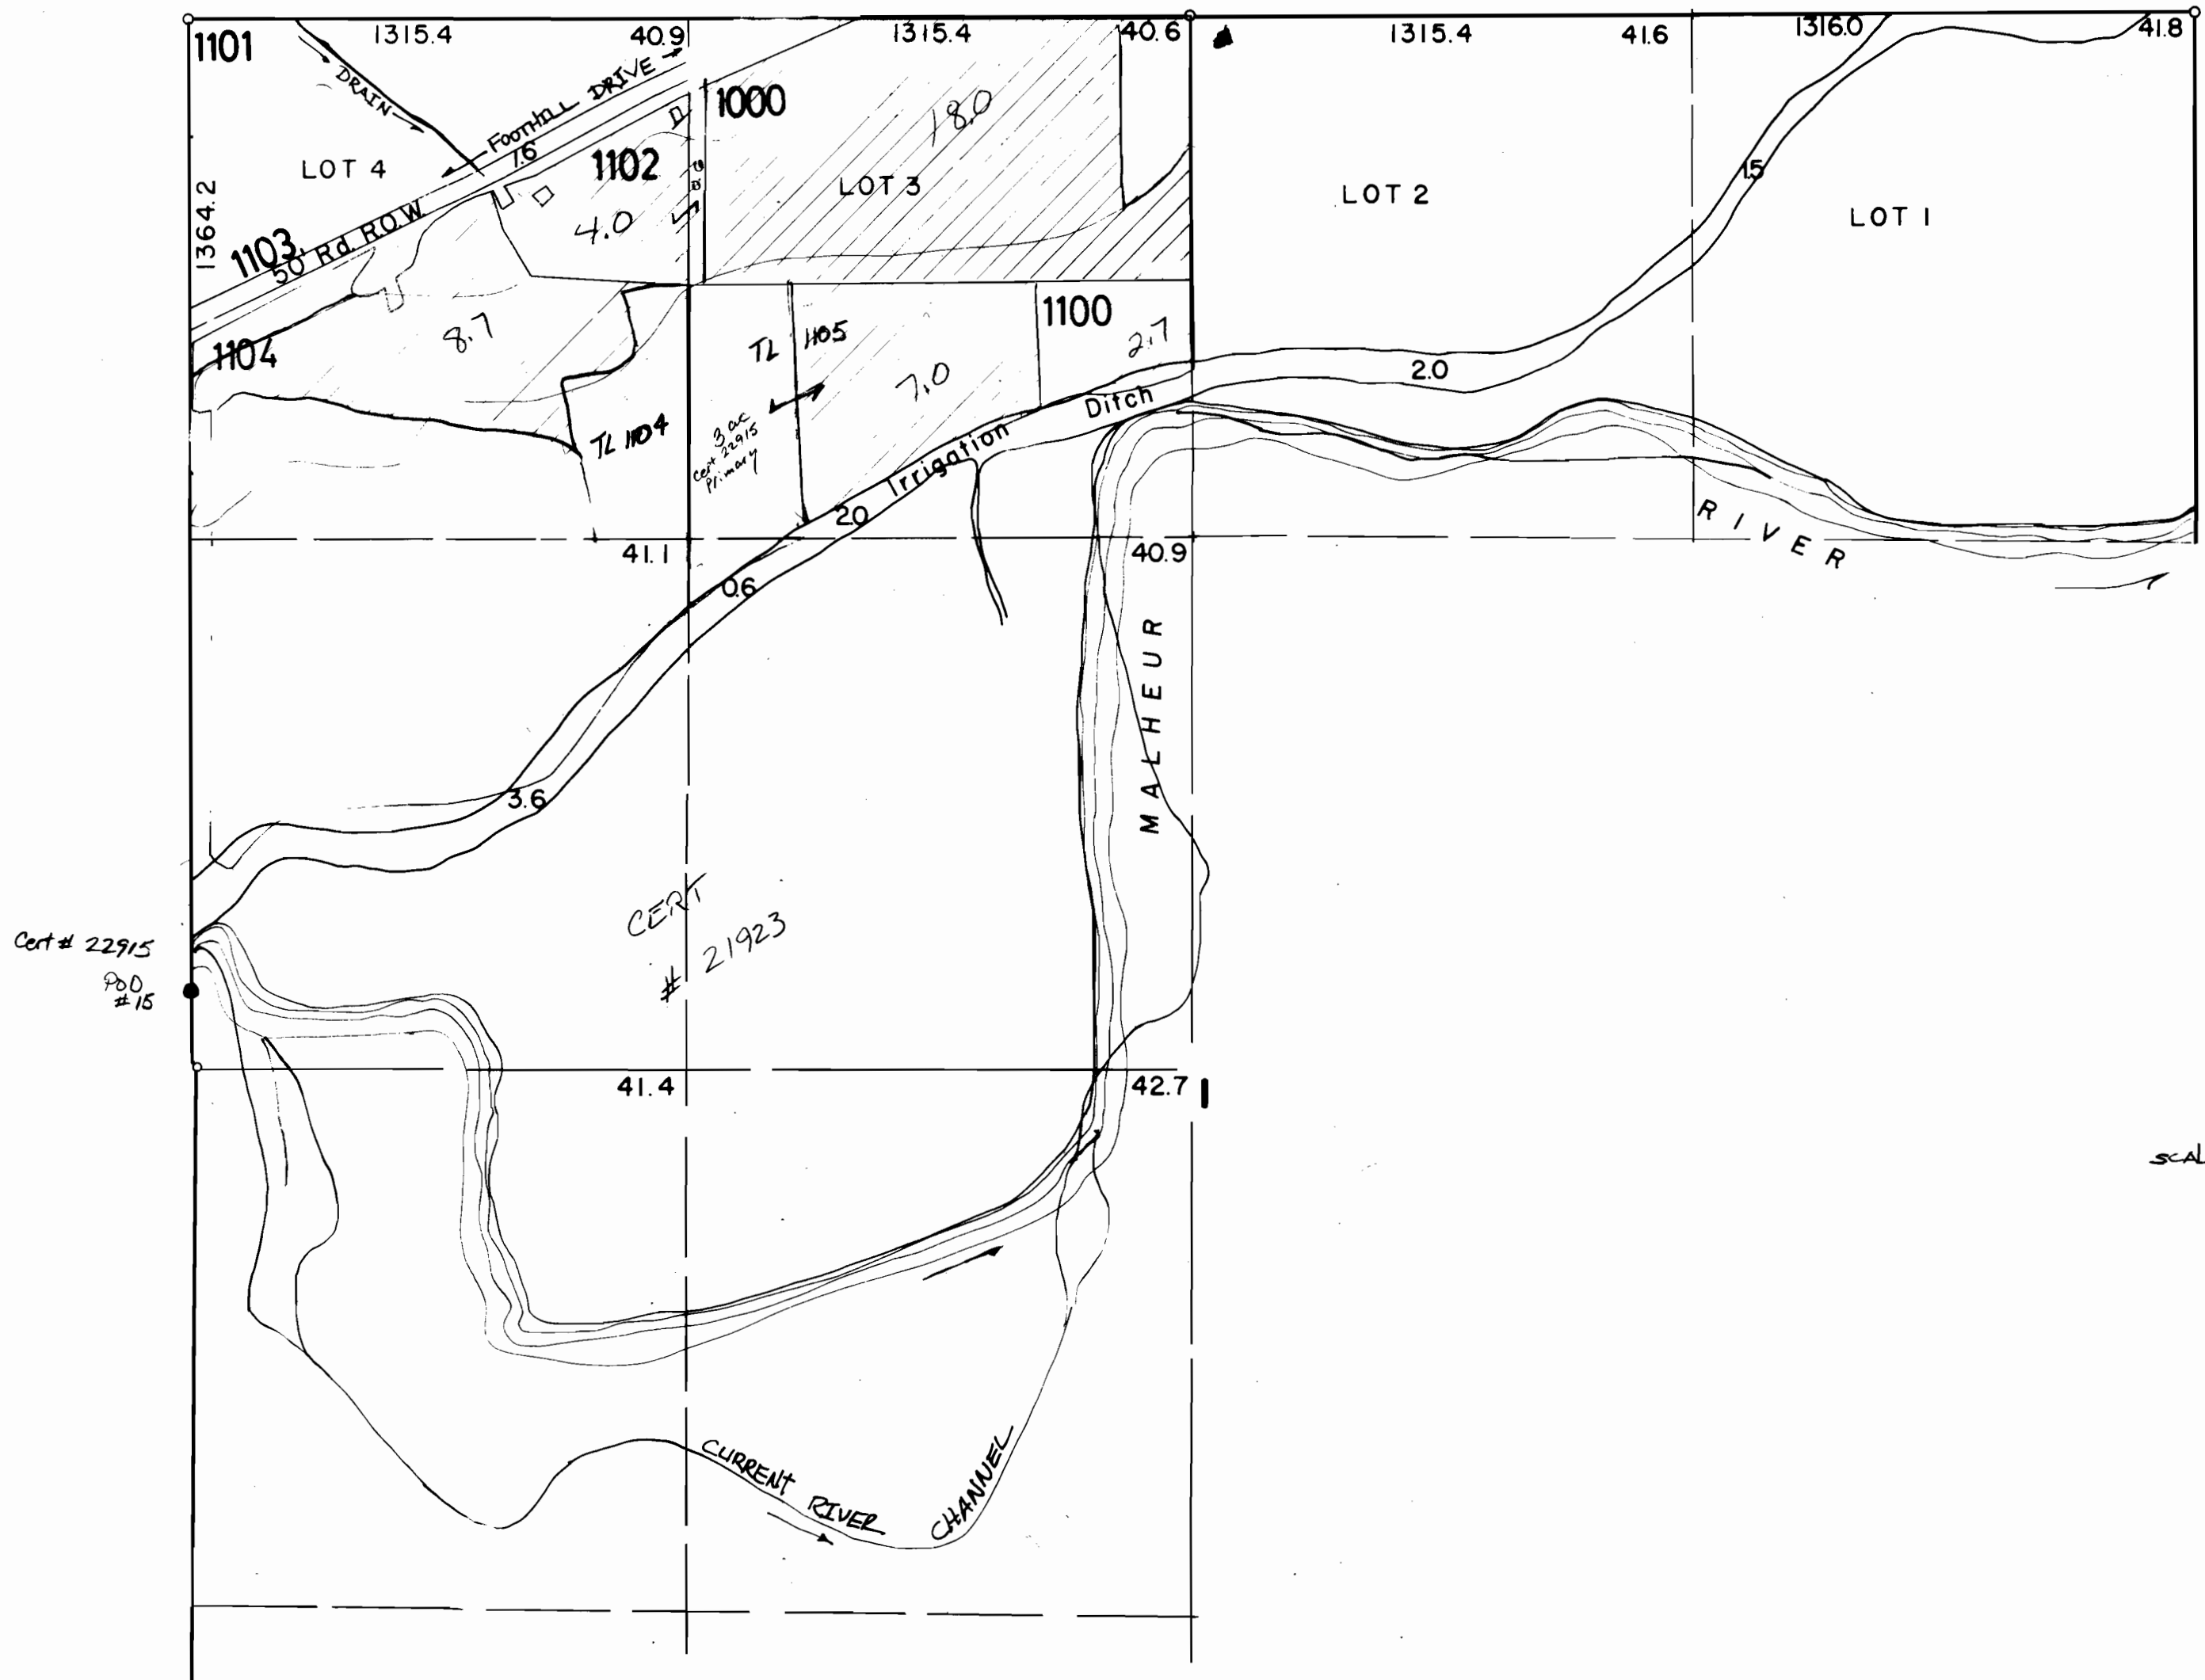

↑  
N  
SCALE: 1" = 400'  
▨ - Permit # 8111

SEC. 1 - T. 18 S. - R. 46 E. - W. M. 48-102-1415