OWYHEE IRRIGATION DISTRICT

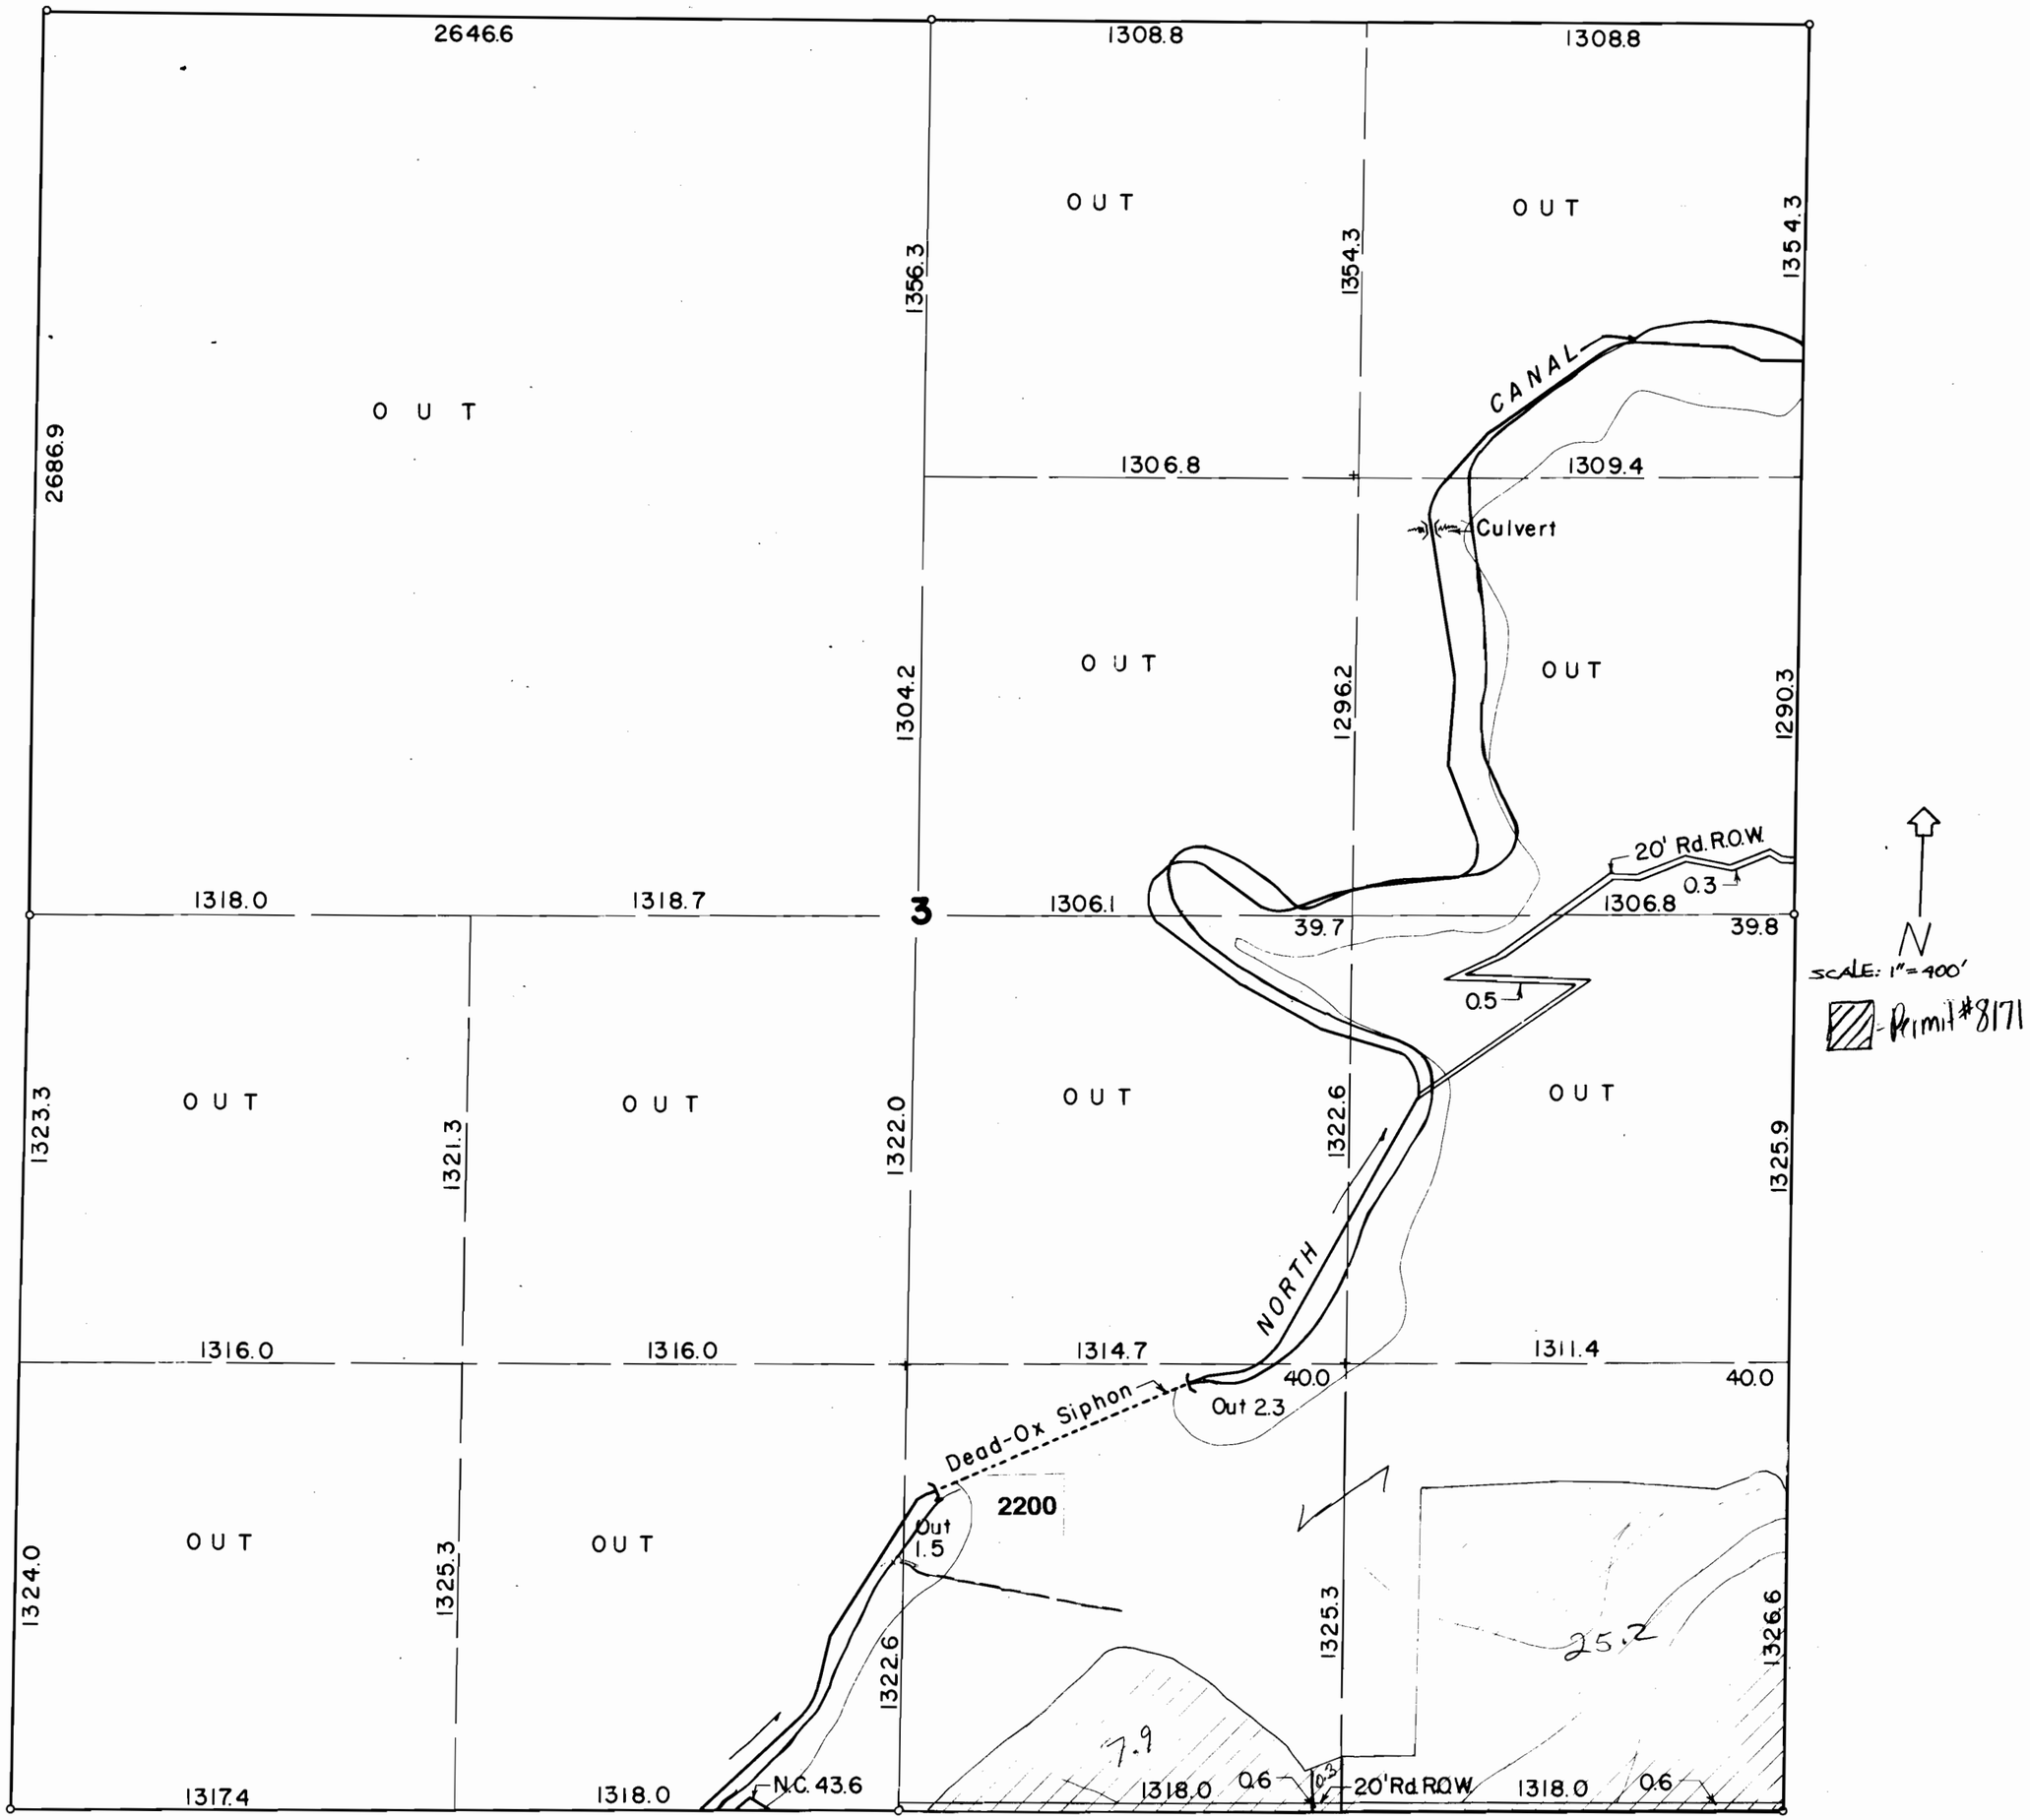

SEC. 3 - T.18 S. - R.46 E. - W.M. 48-102-1417

[redacted]

REVISED 12-96