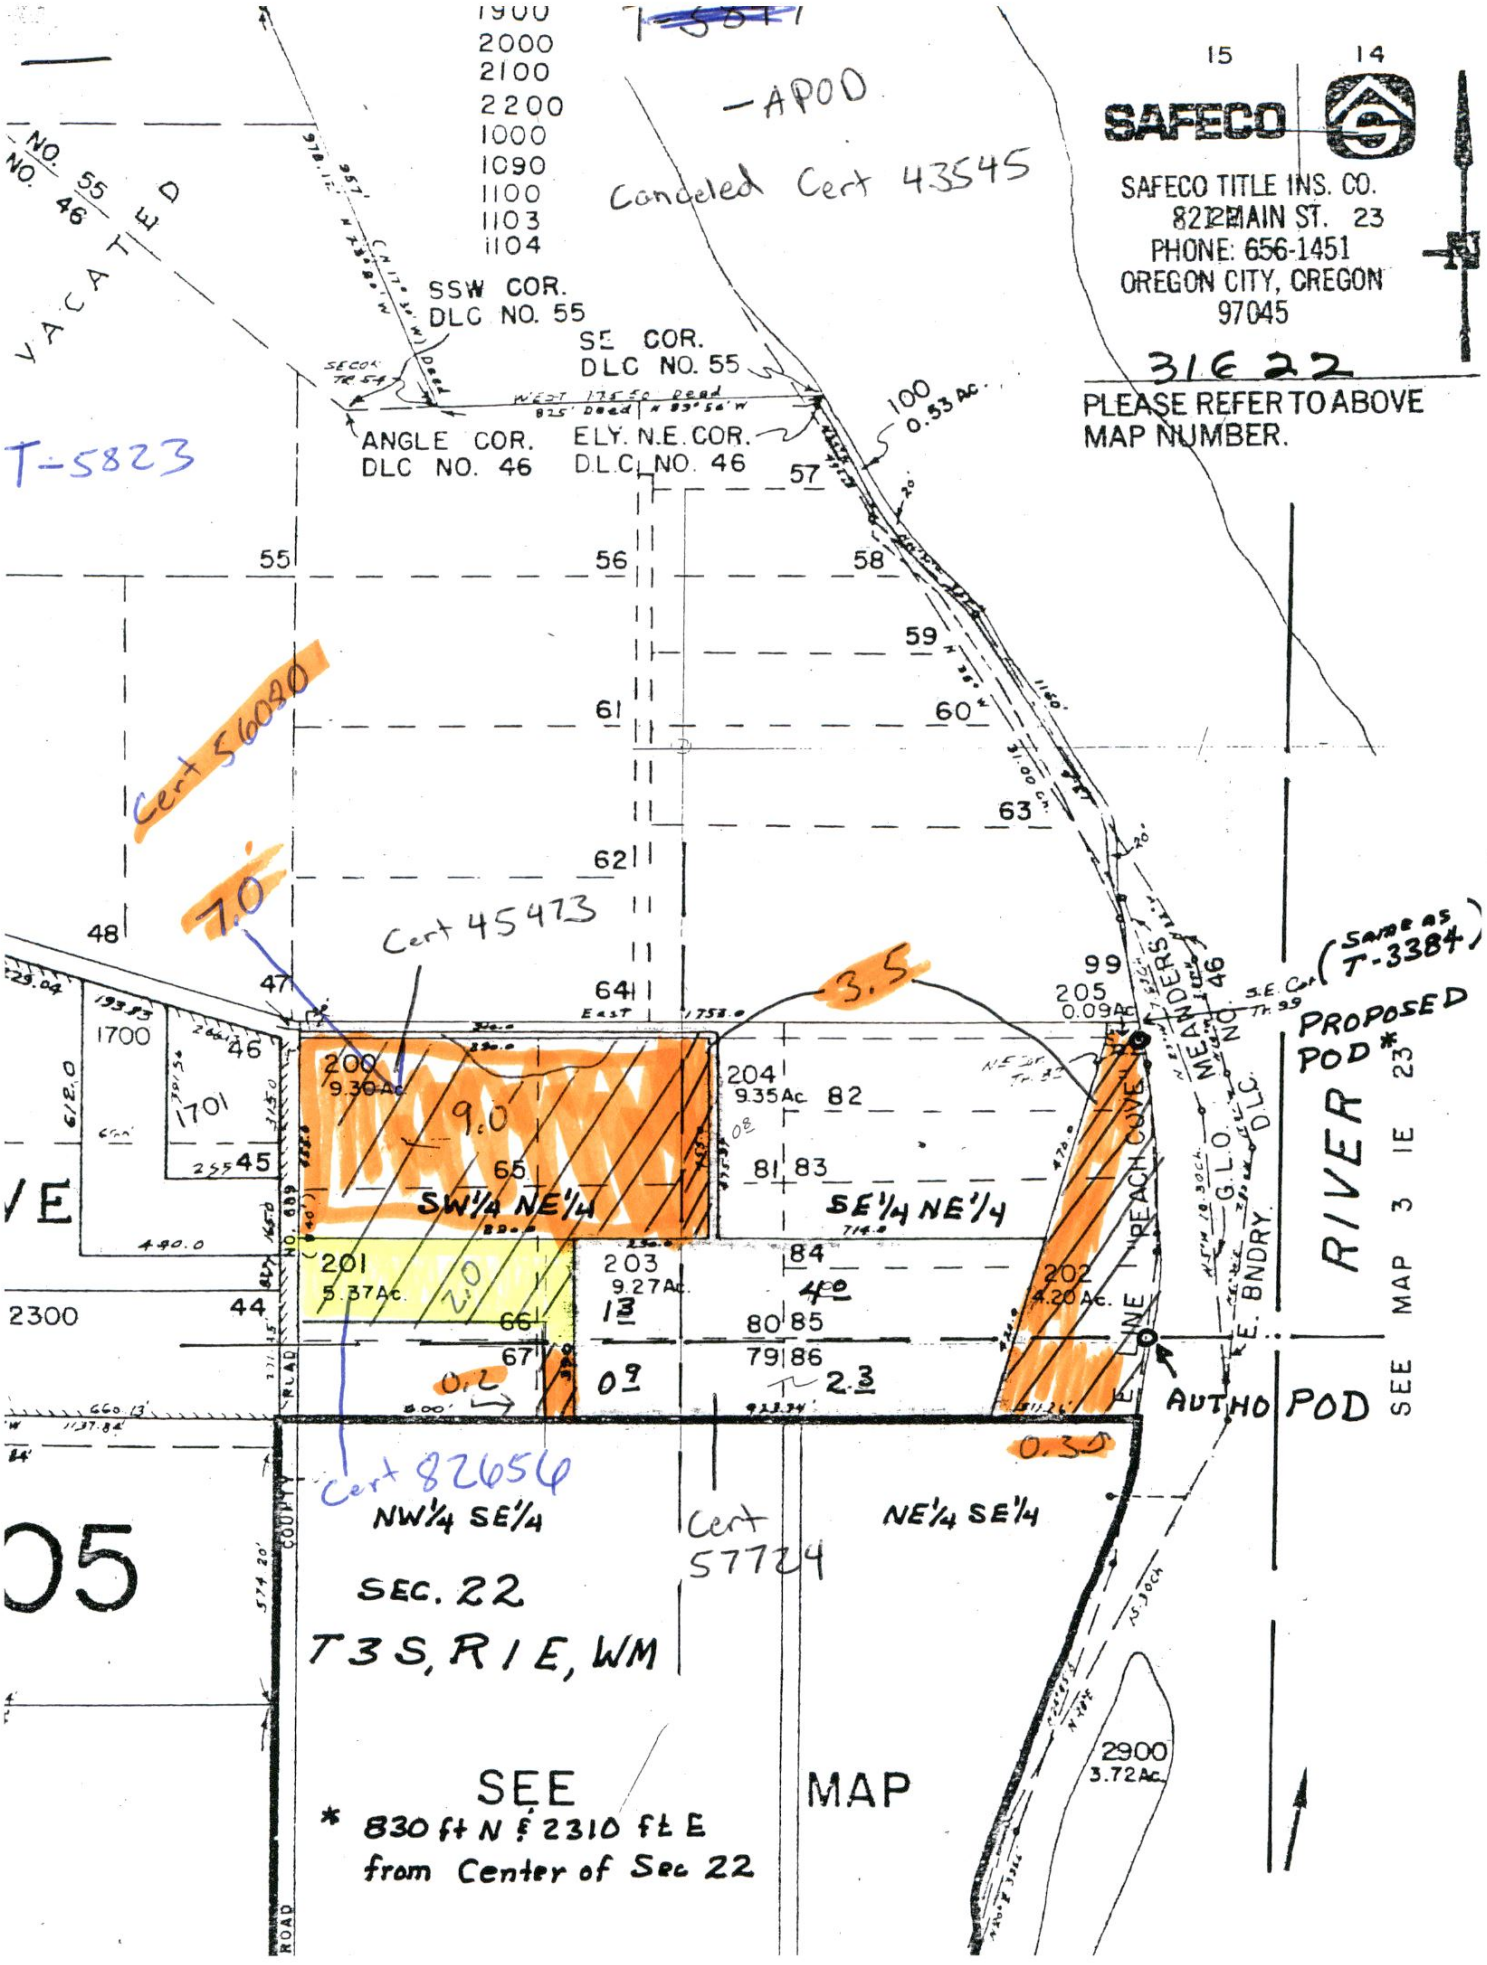
1900
2000
2100
2200
1000
1090
1100
1103
1104
-APOD
Canceled Cert 43545
15
14
SAFECO
SAFECO TITLE INS. CO.
821 MAIN ST. 23
PHONE: 656-1451
OREGON CITY, OREGON
97045
31E 22
PLEASE REFER TO ABOVE MAP NUMBER.
VACATED
NO. 55
NO. 46
SSW COR. DLC NO. 55
SE COR. DLC NO. 55
ANGLE COR. DLC NO. 46
ELY. N.E. COR. DLC NO. 46
T-5823
Cert 56090
7.0
Cert 45473
3.5
9.0
2.0
0.2
0.9
2.3
0.3
Cert 82656
Cert 57724
55
56
57
58
59
60
61
62
63
64
48
47
46
45
44
1700
1701
2300
200
9.30Ac.
201
5.37Ac.
203
9.27Ac.
204
9.35Ac.
202
4.20Ac.
205
0.09Ac.
2900
3.72Ac.
SW¼ NE¼
SE¼ NE¼
NW¼ SE¼
NE¼ SE¼
SEC. 22
T3S, R1E, WM
SEE MAP
* 830 ft N & 2310 ft E from Center of Sec 22
REACH COVE
MEANDERS
G.L.O.
E. BNDRY.
RIVER
PROPOSED POD*
(Same as T-3384)
AUTHO POD
SEE MAP 3 1E 23
COUNTY ROAD