25-5-5

Township 18, S., Range 45, E.W.M.

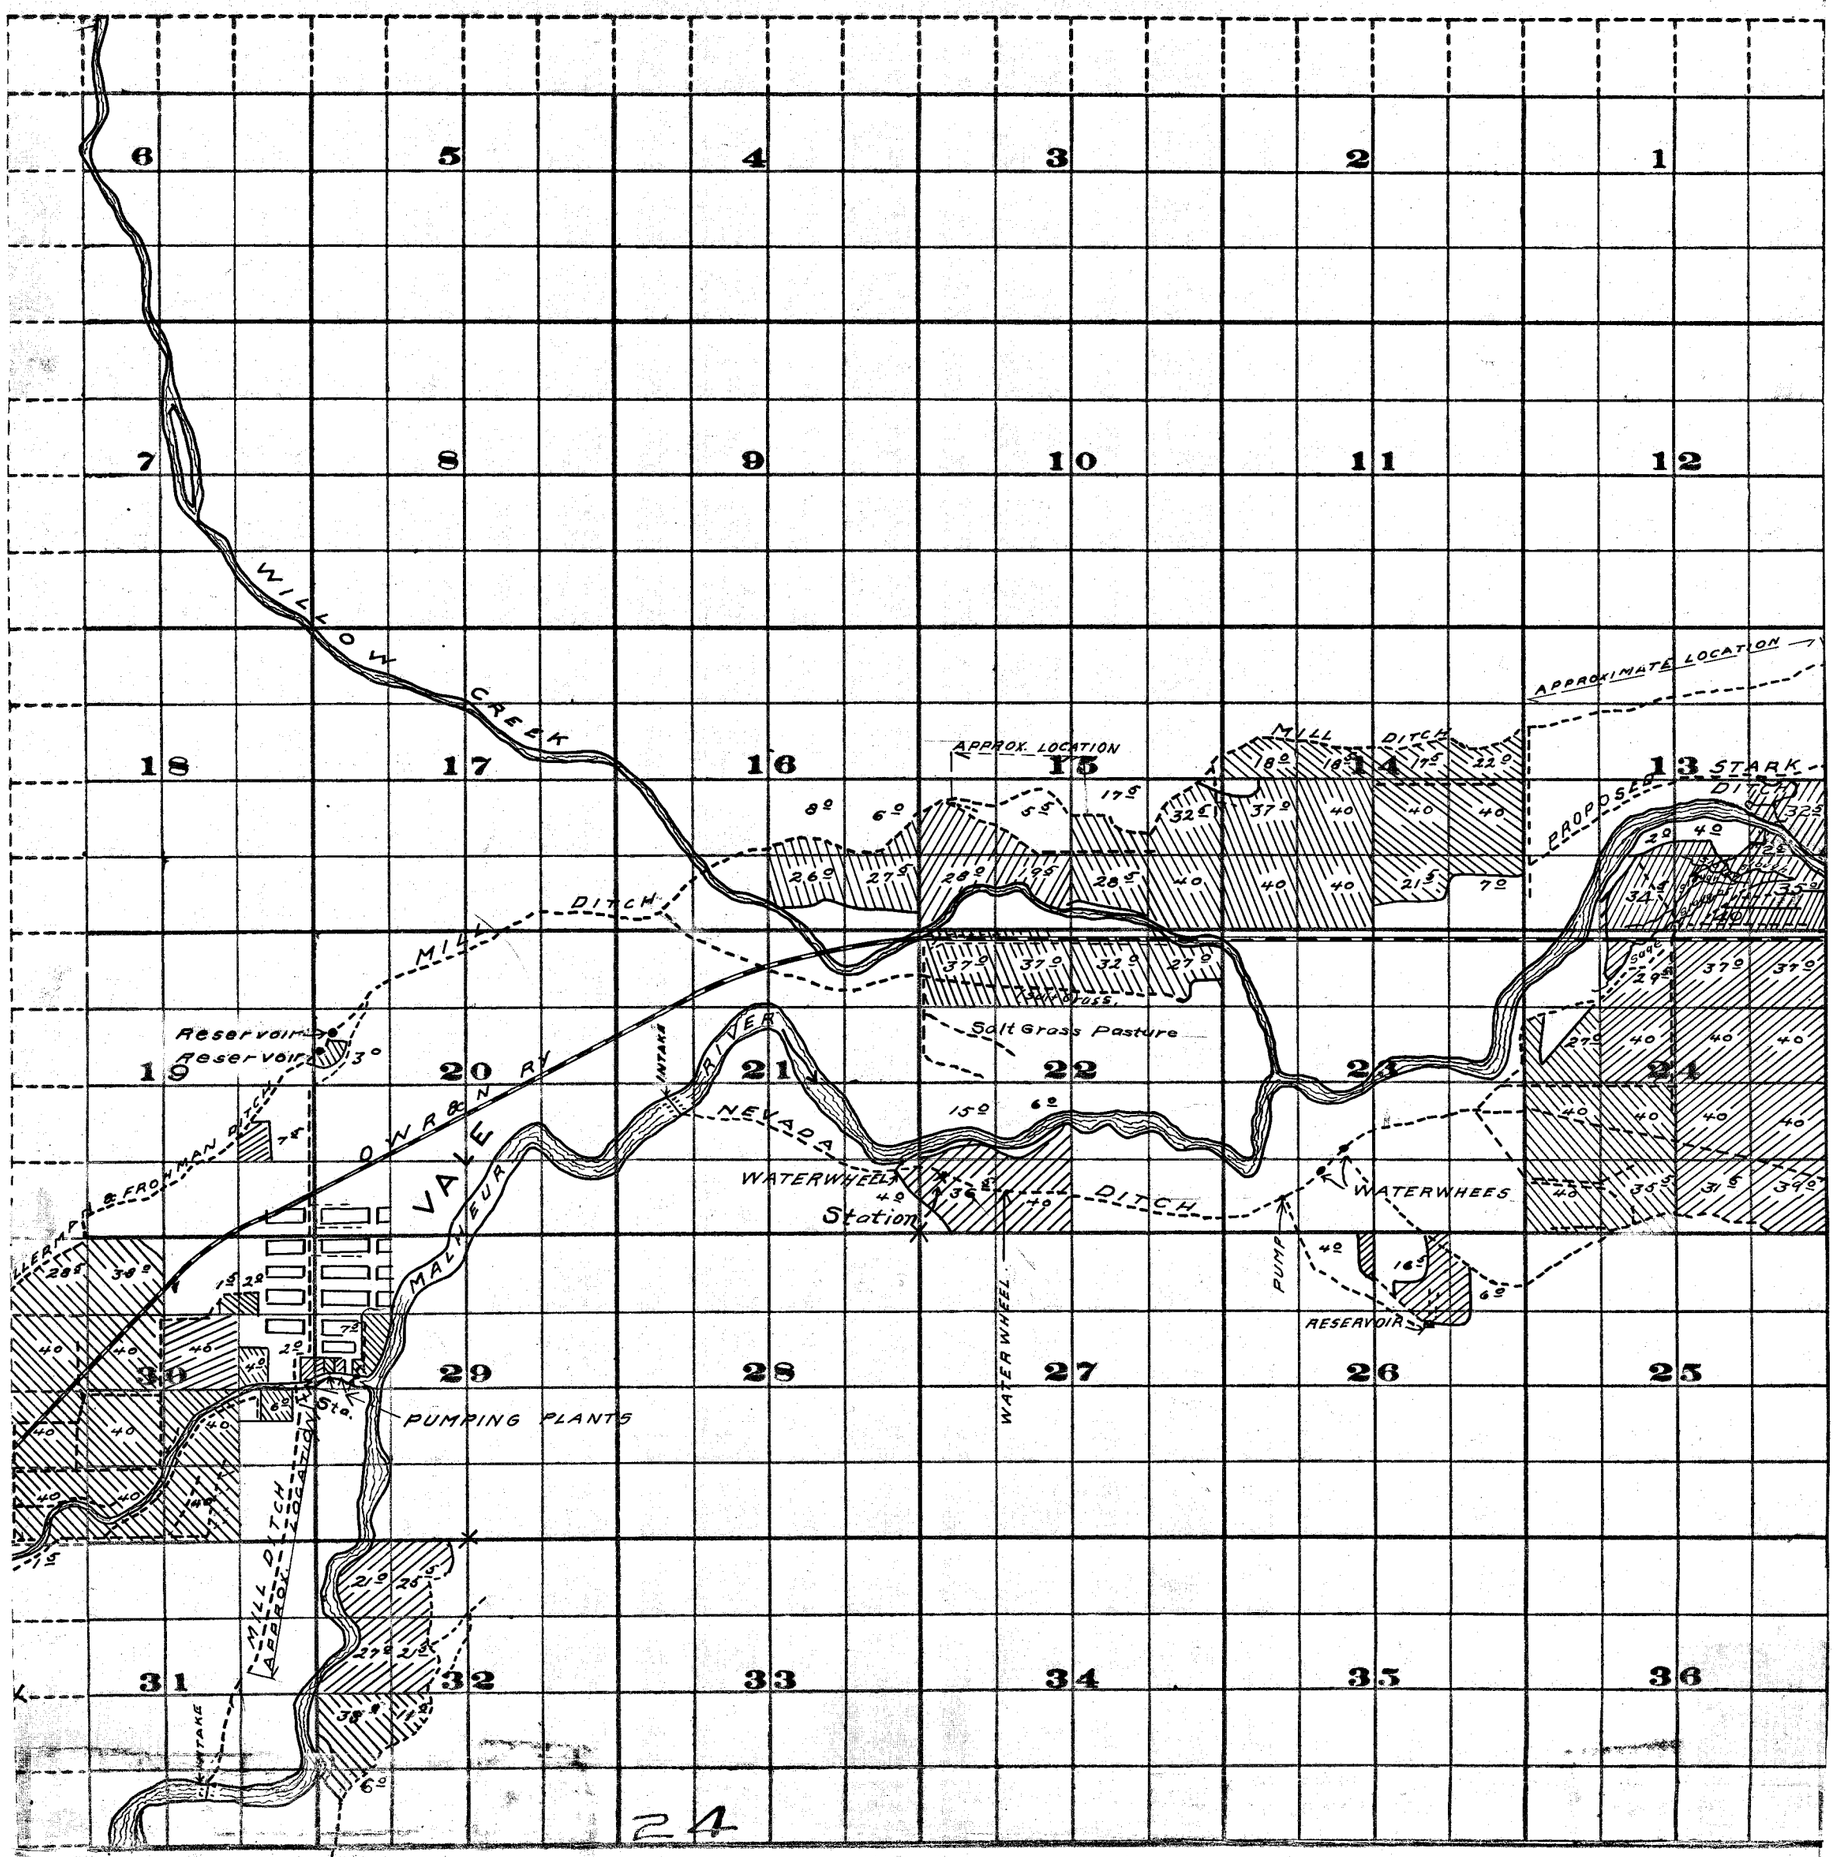

Scale of Feet

— LEGEND —

Irrigated land with area
Streams.
Ditches.
Located corners.

Survey Aug. 1913

From Office of the State Engineer, Salem, Oregon

Adjudication Survey
Malheur River
and
Tributaries

24