


Township 19. S., Range 34. E. W.M.

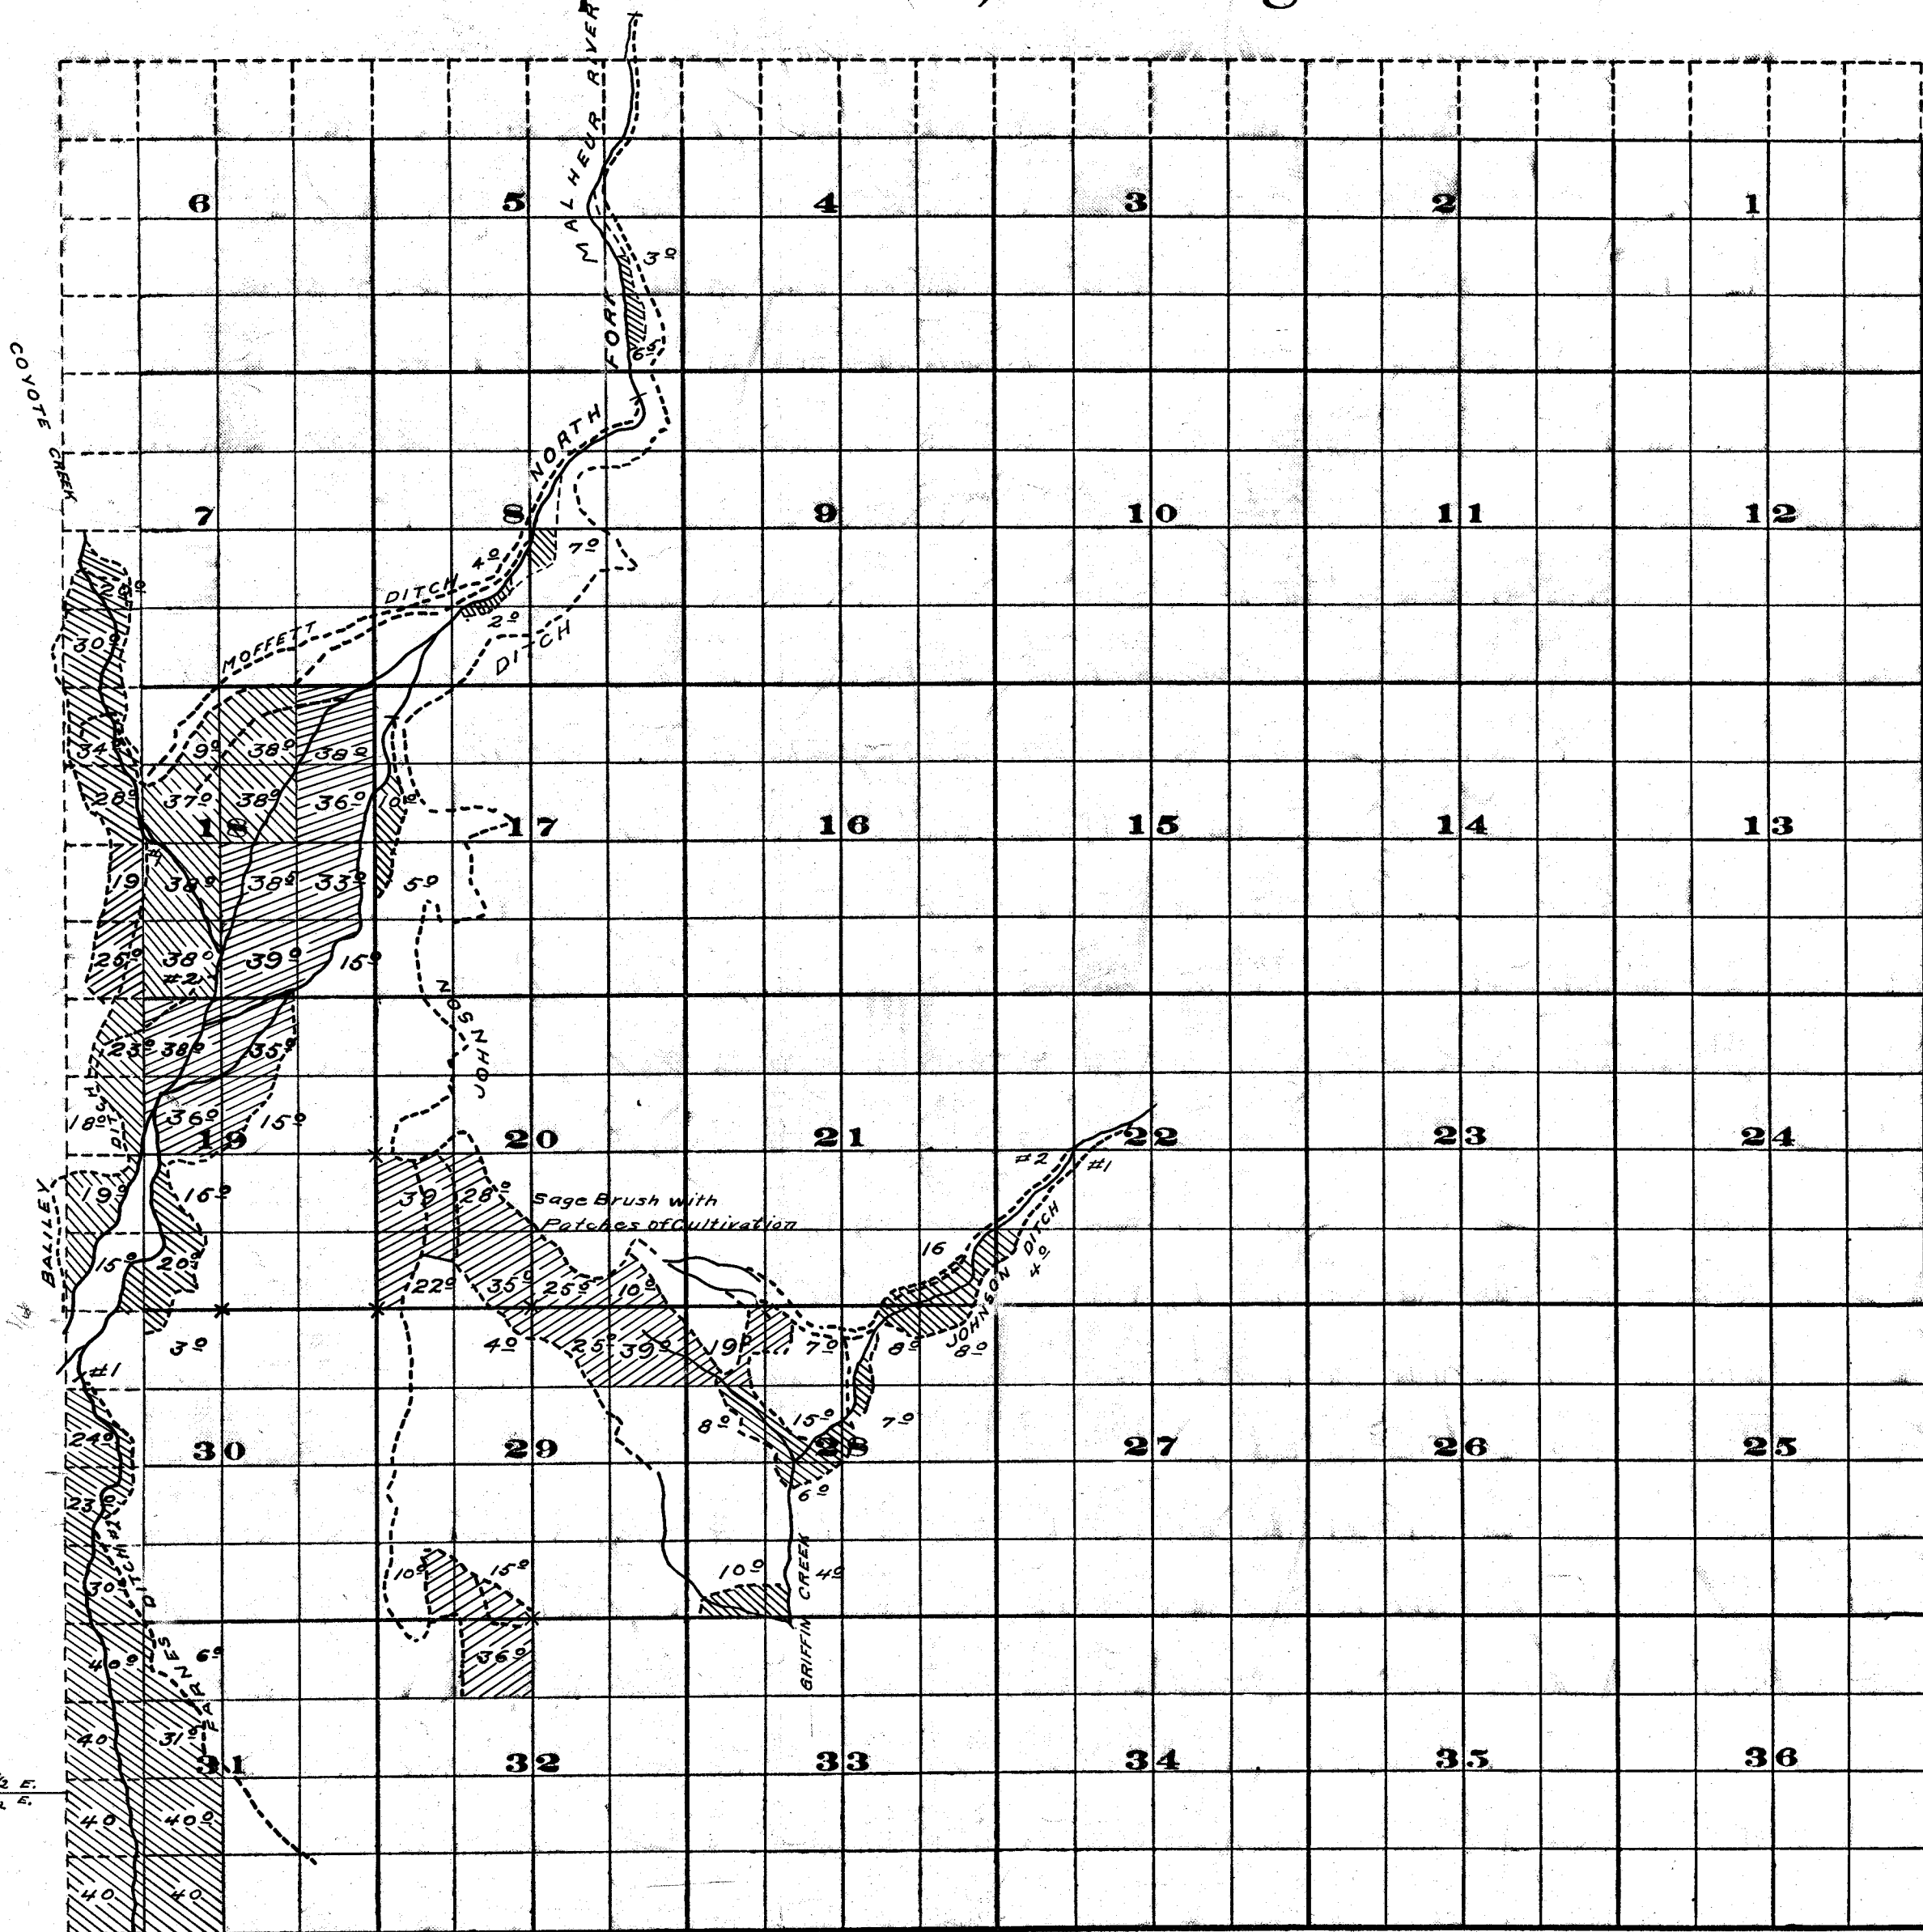

T. 19. S. R. 34. E.
T. 20. S. R. 33. E.



Scale of Feet.

Survey July, 1913.

FROM OFFICE OF THE STATE ENGINEER, SALEM, OREGON

Adjudication Survey
Malheur River
and
Tributaries.

LEGEND

- * Located corners.
- - - Ditches.
- ▨ Irrigated land with areas.
- ~ Streams.