


185-1W-33 NWNW 30'

Pond is 1109' South of North Section Line
and 212' West of North Section Line
212' East NW CORNER
SEC 33

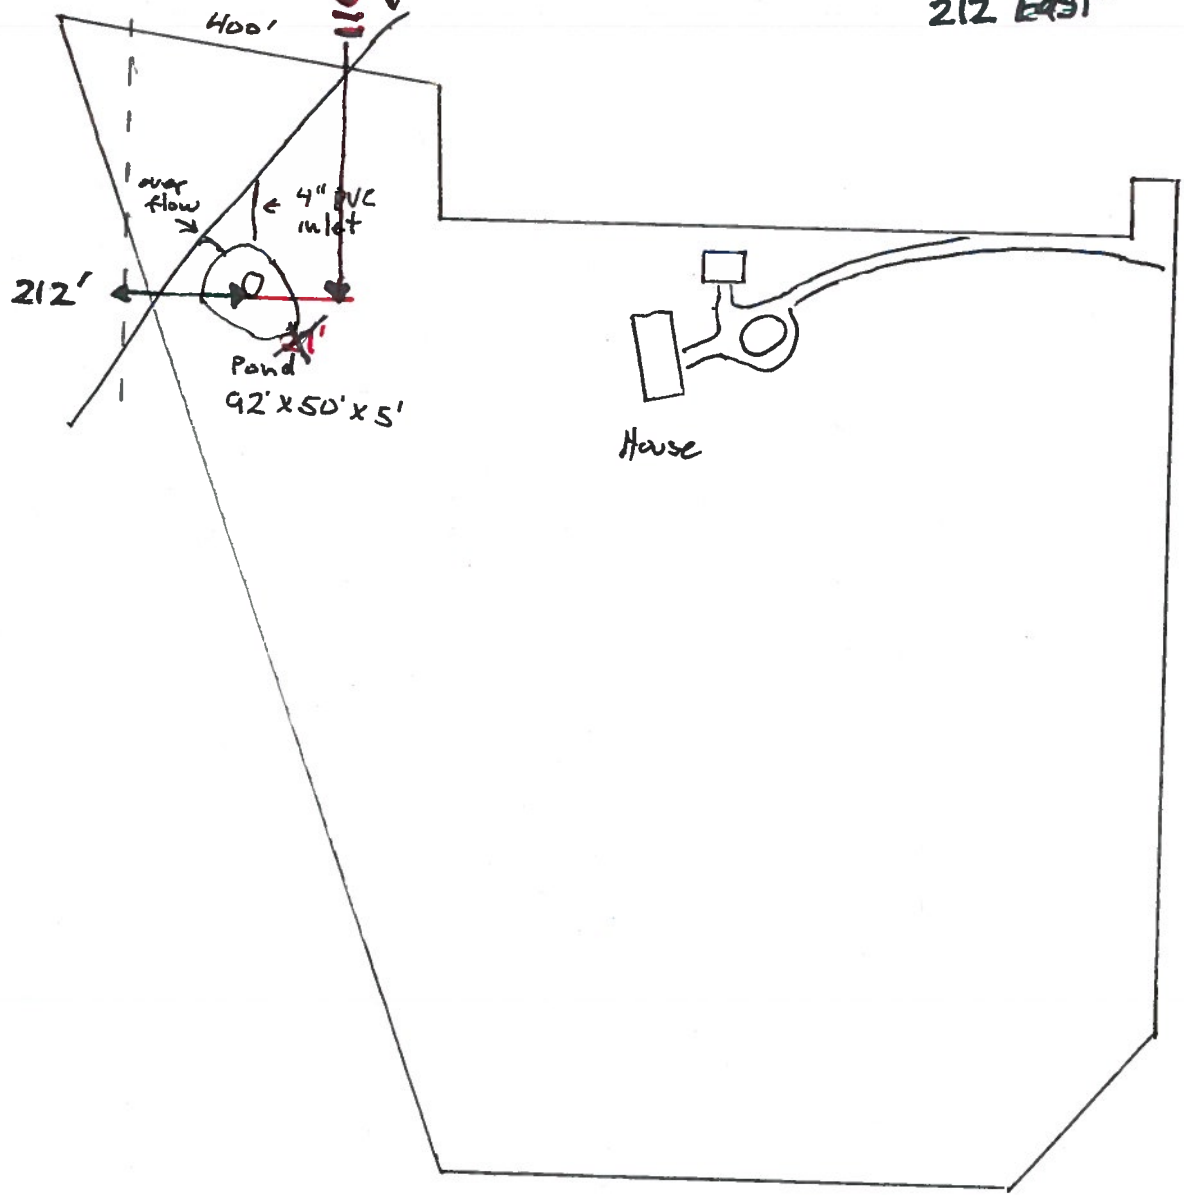

North
↑

RECEIVED
JUN 18 2019
OWRD

Timothy McMahon
38885 Jasper Lowell Rd
Fall Creek Or 97438

RECEIVED
SEP 18 2019
OWRD

RECEIVED
MAY 31 2019
OWRD

R-88712

1" = 200'