

BOOK 8

NE 1/4 SW 1/4 SEC 21 T 36S R 5W W.M.
JOSEPHINE COUNTY

36 5 21 CA
GRANTS PASS

1" = 100'

This map was prepared for
assessment purposes only.

SEE MAP 36 5 21 BD

CANCELLED
3700
3701
3801
3901
CEN. SEC. 21
T 36S R 5W W

4581
4590
4201
4582
4501
4100
900
390
200

SEE MAP 36 5 21 DB

SEE MAP 36 5 21 CB

SEE MAP 36 5 21 CD

N
Scale:
1" = 220'
Reference Corner


Tax Lot Description
NE 1/4 SW 1/4
SEC 21
Township 36S
Range 5W
Tax Lot #4500

Point of Diversion
Township 36S
Range 5W
Section 21
NE SW
1000 ft South
70 ft East of
NW Corner of NE SW

GPS Coord.
42.42322
-123.30236

Legend:


Place of Use - 

Pump - 

Pipeline - 

Place of Use = 0.7 Acres

5-88715

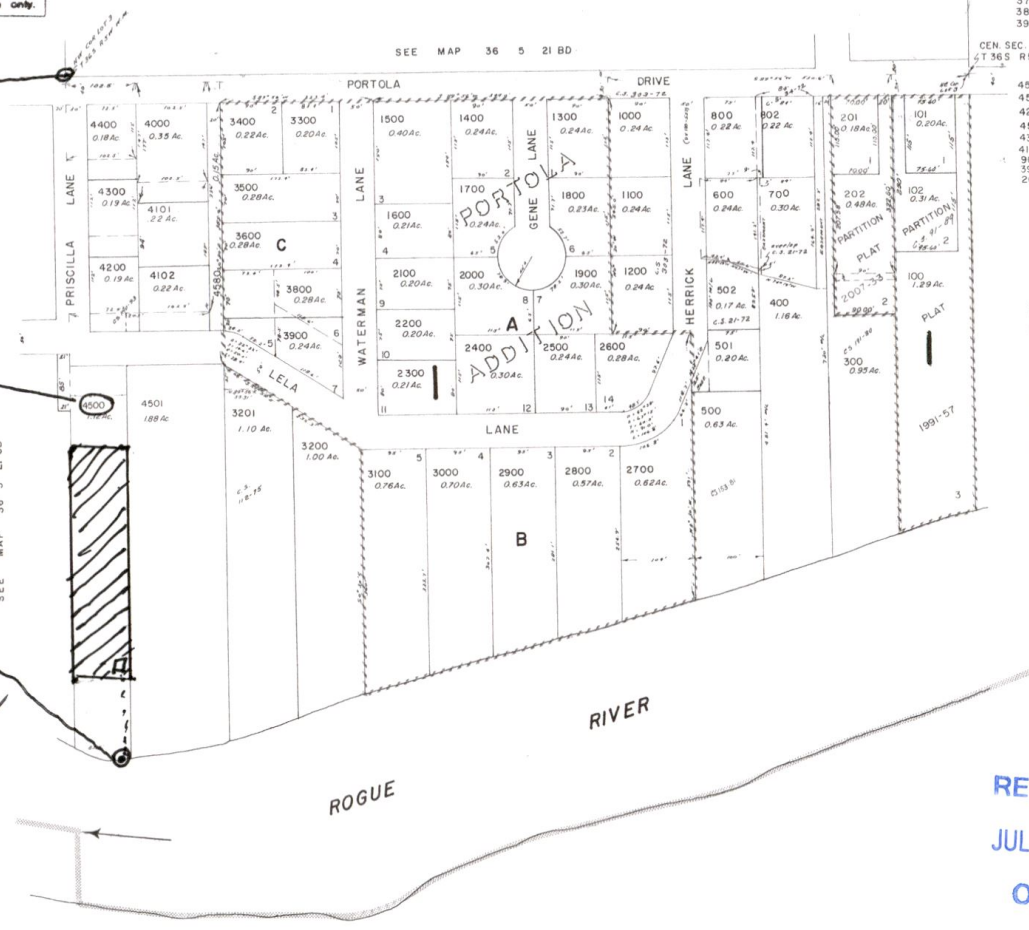

RECEIVED
JUL 01 2019
OWRD

36 5 21 CA