


RECEIVED

JUL 01 2019

OWRD



Application Map
Umpqua Ranch Cooperative
T.26S. R.3W. Sec. 10
Douglas County
Scale: 1" = 400'

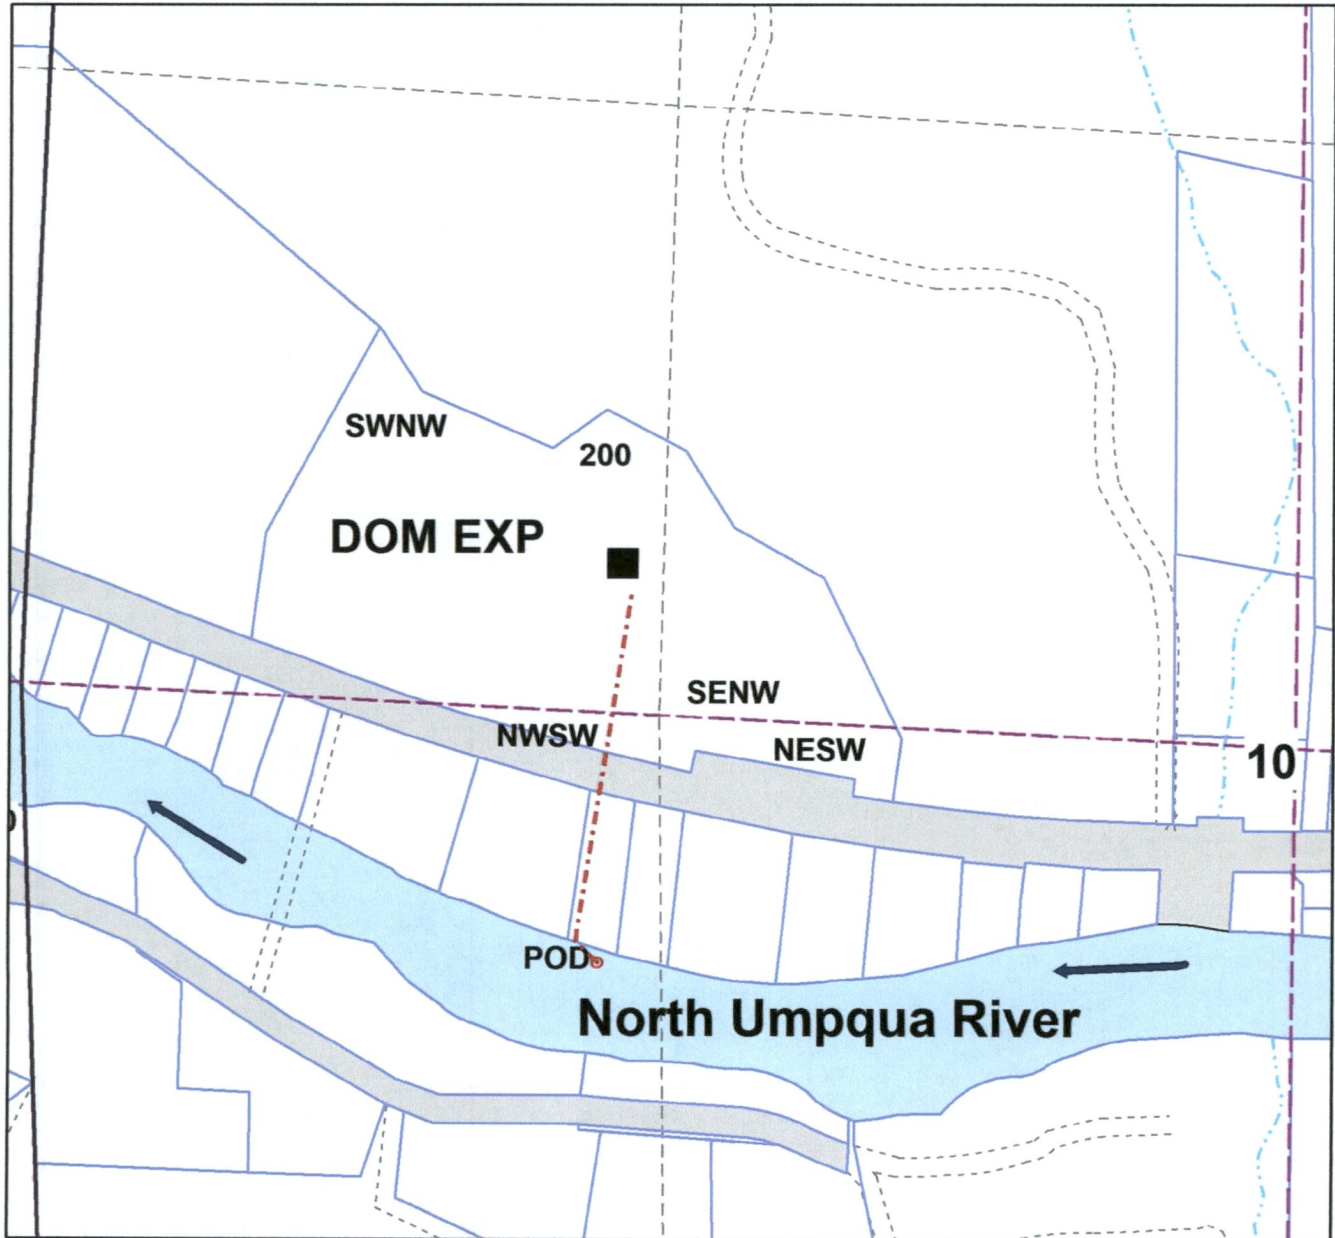

**Point of Diversion is 500 ft. South and 1210 ft. East from
the West Quarter Section Corner.**

The purpose of this map is to identify
the location of a Water Right.
Not intended to show property ownership.

5-88714

FINAL PROOF SURVEY MAP
 IN THE NAME OF:
 FORREST RANCH MOBILE HOME PARK

*from
 appendix
 of feasibility
 study*

Application S-84224

Permit S-53807

RECEIVED

SECTION 10, TOWNSHIP 26 SOUTH, RANGE 3 WEST, W.M.

JUL 01 2019


Legal description - us

OWRD

NORTH

1"=1320'

AREA OF DOMESTIC USE FOR 111 HOUSEHOLDS.

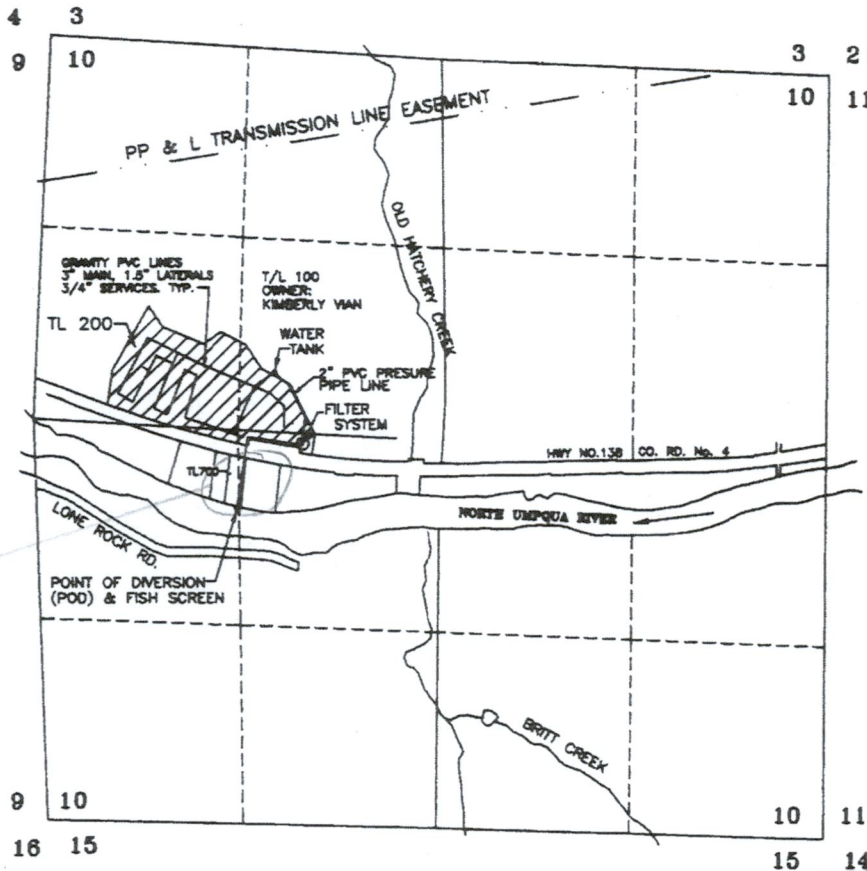

*Save lot
 6801.33*

Legal description - POD

THE POINT OF DIVERSION IS LOCATED 3256 SOUTH AND 1248 EAST FROM THE NORTHWEST CORNER OF SECTION 10; BEING WITHIN THE NW1/4 SW1/4 OF SECTION 10, TOWNSHIP 26 SOUTH, RANGE 3 WEST, W.M. DOUGLAS COUNTY.

RECEIVED
 OCT 30 2006
 WATER RESOURCES DEPT
 SALEM, OREGON

CERTIFIED WATER RIGHTS EXAMINER
 431WRE
[Signature]
 6-30-07
 KENNA CLAY JORDAN
 5-14-96
 STATE OF OREGON

THE PURPOSE OF THIS MAP IS TO IDENTIFY THE LOCATION OF THE WATER RIGHT. IT IS NOT INTENDED TO PROVIDE INFORMATION RELATIVE TO THE LOCATION OF PROPERTY OWNERSHIP BOUNDARY LINES.

99-27594

Easement Agreement
FORREST RANCH MOBILE HOME PARK
22284 N. UMPQUA HWY.
IDLEYLD PARK, OR 97447

BOOK 1656 PAGE 022

RECEIVED
JUL 01 2019
OWRD

We the undersigned, give permission to Forrest Ranch Mobile Home Park to cross over our property, tax lot #6801.33 Douglas County Courthouse, with water lines for said Mobile Home Park.

As compensation for above stated easement, Forrest Ranch Mobile Home Park shall provide 1/8" of continuous supply of treated water to our property, tax lot #6801.33 Douglas County Courthouse. In addition, Forrest Ranch Mobile Home Park shall provide free space rent to Raclene DeBernardi for as long as she resides in said Park. Free space rent is provided solely to this individual and is non-transferable. This agreement shall carry over to any future owners of Forrest Ranch Mobile Home Park and the property known as tax lot #6801.33. Reference No. 99-2479.

Craig Downey
Craig Downey
Forrest Ranch Mobile Home Park/Proprietor

Brad Downey 10201 Alatic Lane B.T. 7-17-99
Witness/Address/Date

Robert J. Powell 974 Mahogany Ln. Silverdale WA 98383
Witness/Address/Date



NOTARIAL CERTIFICATE:

State of Washington
County of Kitsap

I certify that Craig Downey is personally known to me and is the person who appeared before me. Said person acknowledged that he signed this instrument and acknowledged it to be his free and voluntary act for the uses and purposes mentioned in the instrument.

Dated this 19th day of July, 1999

Cynthia M. Lynch
Cynthia M. Lynch
My appointment expires: 11/29/2001

Accepted and agreed to this 20th day of July, 1999.

Steve Kennaday
Steve Kennaday, Owner

Don Kennaday 253 Kennaday Lane, Idleyld Park, OR 97447 / 7-20-1999
Witness/Address/Date

Leucade Kennaday 253 Kennaday Ln - Idleyld Park - Ore 97447
Witness/Address/Date 7-20-1999

NOTARIAL CERTIFICATE:

State of Oregon
County of Douglas



I certify that I know or have satisfactory evidence that Steve Kennaday is the person who appeared before me, and said person acknowledged that he signed this instrument and acknowledged it to be his free and voluntary act for the uses and purposes mentioned in the instrument.

Dated this 20th day of July, 1999

Downey Enterprises
974 Mahogany Ln
Silverdale, WA 98383
By: Rebecca L. Jones
My appointment expires: 4-22-01