



1" = 1320'
Tax Lot: 1200

RECEIVED
JUN 26 2019
OWRD

Gregory Keed
North
7/3/2019
3:06 PM

7N5W

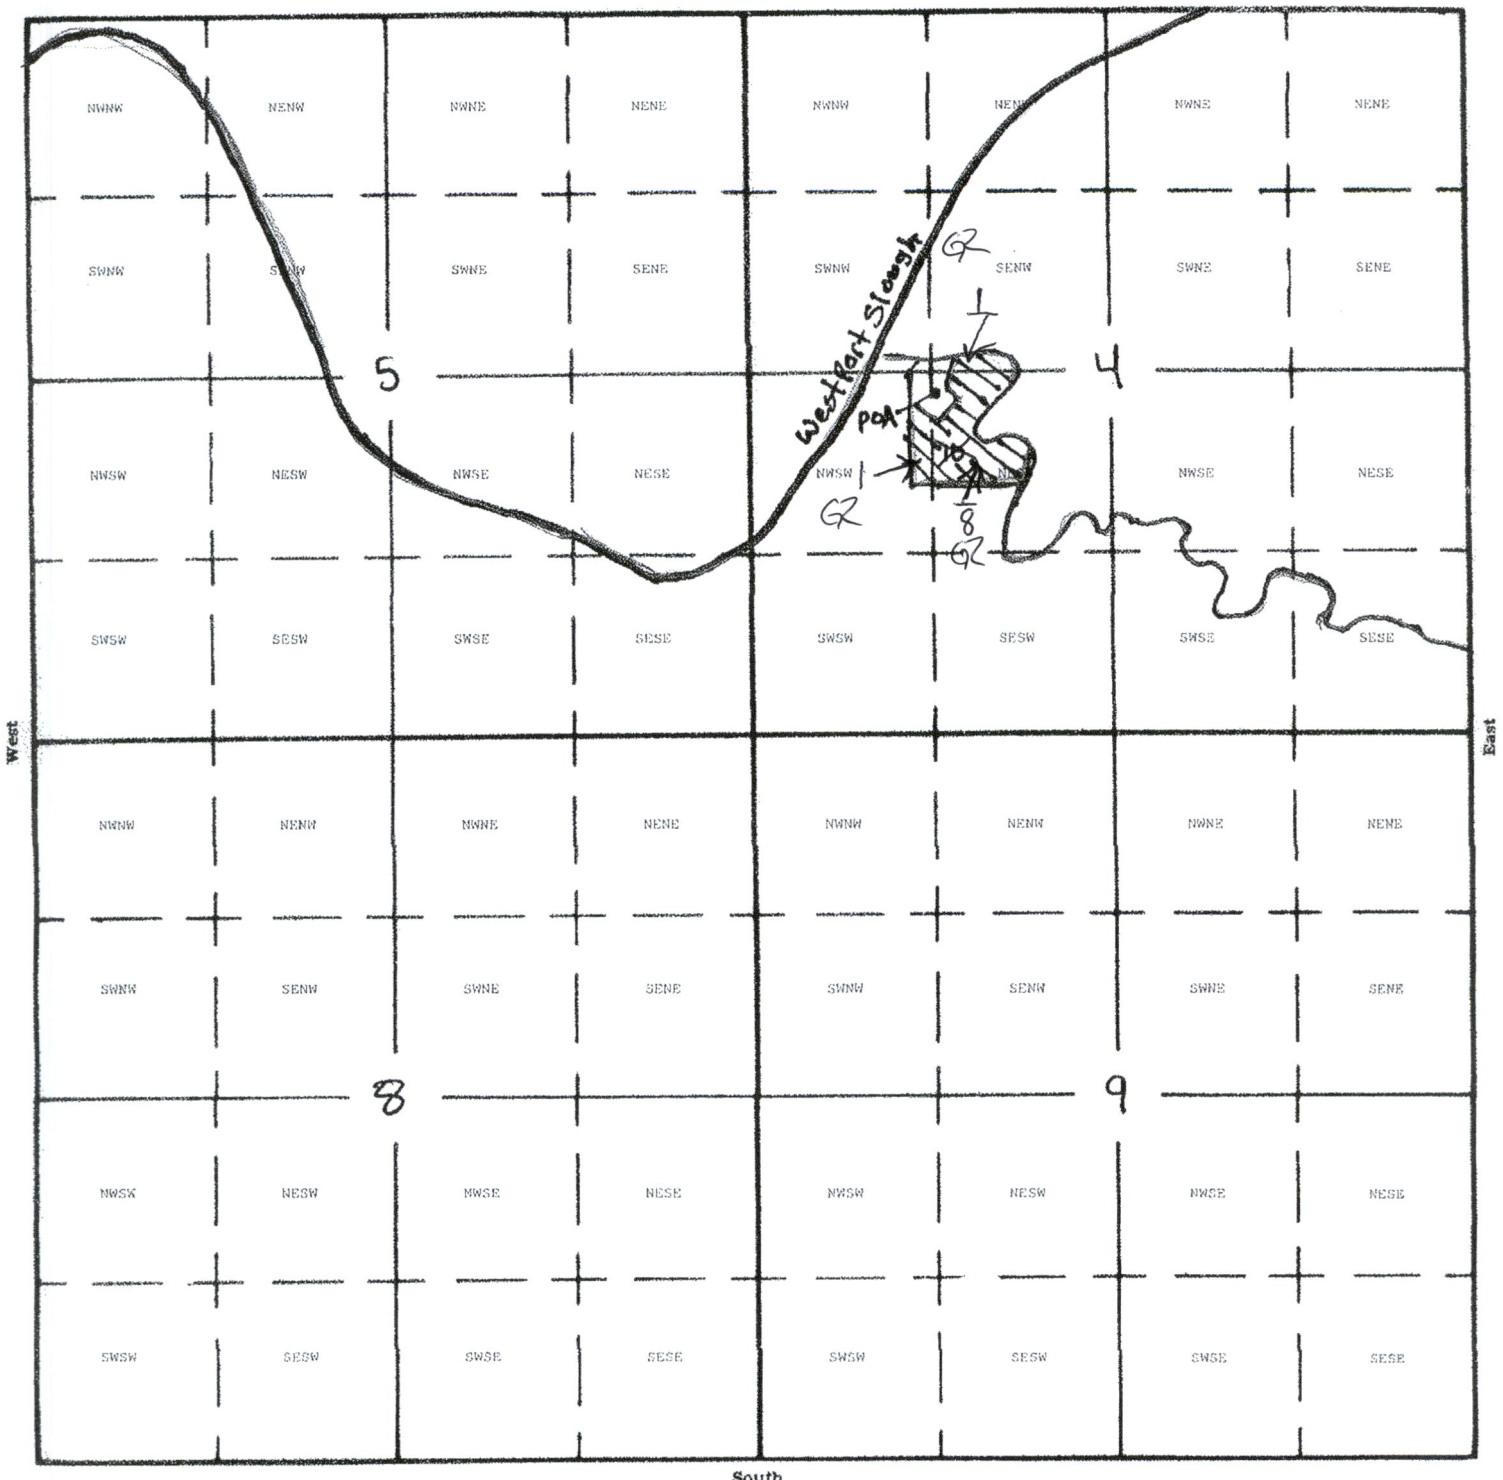

PoA = ■
Well location = 

Well location
1442 ft. E and 2598 ft. N
of SW corner of section 4

G-18795