


T. 37 S., R. 7 W., W.M.

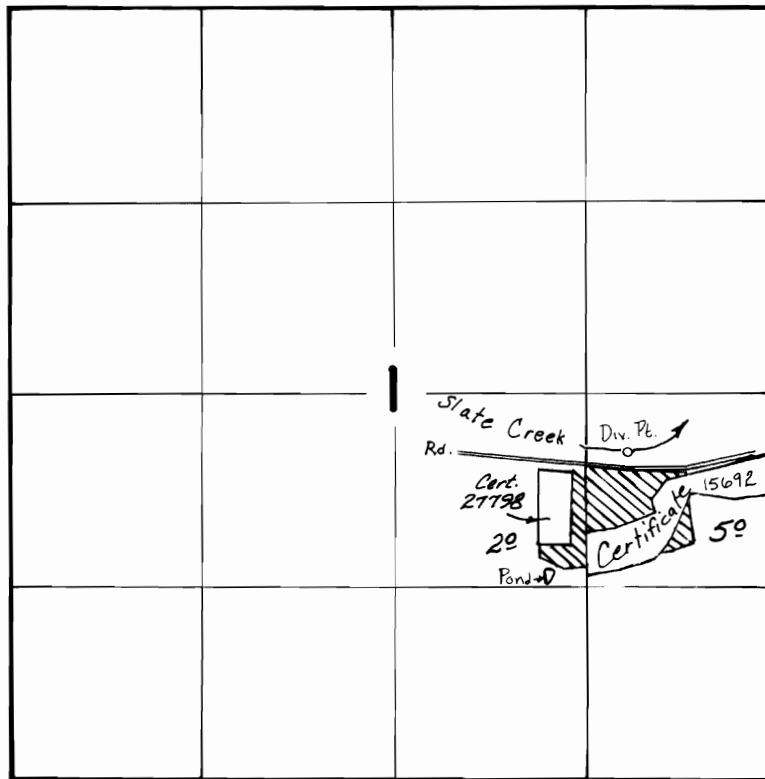

FINAL PROOF SURVEY
UNDER

TRANSFER NO. 4257

IN NAME OF

WILLIAM R. GAAR

Surveyed AUG. 13, 1982, by B. S. JAMES