

RECEIVED

JUL 03 2019


SECTION 13

TAX LOT: 04700
TOWNSHIP 035, RANGE 03W, W. M. Sec. 13

North

West

East

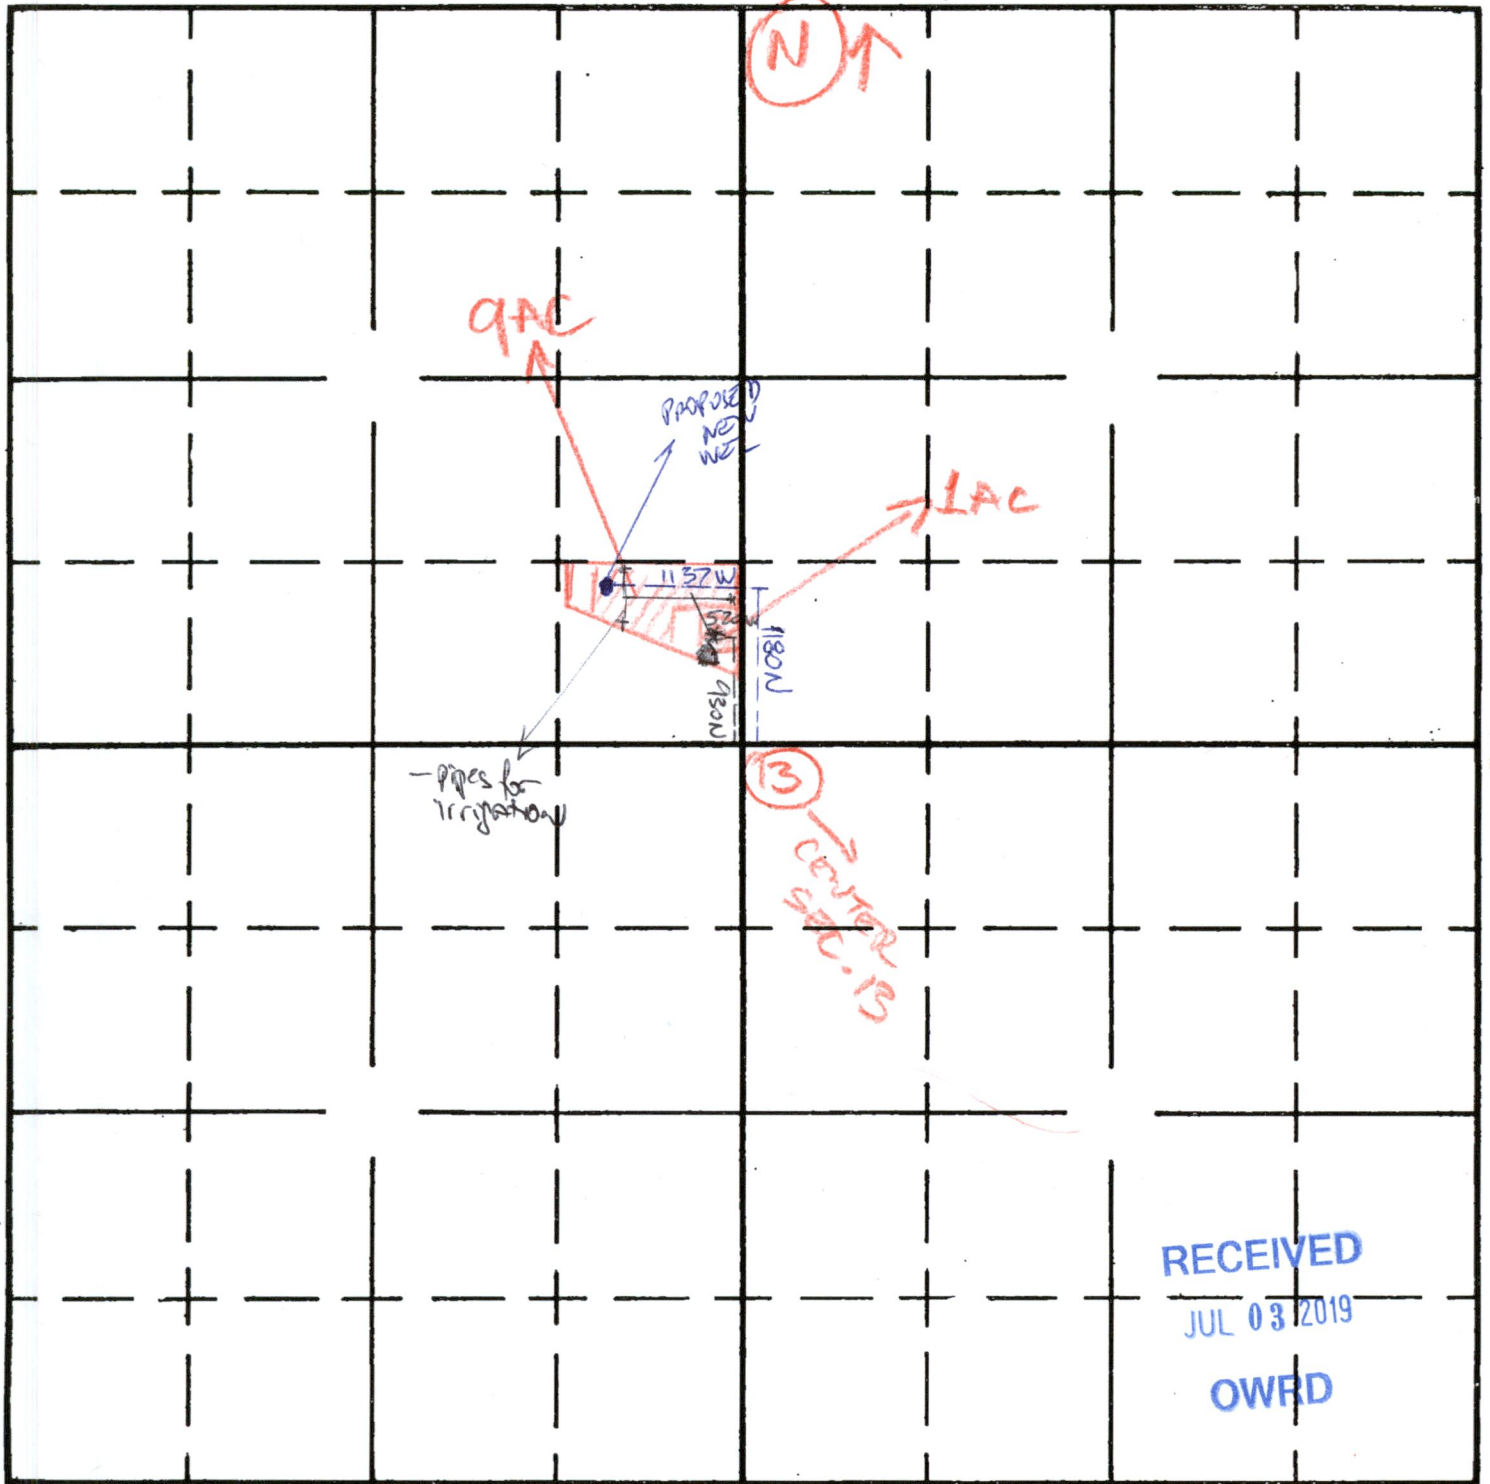

RECEIVED

JUL 03 2019

OWRD


South

- PROPOSED NEW WELL (1137W, 1180N) FROM CENTER SEC. 13
- * — EXISTING WELL (930W, 930N) FROM CENTER SEC. 13
- — — irrigation lines (pipes)

ACRES USED (9+1)

house


13-18837

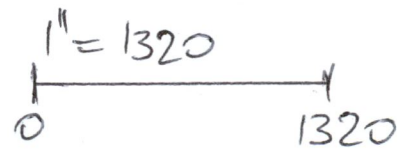


RECEIVED

JUL 03 2019

OWRD

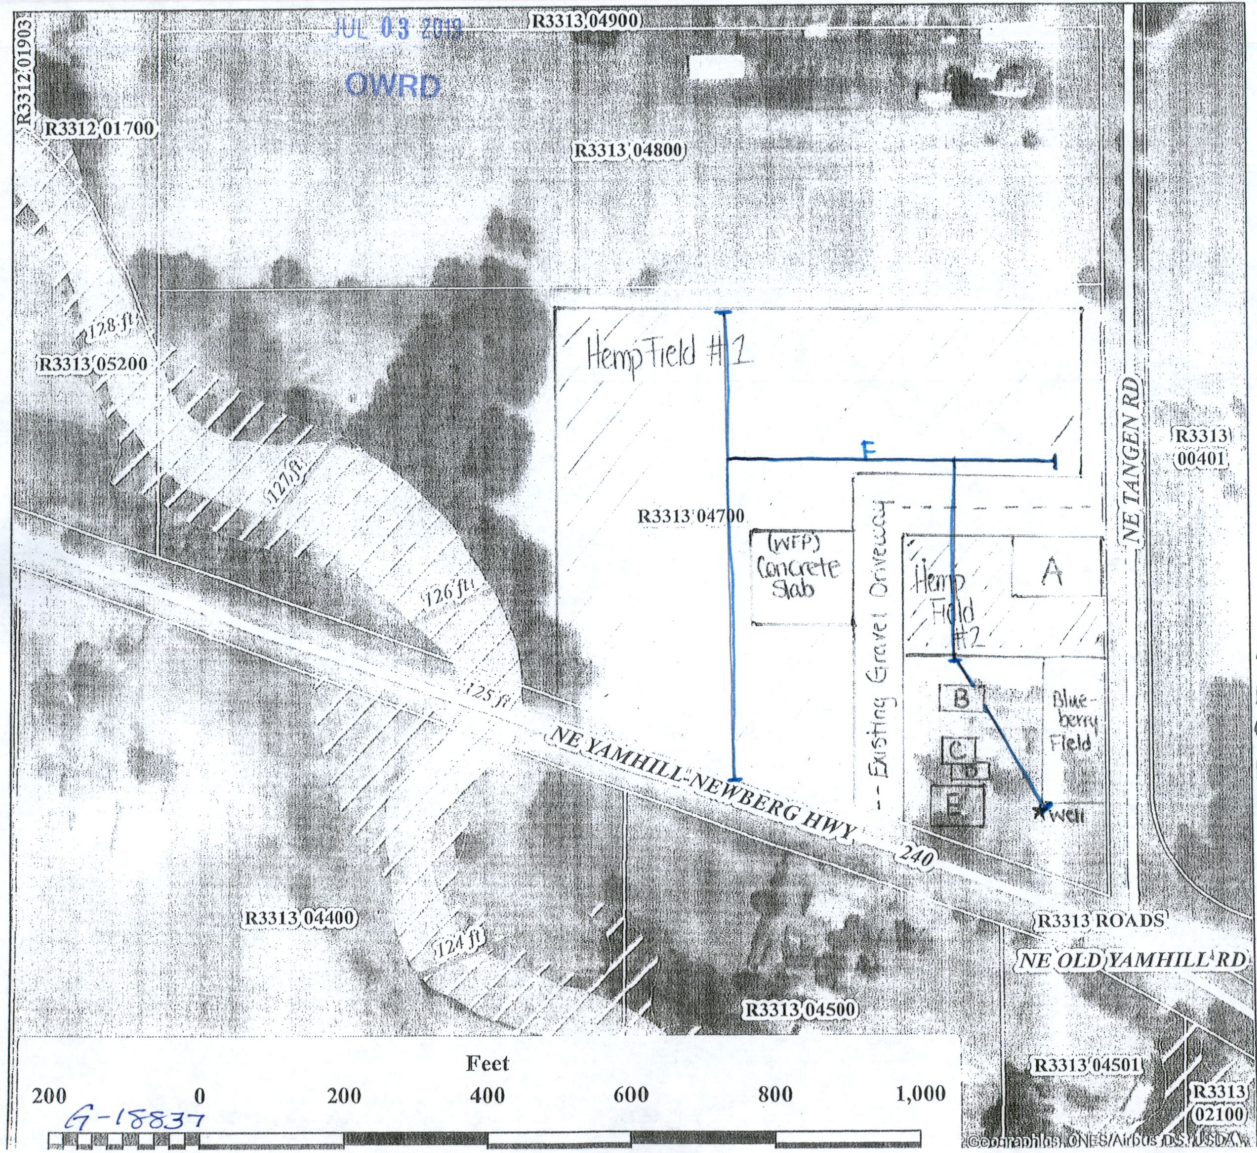

YAMHILL COUNTY TAX LOT INFORMATION & CONTEXTUAL MAP

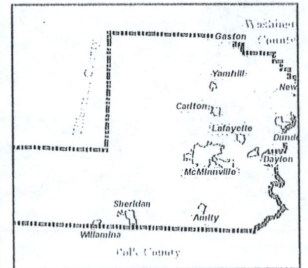

Property Information Docket: N/A

22745 NE Hwy 240

Subject Parcel(s)

Tax Lot: R3313 04700

Lot Acreage: 18.39

- A- Proposed Farm Crop processing Facility
- B- Storage Building #2
- C- Worm Farm Portland(WFP) office
- D- Storage Building #1
- E- Residential House
- F- Water pipe from well

FEMA Flood Zone

Base Flood Elev (ft)

100 Year Zone

Floodway

1 inch = 200 feet



6/19/2019

RECEIVED
JUL 03 2019

ODOT TransGIS

▼ Proposed Well
★ Existing Well

ODOT TransGIS

Basemaps Display Go To Analysis

OWRD



<https://gis.odot.state.or.us/transgis/> 18837