


Water Right Application Map

T 15 S R 11 E Section 31 WM

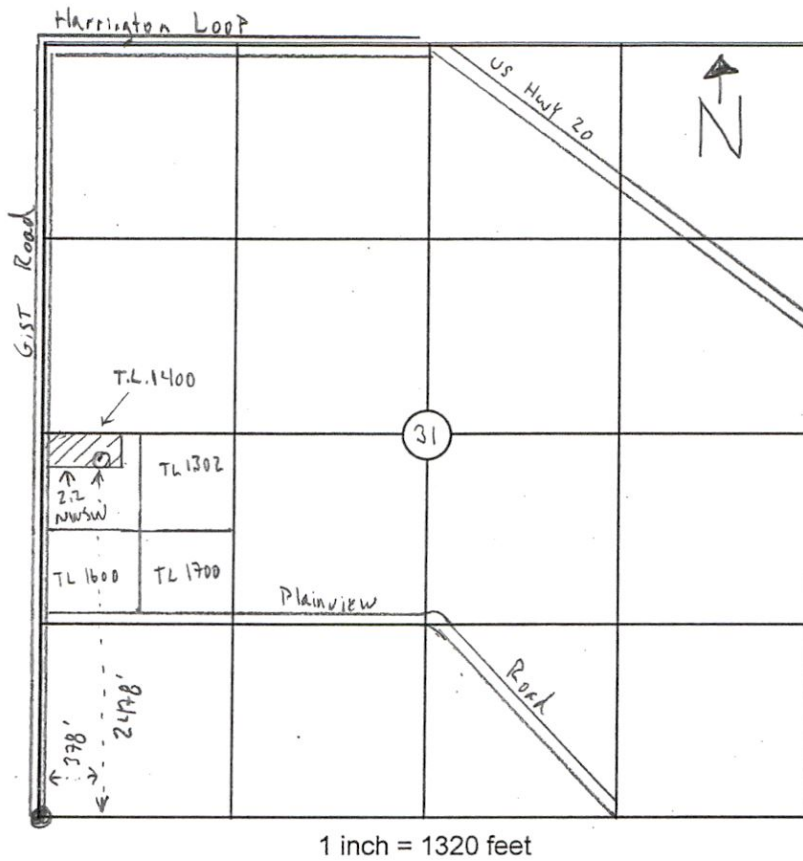

Proposed well
Primary Irrigation
2.2 ac M
NWSW

0 0.125 0.25 0.5 Miles

Well Location: 2478 Feet (N, S)
and 378 Feet (E, W) of SW Corner of 31

Application Map
IN NAME OF:

Clayton Strasser

Date: 6-28-19

RECEIVED
JUL 17 2019
OWRD



7-18841