


RECEIVED

JUL 25 1994

WATER RESOURCES DIVISION
SALEM, OREGON

T. 40 S., R. 9 W., W. M.

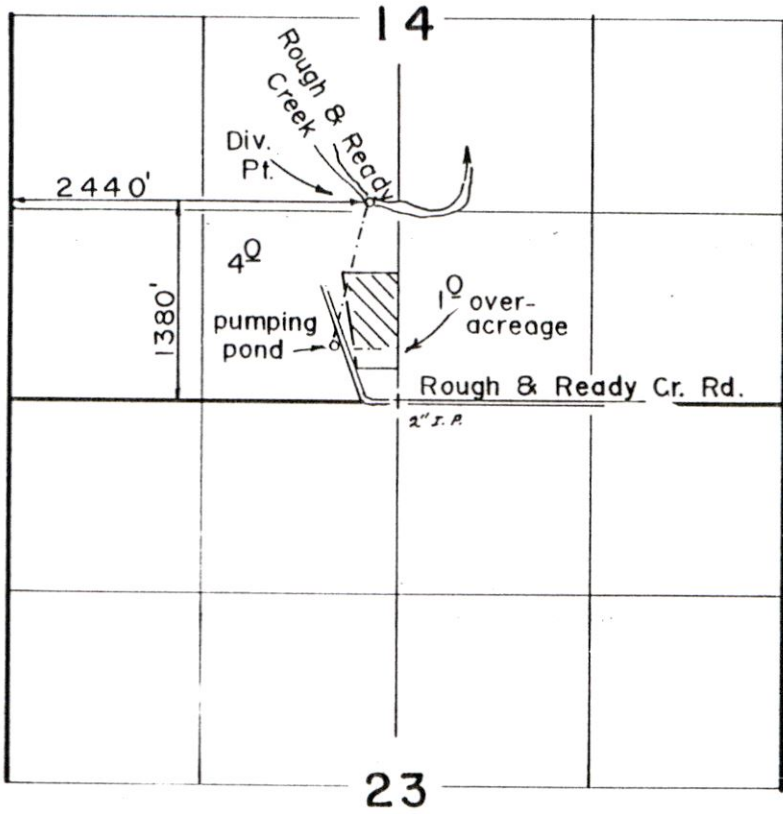

Scale: 1" = 1320'

FINAL PROOF SURVEY

UNDER

Application No. P74383
Permit No.

Application No. 58768. Permit No. 44332.

IN NAME OF

.....E.R.R.O.S.....W.....F.E.E.H.E.L.Y.....

Surveyed APR. 10. 19.8.6, by B. S. JAMES.