


1" = 160'


Tax lot 900

0' 80' 160'

Driveways ———
Buildings □

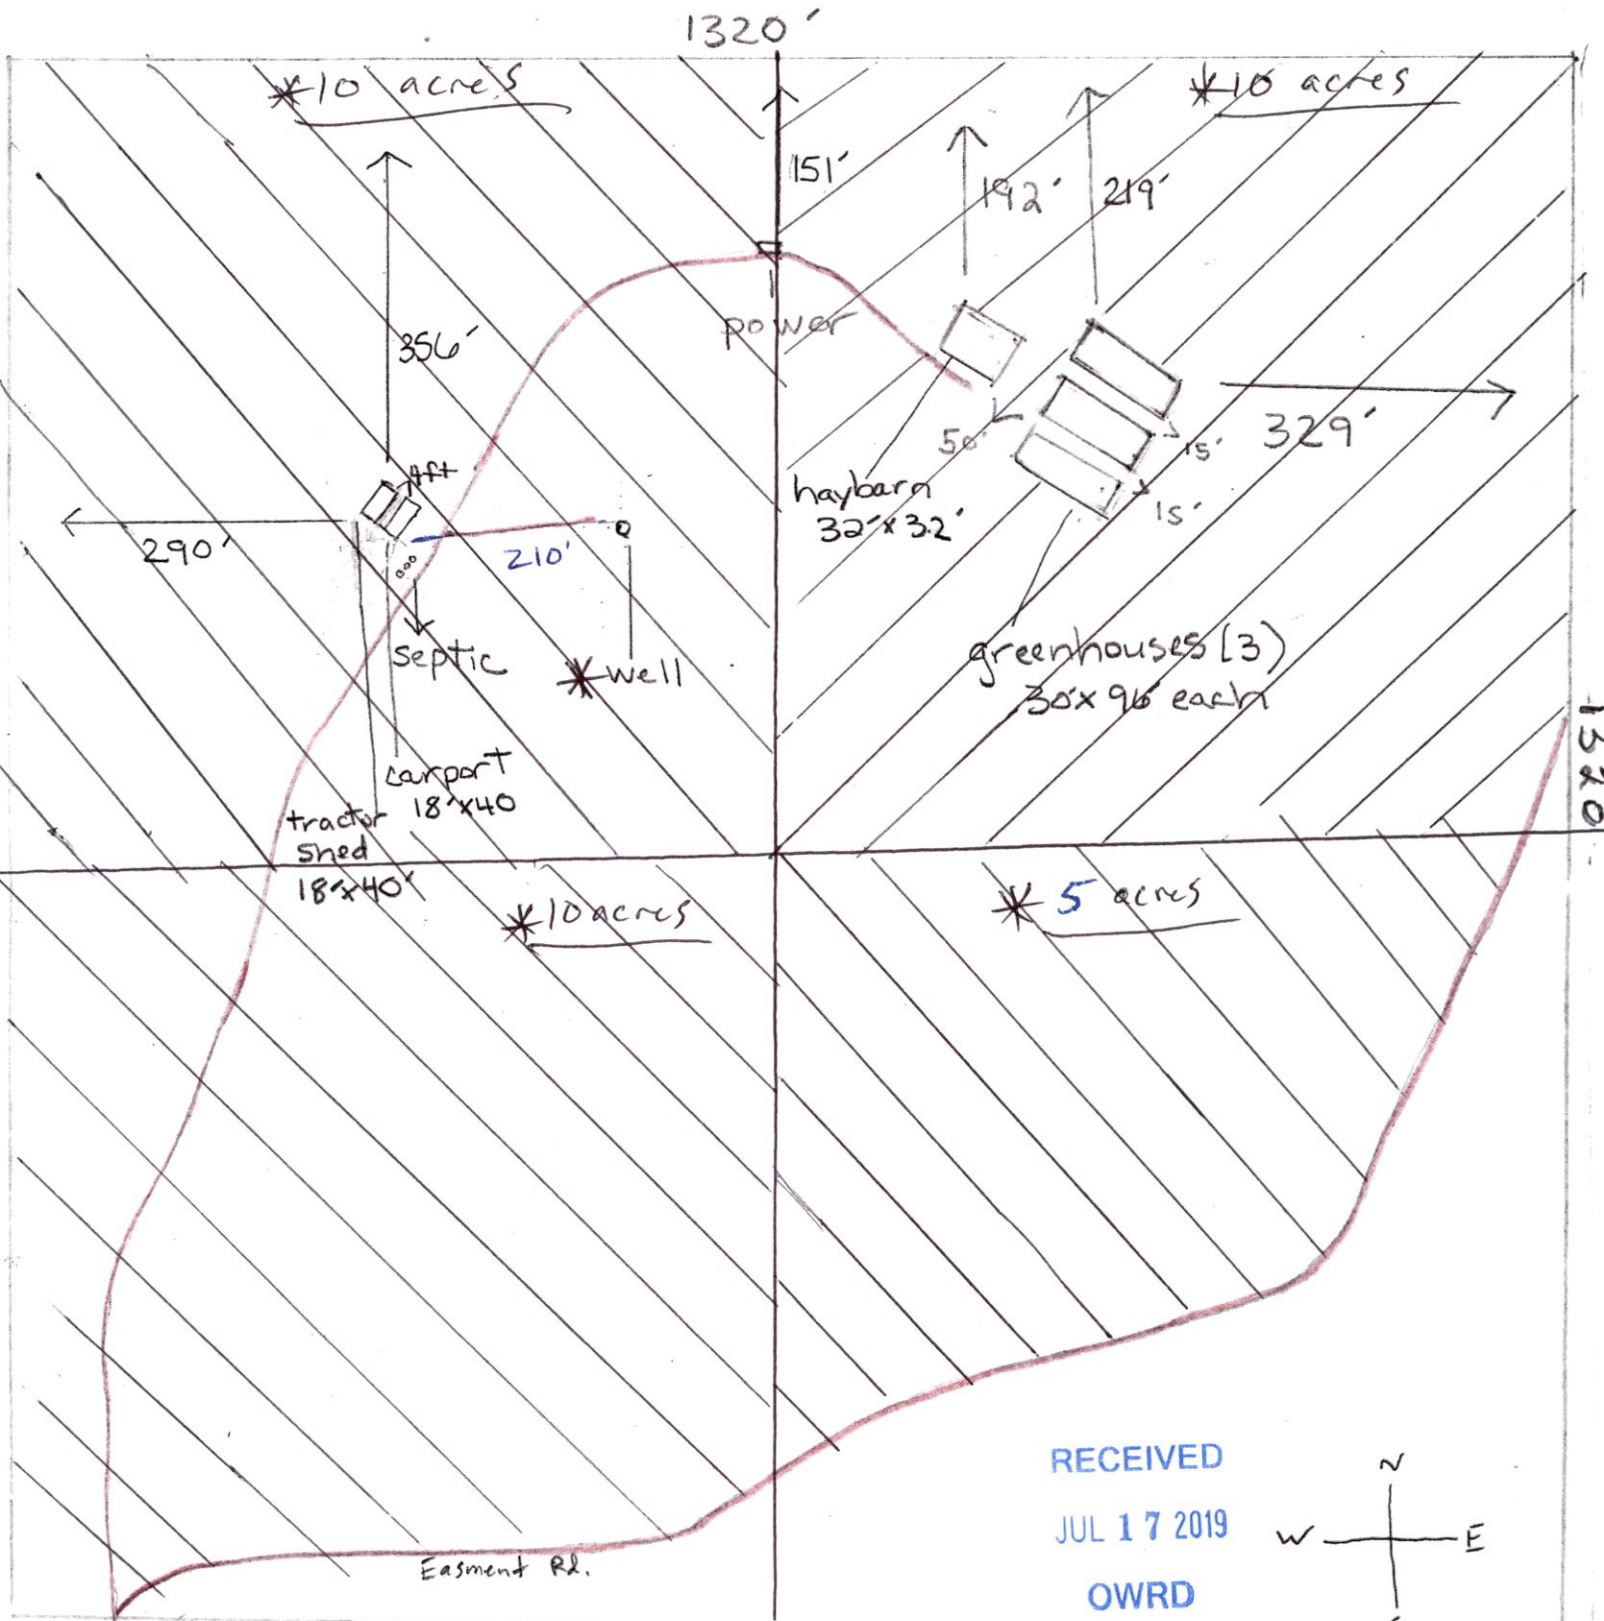

RECEIVED
JUL 17 2019
OWRD

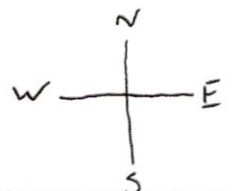

Schoenberger
1350 Pleasant Creek
Rogue River, Or.

G-18847

35S - 04W - 03 - 900 SE NW
Tax lot Entire

WORK COPY

PROPERTY (MULTI-PART) | MYGIS | CALSWISS

Tax Lots

Layers

Tools

Additional Measure Tools:

Buffer: Feet

Start Point: ☒ Clear All: ☒

Measure Distance (ft):

☐ N ☒ S ☐ E ☐ W

Bearing and Distance:

Degrees Minutes Seconds

☒ N ☒ E ☐ S ☐ W

(0-90) (0-60) (0-60)

Distance (ft):

Decimal Degrees:

Latitude: [Converter](#)

Longitude:



FOR ASSESSMENT AND
TAXATION ONLY

SECTION 3, T.35S., R.4W., W.M.
JACKSON COUNTY

1" = 400'

SEE MAP 34 4W 34

N 1/4
COR.

WORK

COPY

35 4W 03

CANCELLED TAX
LOT NUMBERS.
1306 ADDED TO 1308
1307 ADDED TO 1309
806 ADDED TO 805

62-2

SEE MAP 34 4W 04

W 1/4
COR.

SEE MAP

35 4W 03C

E 1/4
COR.

SEE MAP 35 4W 02

S 1/4
COR.

SEE MAP 35 4W 10

2

10

11

35 4W 03

NEW MAP JANUARY 18, 2005
REV JULY 12, 2013