


TOWNSHIP 38 S., RANGE 5 W.

25-4-4

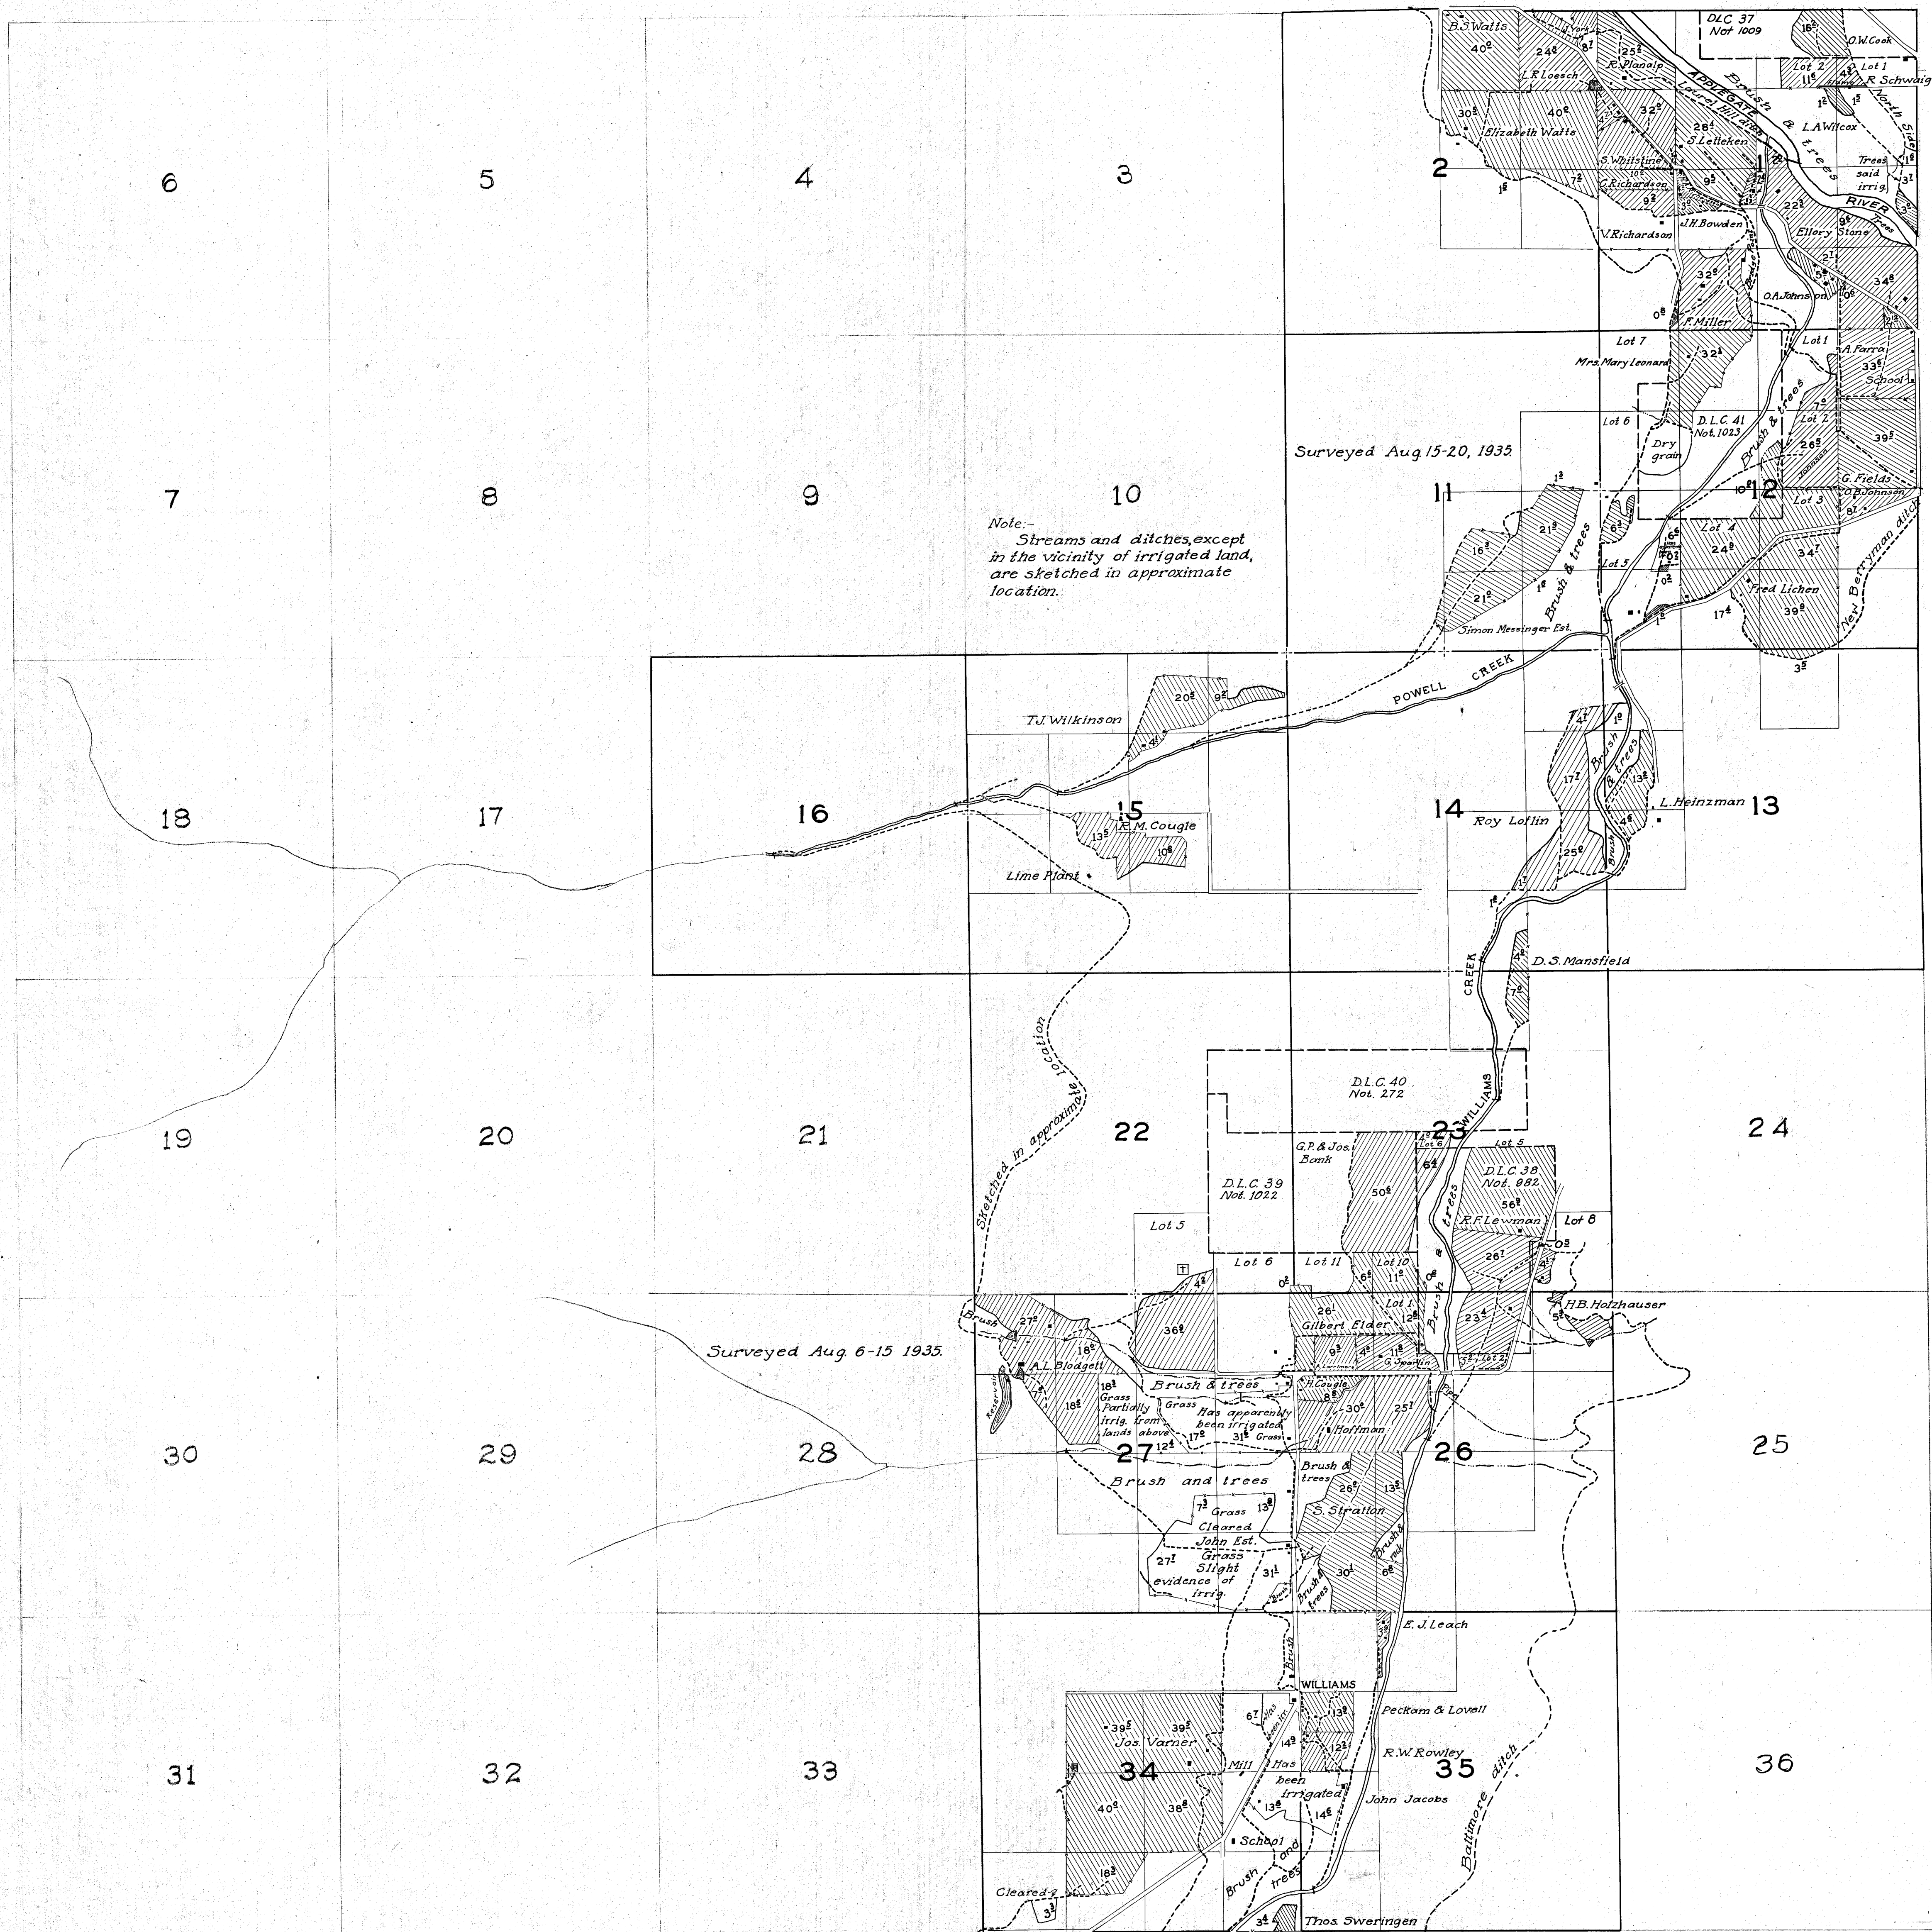

Note: -  
Streams and ditches, except  
in the vicinity of irrigated land,  
are sketched in approximate  
location.

Surveyed Aug 15-20, 1935

Surveyed Aug 6-15 1935