


T38 S., R5 W., W. M.

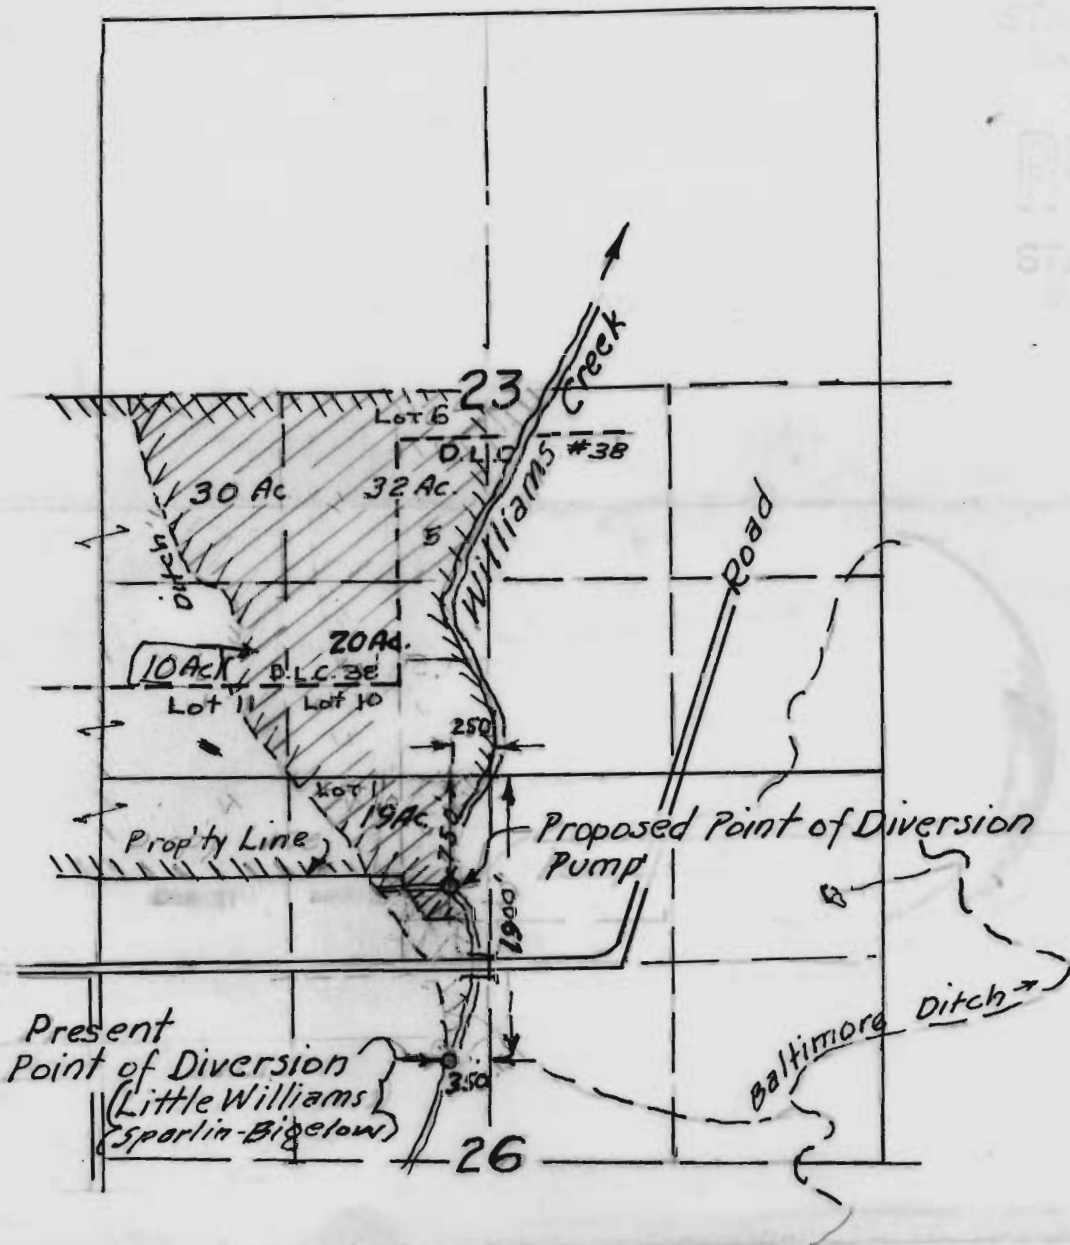

Application for Transfer of Water Right
Fred W. Richards
Josephine County, Oregon
Scale, 4"=1 Mile
Jan. 1958
Tom R. Pearce Engr. #838