


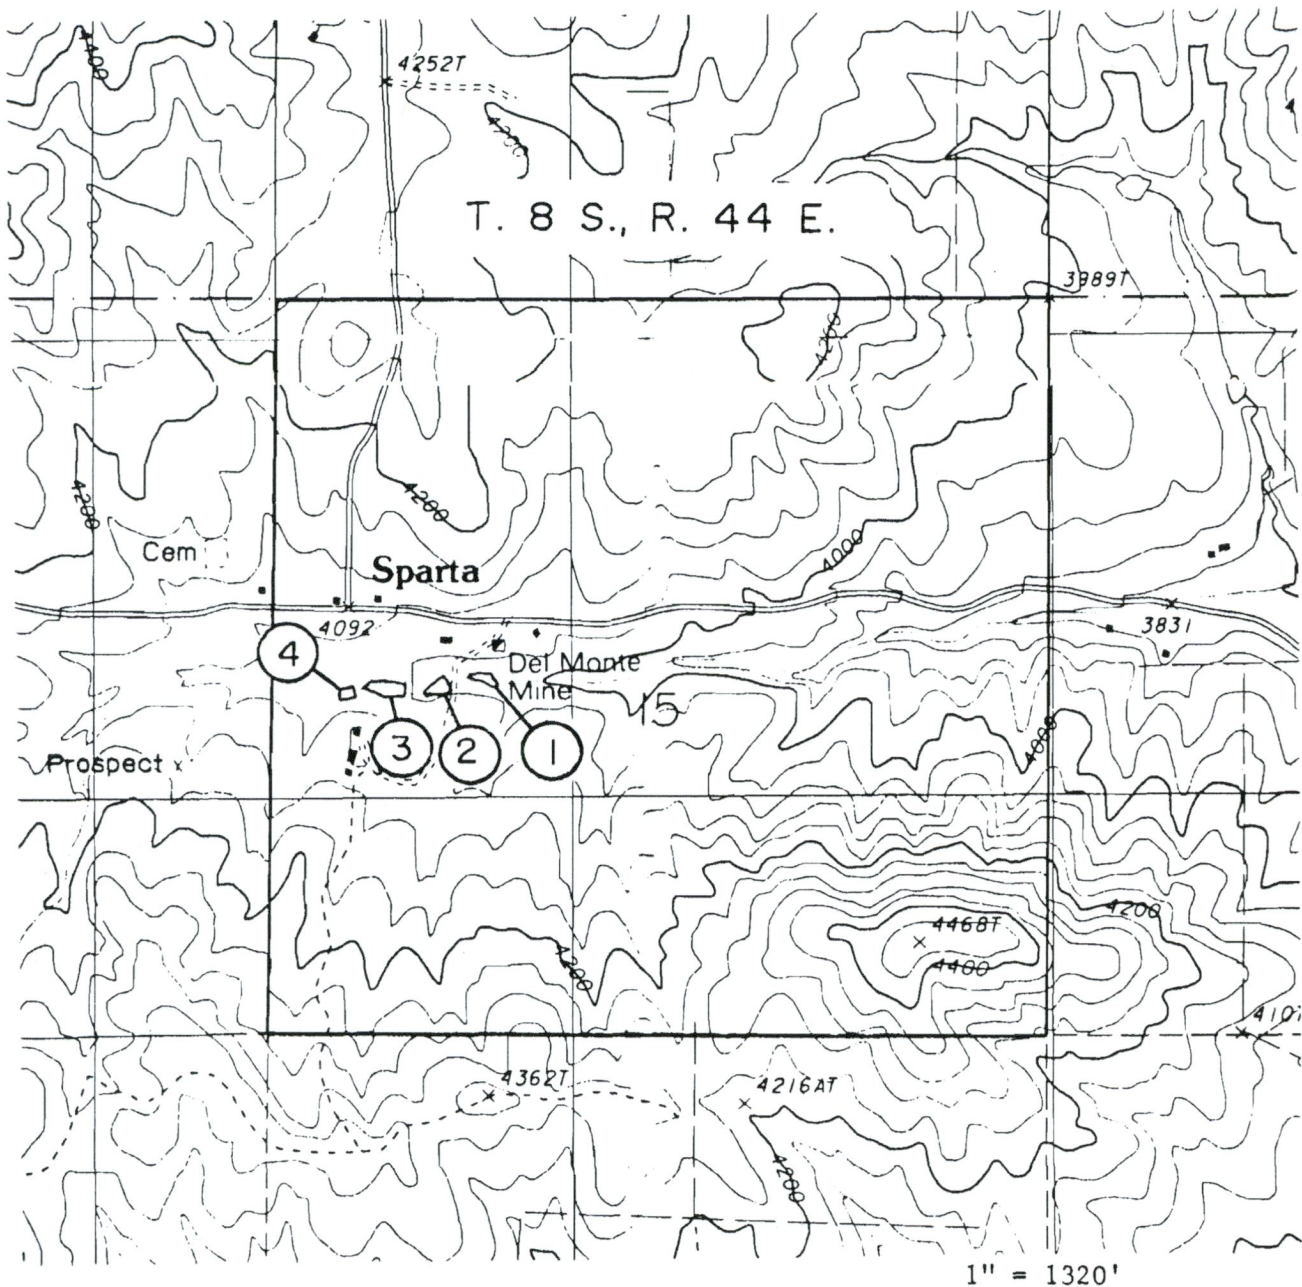

MAP TO ACCOMPANY APPLICATION FOR
PERMIT TO APPROPRIATE WATER

LEGEND

- 1 Reservoir is 2600 feet North and 1500 feet East of the SW cor. Sec. 15
- 2 Reservoir is 2550 feet North and 1150 feet East " " "
- 3 Reservoir is 2500 feet North and 800 feet East " " "
- 4 Reservoir is 2480 feet North and 550 feet East " " "

RECEIVED

JAN - 9 1991

WATER RESOURCES DEPT.
SALEM, OREGON


RECEIVED

JUL 29 2019

OWRD


R11745

John Stansberry, Applicant

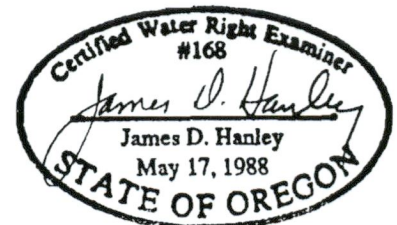

R-88729

2-88729

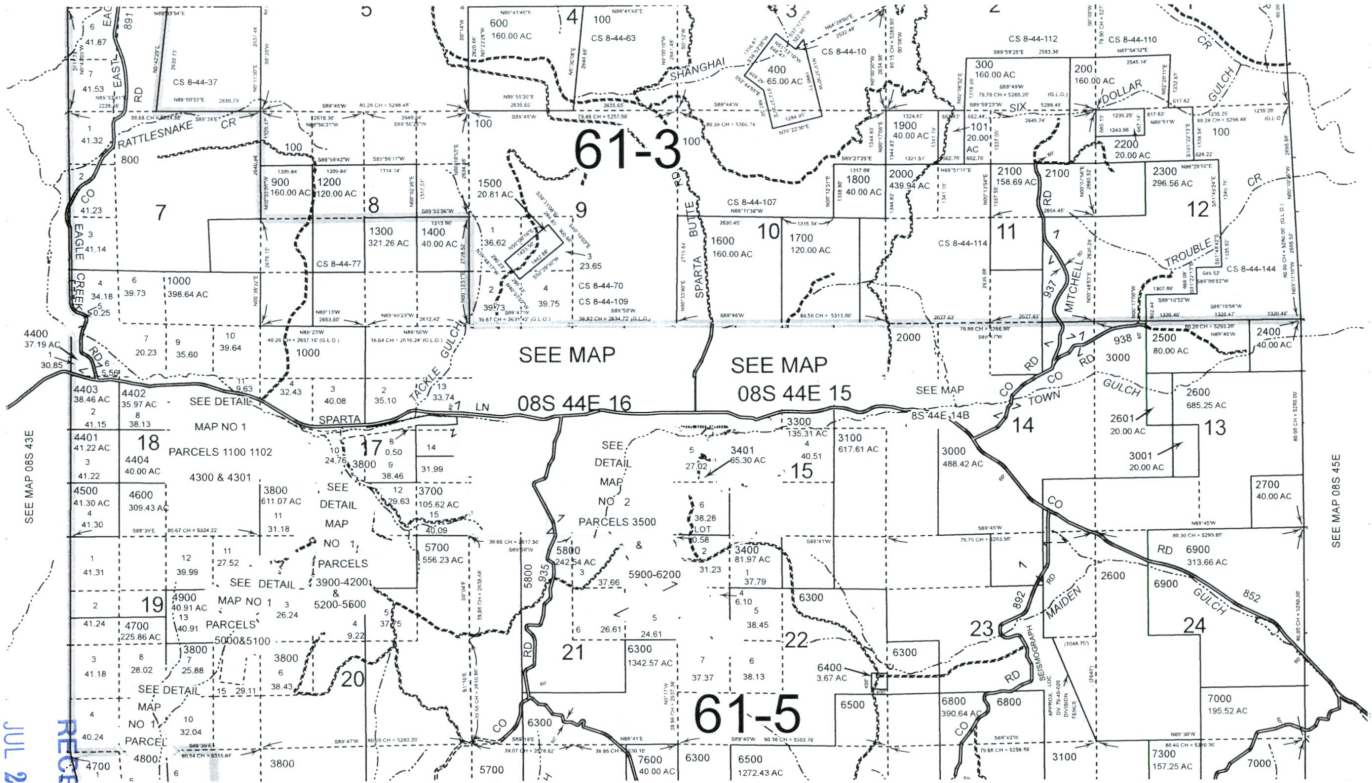

RECEIVED
JUL 29 2019
OWRD