


1" = 1320'


Tax Lot:

RECEIVED

AUG 20 2019

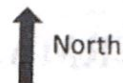

Township 8 South, Range 4 West, Section 33, Tax Lot 601 NESW OWRD

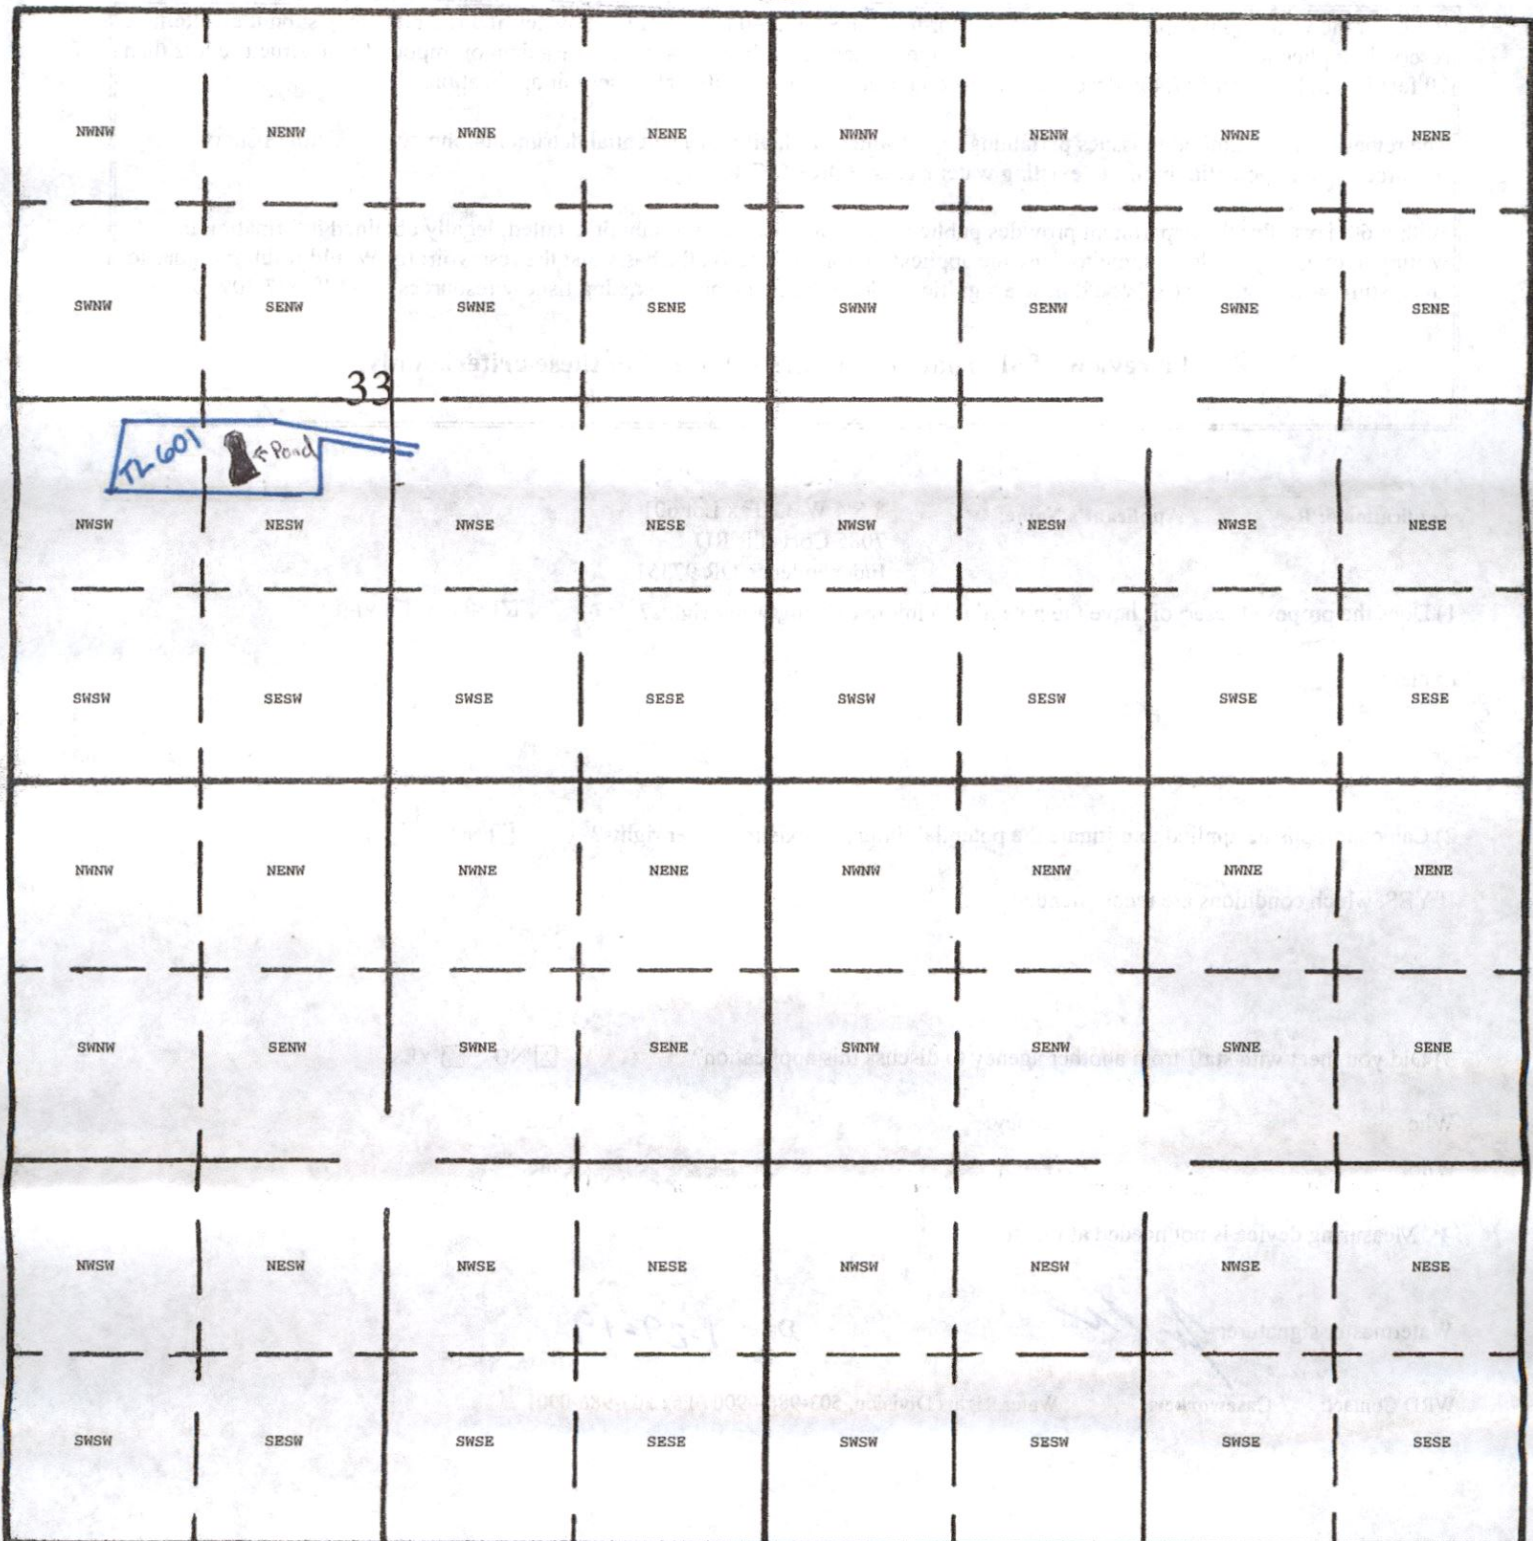


Dam Location: 590 Feet South and 1070 Feet West from Center of Section 33

RECEIVED
AUG 12 2019

OWRD

Security Health
1-29-19

If the diversion involves a dam, use this space for sketches of the diversion (e.g. cross-section of the dam with its dimensions, dimension and placement of outlet pipe, means of passing live flow outside of the authorized storage season, and means for providing fish passage).

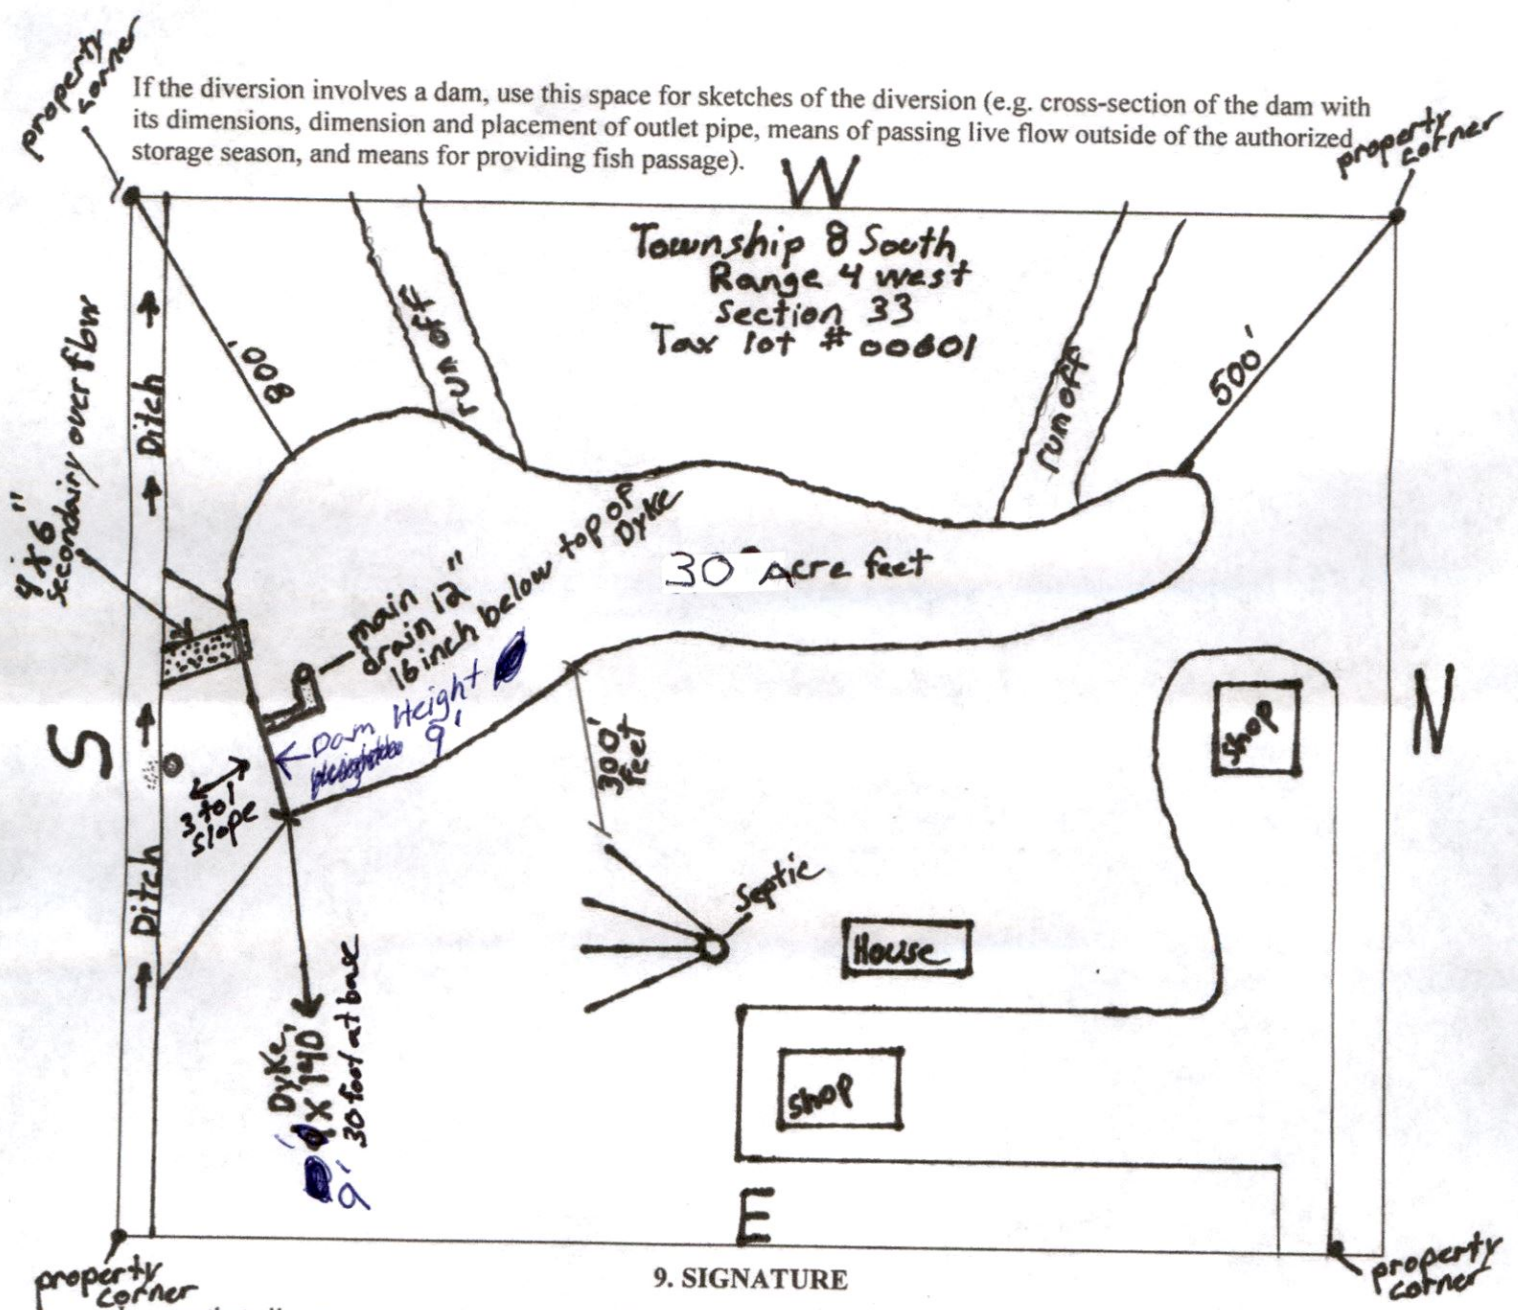

I swear that all statements made and information provided in this application are true and correct to the best of my knowledge.

Jeremiah Heather
Applicant Signature


1-20-2019
Date

Before you submit your application be sure you have:

- Answered each question completely.
- Included a legible map that includes Township, Range, Section, quarter-quarter and tax lot number.
- The map must meet map requirements to be accepted.
- Included a land use form or receipt stub signed by a local planning official.
- Included a check payable to Oregon Water Resources Department for the appropriate amount.

RECEIVED
AUG 12 2019
OWRD

RECEIVED
AUG 20 2019
OWRD

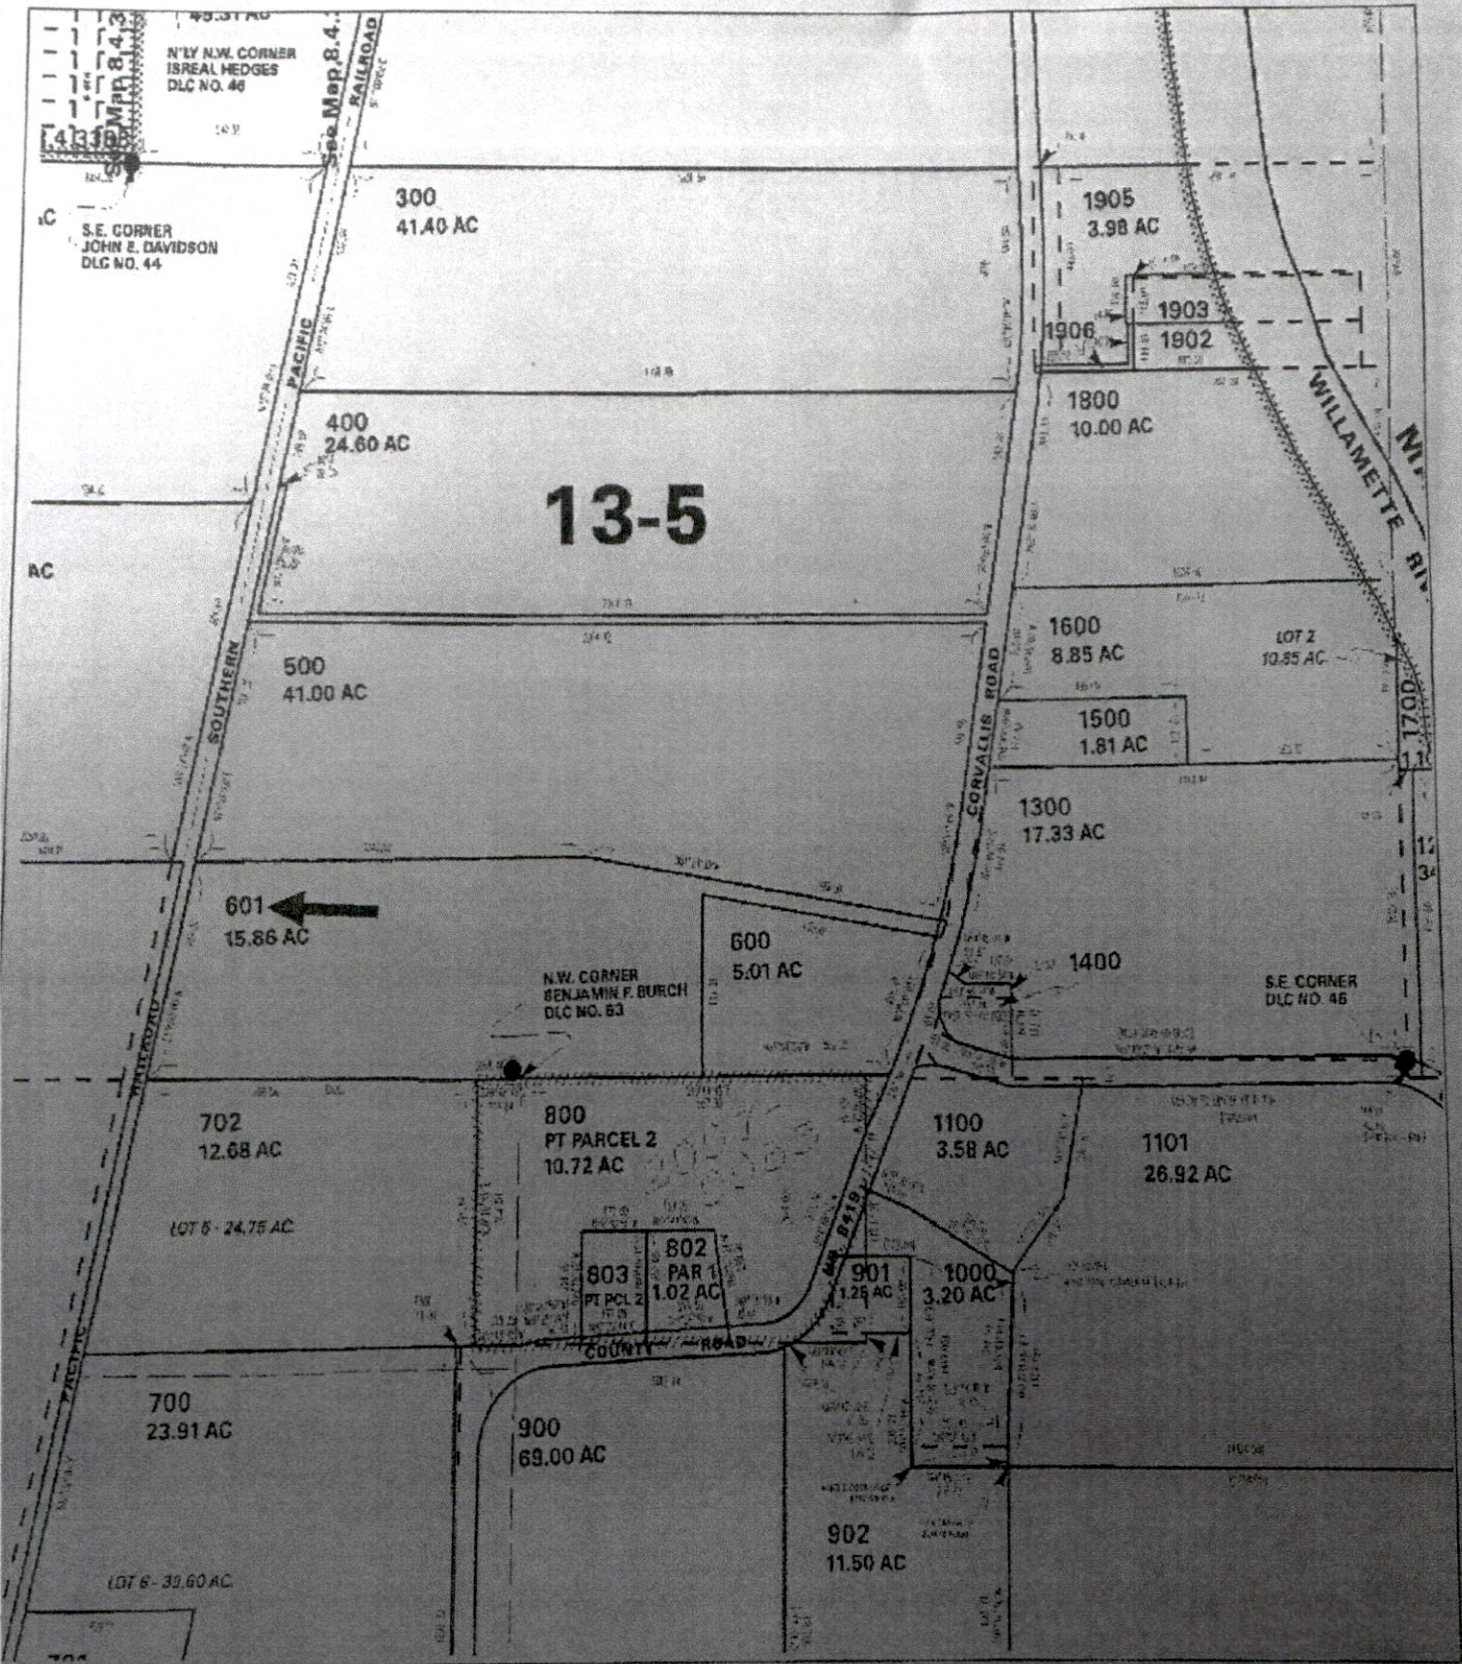

This map/plat is being furnished as an aid in locating the herein described Land in relation to adjoining streets, natural boundaries and other land, not a survey of the land depicted. Except to the extent a policy of title insurance is expressly modified by endorsement, if any, the Company does not warrant dimensions, distances, location of easements, acreage or other matters shown thereon.