


Nance Reservoir ↑ North

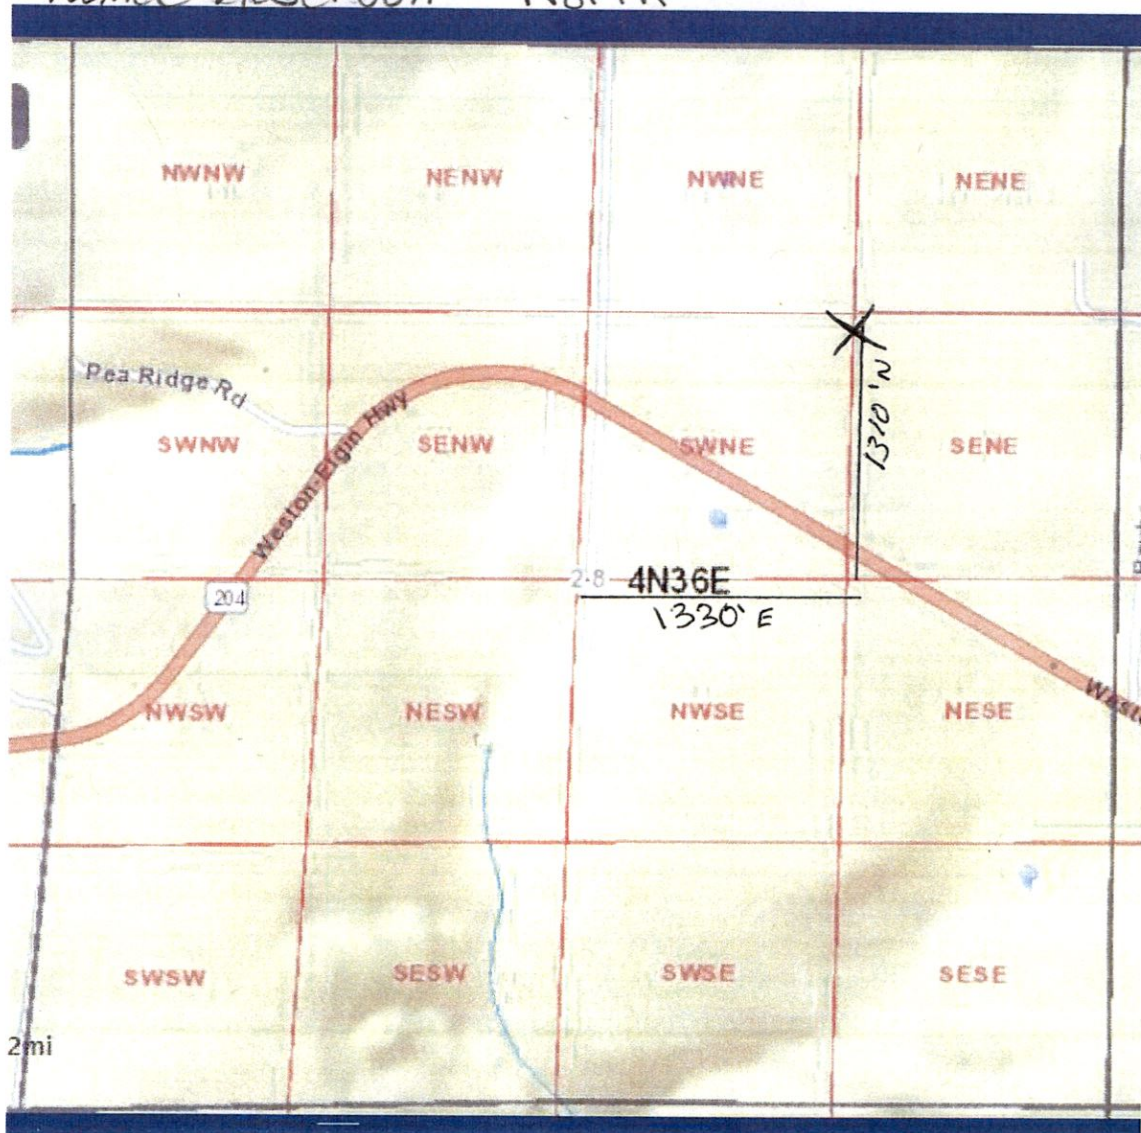

4N 36E Section 28

Scale 1" = 1,000 feet

Tax lot map attached - Tax Lot 2000

1330' E and 1310' N from Center of Section 28

4N 36E Section 28 SENE

X = Reservoir

RECEIVED

AUG 28 2019


OWRD

RECEIVED

AUG 19 2019

OWRD

Nance Reservoir

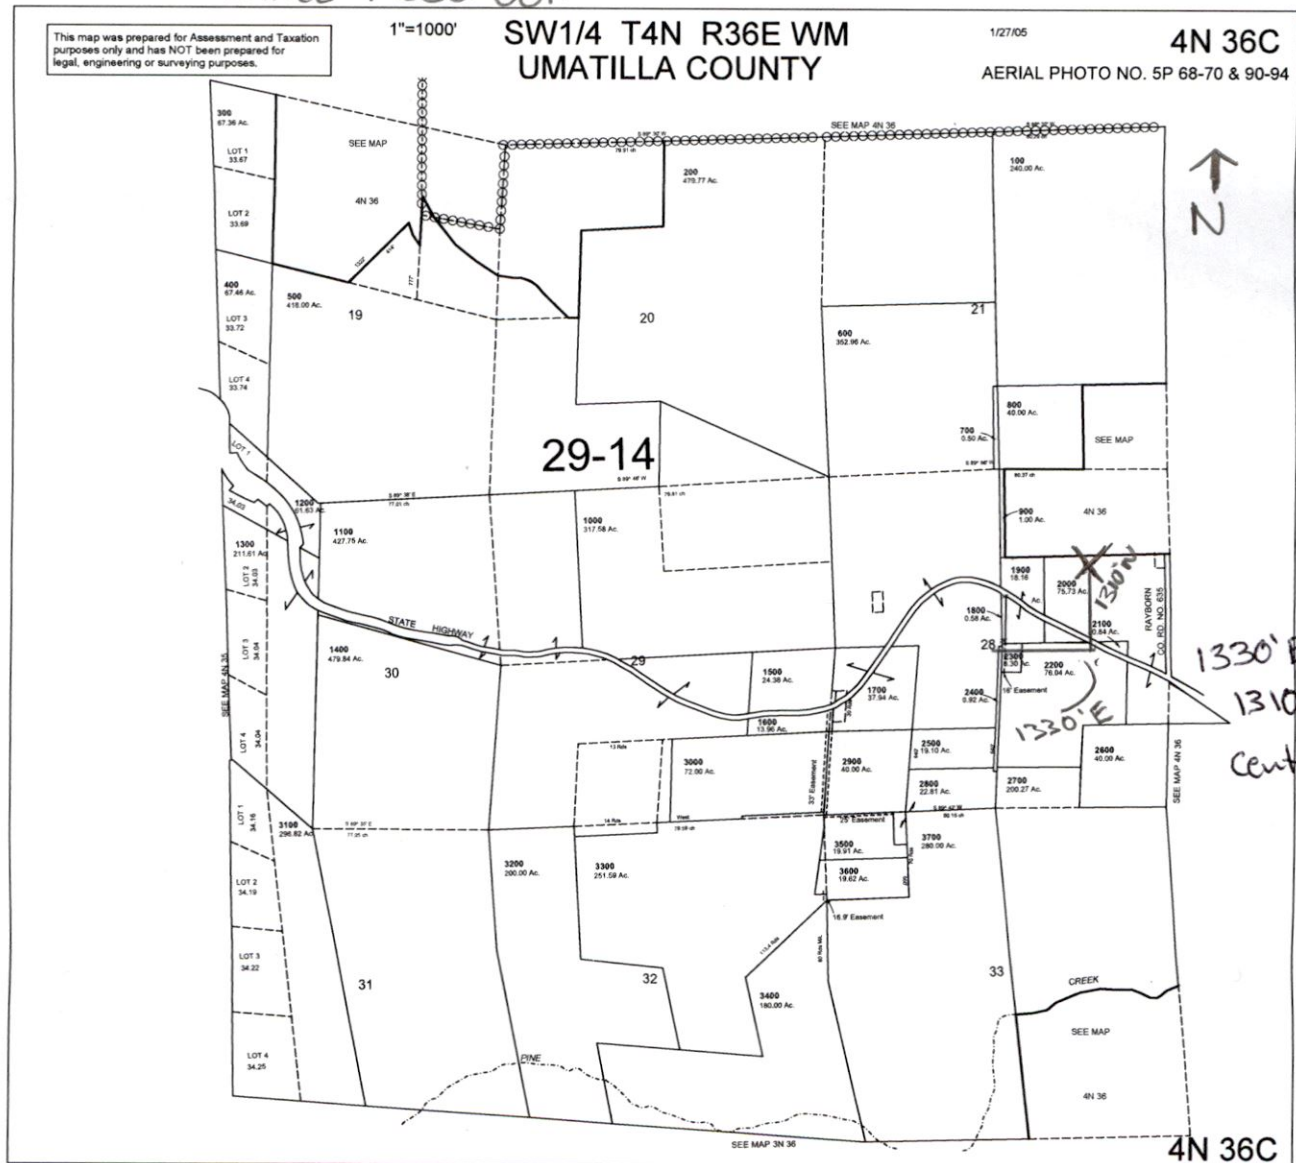

Nance Reservoir

4N 36E Section 28 SENE

1330' E + 1310' N from Center of Section 28

Tax Lot 2000

RECEIVED

AUG 28 2019

OWRD
RECEIVED

AUG 19 2019

OWRD

R-88734