



SEC. 279
T. 38S R. 7W
JOSEPHINE COUNTY

Sump # 2
Superseded



Application No. G-7482
Permit No.

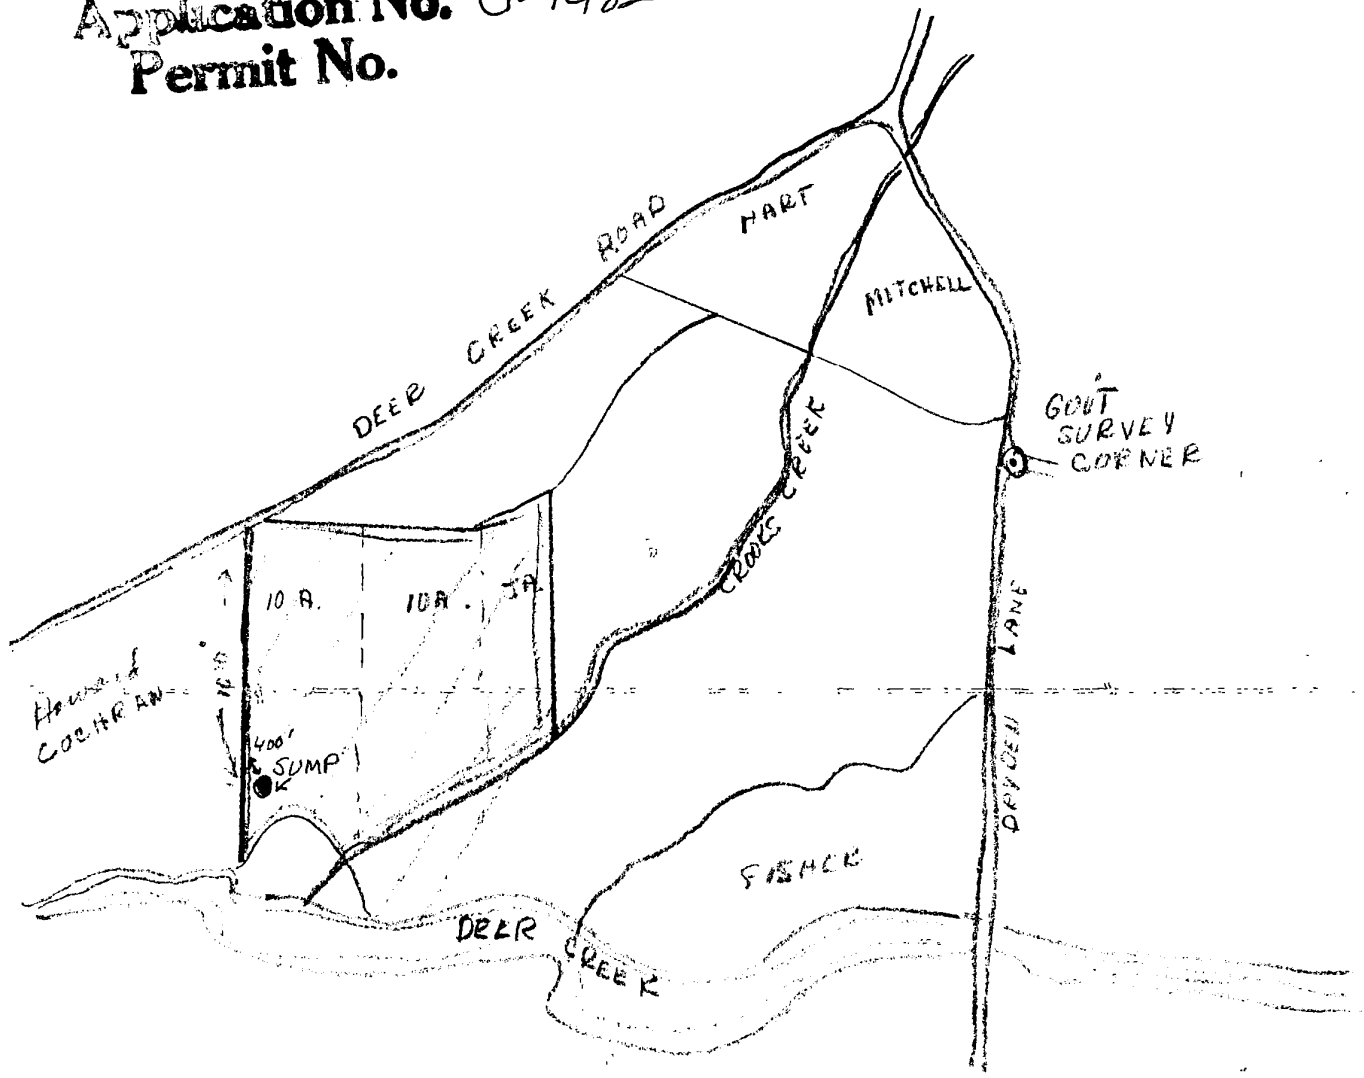

APPROX. 
SCALE 8" = 1 MILE

RAYMOND L. B. [unclear] POST
100 DEER CREEK RD
