


CENTER SECTION 27 T35S R2W

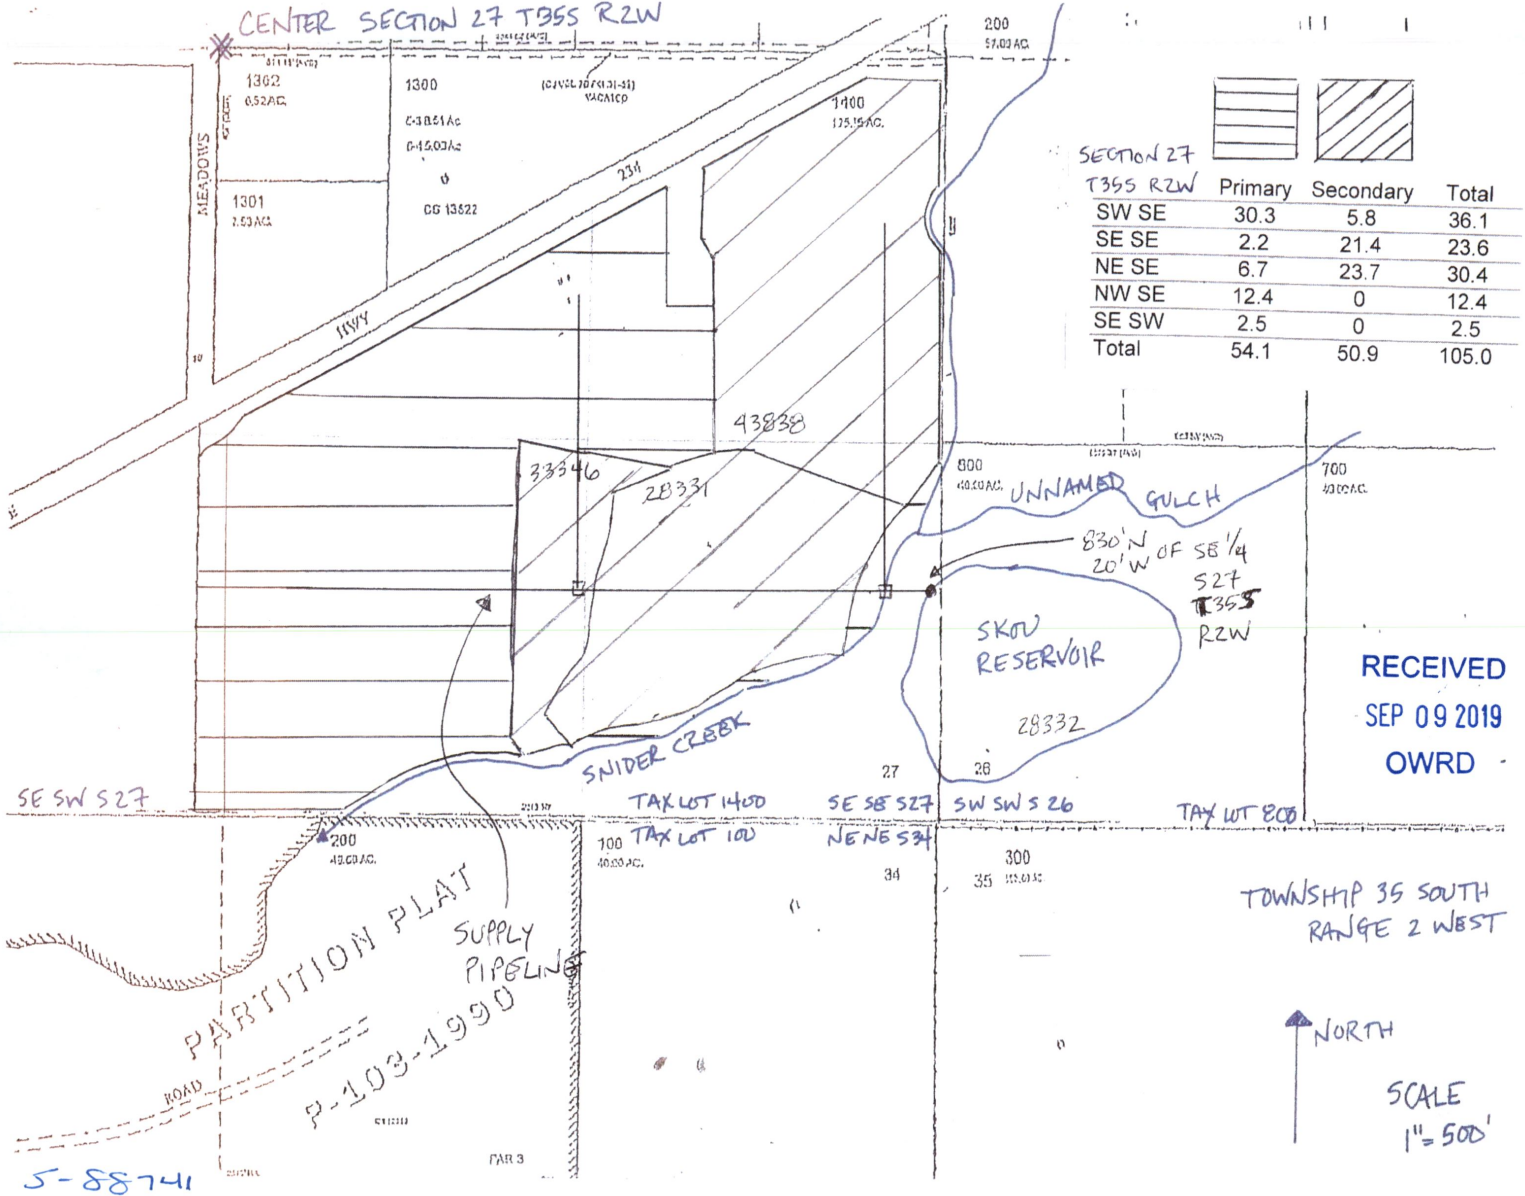

RECEIVED
SEP 09 2019
OWRD