


CENTER SECTION 27 T35S R2W

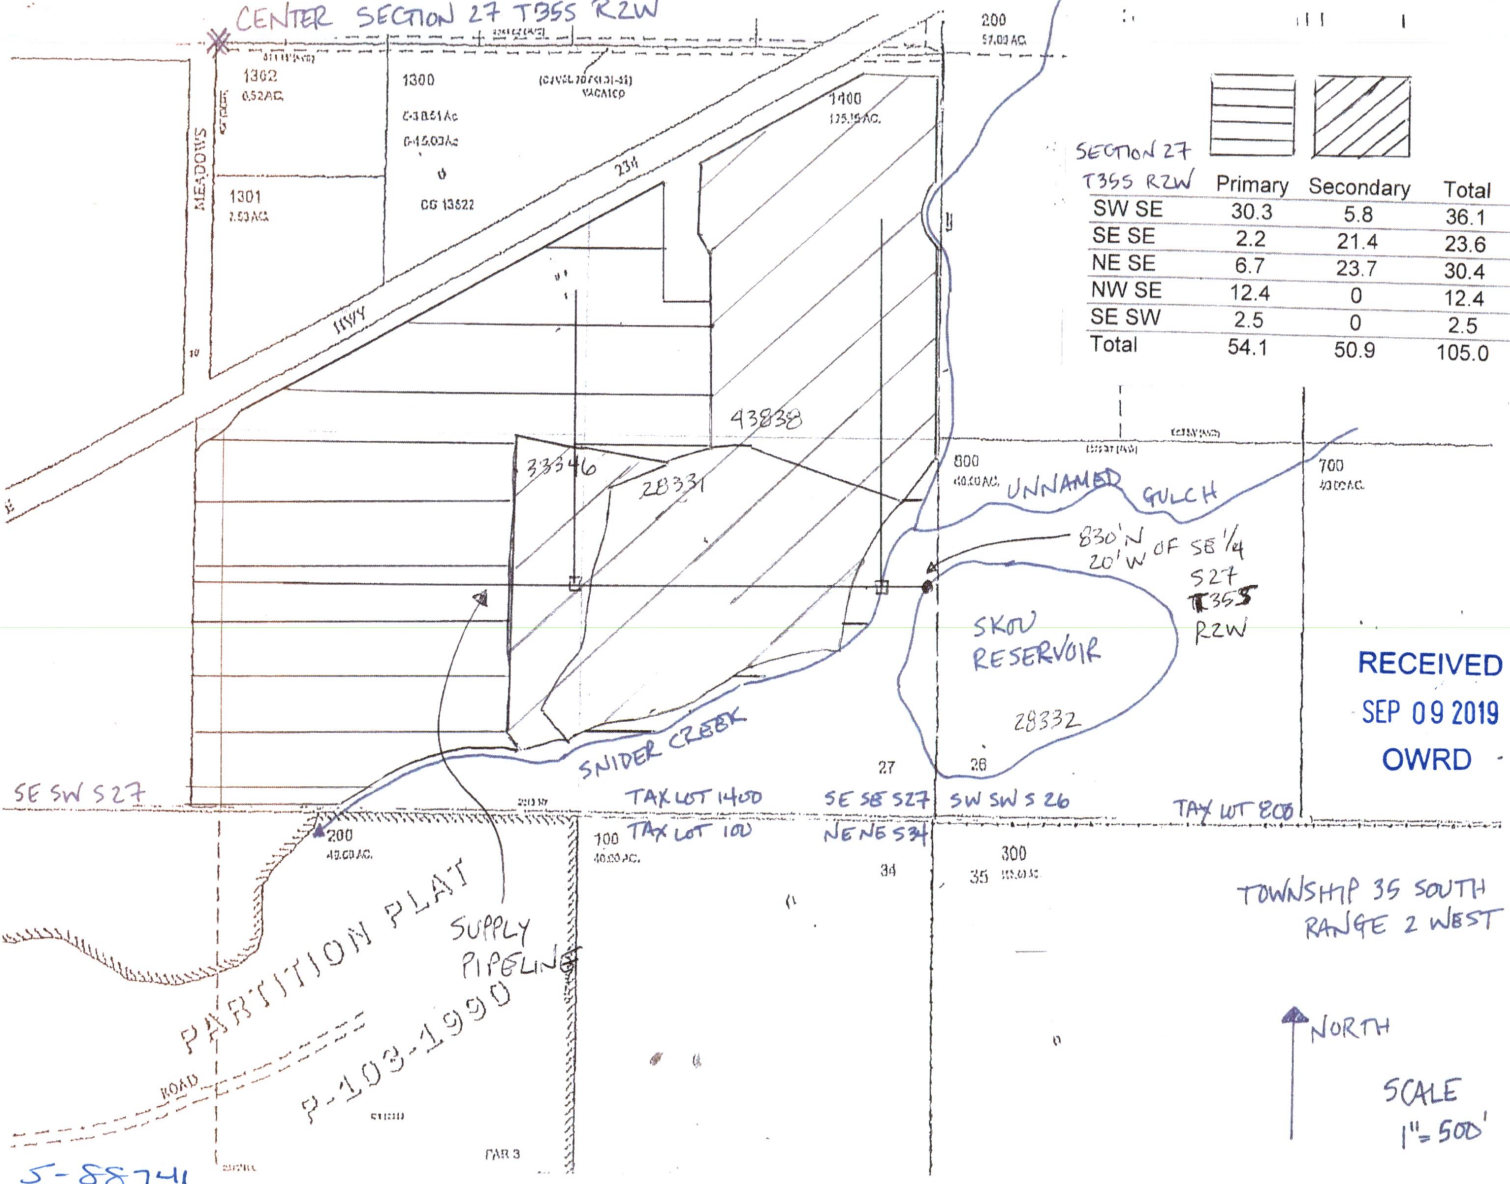

SECTION 27

T35S R2W	Primary	Secondary	Total
SW SE	30.3	5.8	36.1
SE SE	2.2	21.4	23.6
NE SE	6.7	23.7	30.4
NW SE	12.4	0	12.4
SE SW	2.5	0	2.5
Total	54.1	50.9	105.0

RECEIVED
SEP 09 2019
OWRD

TOWNSHIP 35 SOUTH
RANGE 2 WEST

NORTH
SCALE
1" = 500'


5-88741

FOR ASSESSMENT AND TAXATION ONLY

SECTION 27, T.35S., R.2W., W.M.
JACKSON COUNTY
1" = 400'

Work Copy

35 2W 27

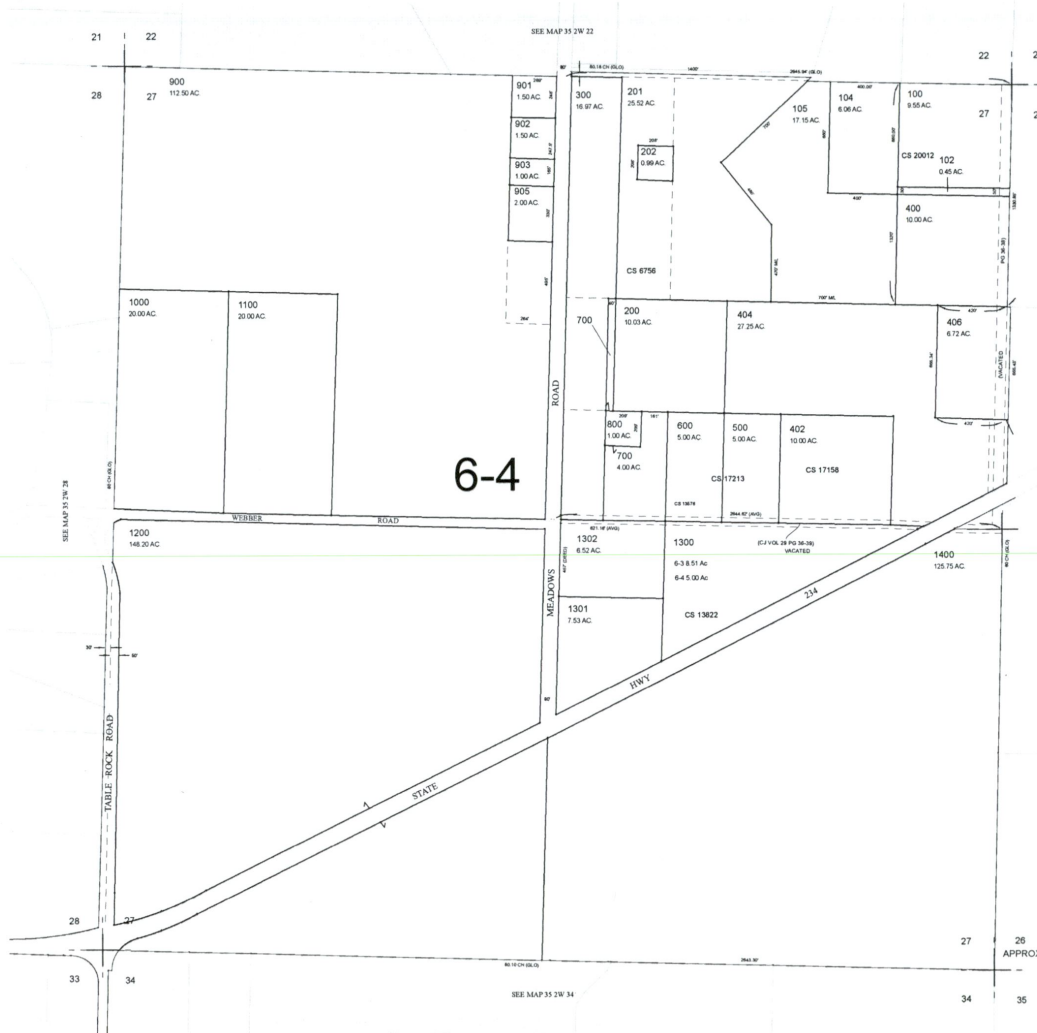

CANCELLED TAX LOT NUMBERS:
101
103
403
405

35 2W 27

DOR CONVERSION MAY 12, 20
REV AUGUST 18, 20