

Abstract of Permit No. G-3620

Application No. G-3843

Certificate No.

Name

Gordon Smith

Address

Box 715 SE 1/4, Elsie St.
Jewell, Oregon 97138

Source of water supply

A well Trib. of Cow Creek

Use

Domestic use of 24 families

Point of diversion

822.99' E. & 1297.2' S. from center Sec. 28, being within NW 1/4 SE 1/4, Sec. 28, T. 5 N., R. 7 W., W. M., county of Clatsop

Number of acres

DESCRIPTION OF LAND TO BE IRRIGATED OR PLACE OF USE

Twp.	Range	Sec.	NE 1/4				NW 1/4				SW 1/4				SE 1/4			
			NE 1/4	NW 1/4	SW 1/4	SE 1/4	NE 1/4	NW 1/4	SW 1/4	SE 1/4	NE 1/4	NW 1/4	SW 1/4	SE 1/4	NE 1/4	NW 1/4	SW 1/4	SE 1/4
2N	7W	28			Dom.				Dom.							Dom.		
					SW NE												Dom	
					SE NW												Dom	
					NW SE												Dom	

Priority date

March 14, 1967

Amount of water

0.2 c.f.s. 0.03

Time limit to begin construction

November 21, 1968

Time limit to complete construction

10-1-69 extended to

extended to

Time limit to completely apply water

10-1-70 extended to

extended to

Remarks:

LOT'S E D L C'S

INFO: Mr. Smith

SOURCE: Well

Well : 20' DEEP dug well
CONC. SLAB COVERS WELL
A WOODEN STRUCTURE COVERS SLAB & PUMP

MOTOR & CENTURY 10 hp

PUMP D.D. CENT 3 1/2" x 2"

PIPE : 1700' 4" PVC THEN DOWN TO 3", THEN TO 2"

USE : DOMESTIC USE FOR 24 FAMILIES
THESE ARE MOSTLY WEEKEND AND SUMMER PLACES


LIFT : 0 to - 20'


TIE : INSPECTION OF APP. MAP.

LOT WITH X USE WATER

9-14-76

C.F. Kew
F.E.

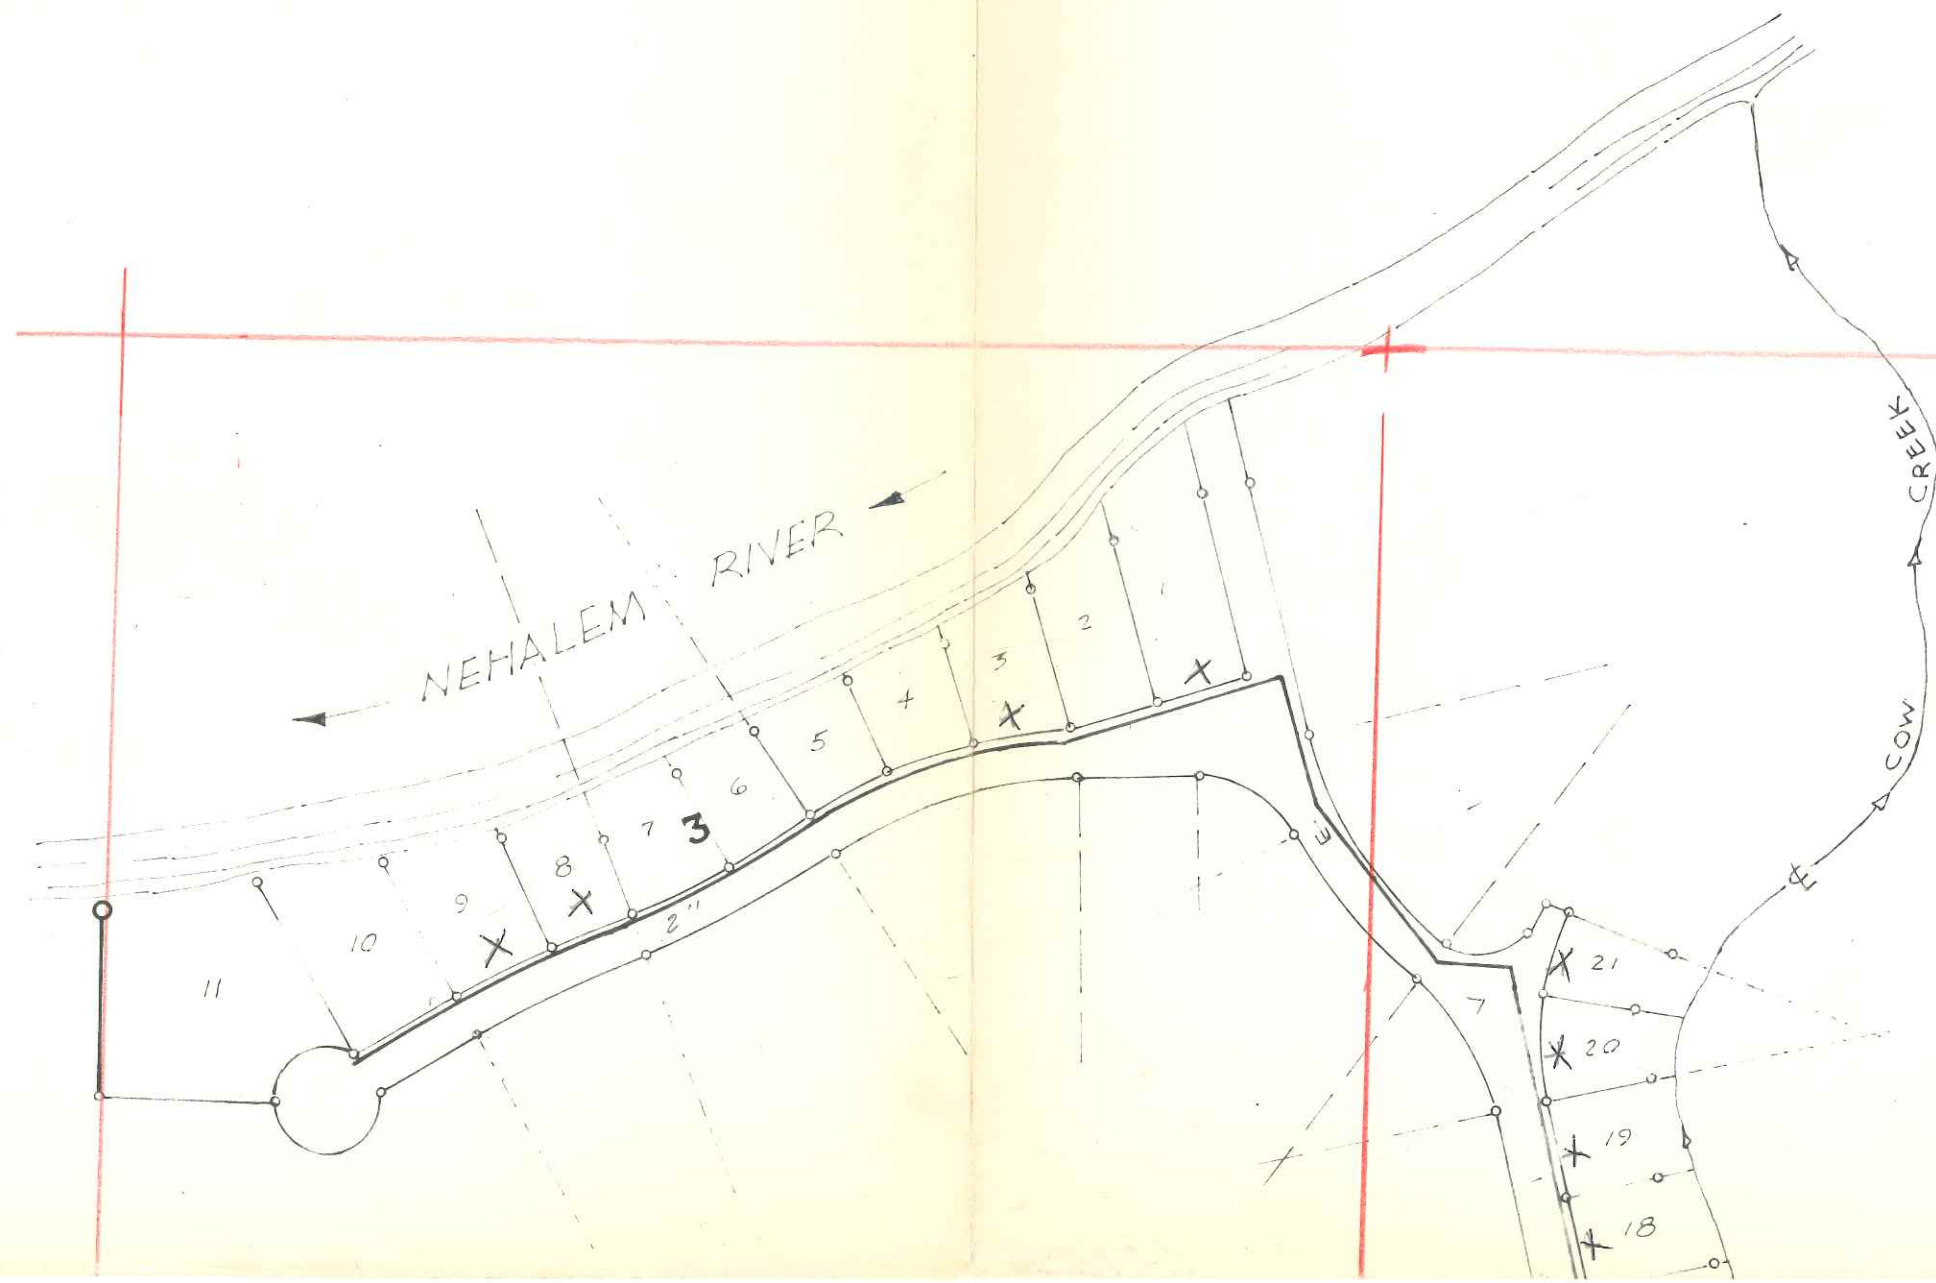

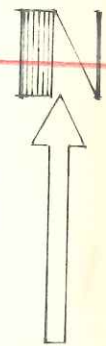

SCALE 1"=200'

EVERGREEN ACRES

BLOCKS 1 THRU 3

SECTION 28 T5N R7W WM

A SUBDIVISION OF RECORD IN
CLATSOP COUNTY, OREGON

DATA PREPARED BY:

GEORGE H. OTTEN & SON
BEAVERTON, OREGON

George Otten

MAR. 1, 1967

1/4 COR. ---
CENTER SEC 28
T5N - R7W.W.M.


822 99--

INITIAL POINT


WELL SITE

DEPTH 20'
SWL 8'
10 hp CENTURY
3 1/2" x 2"

Permit # - G-3620
App # - G-3843

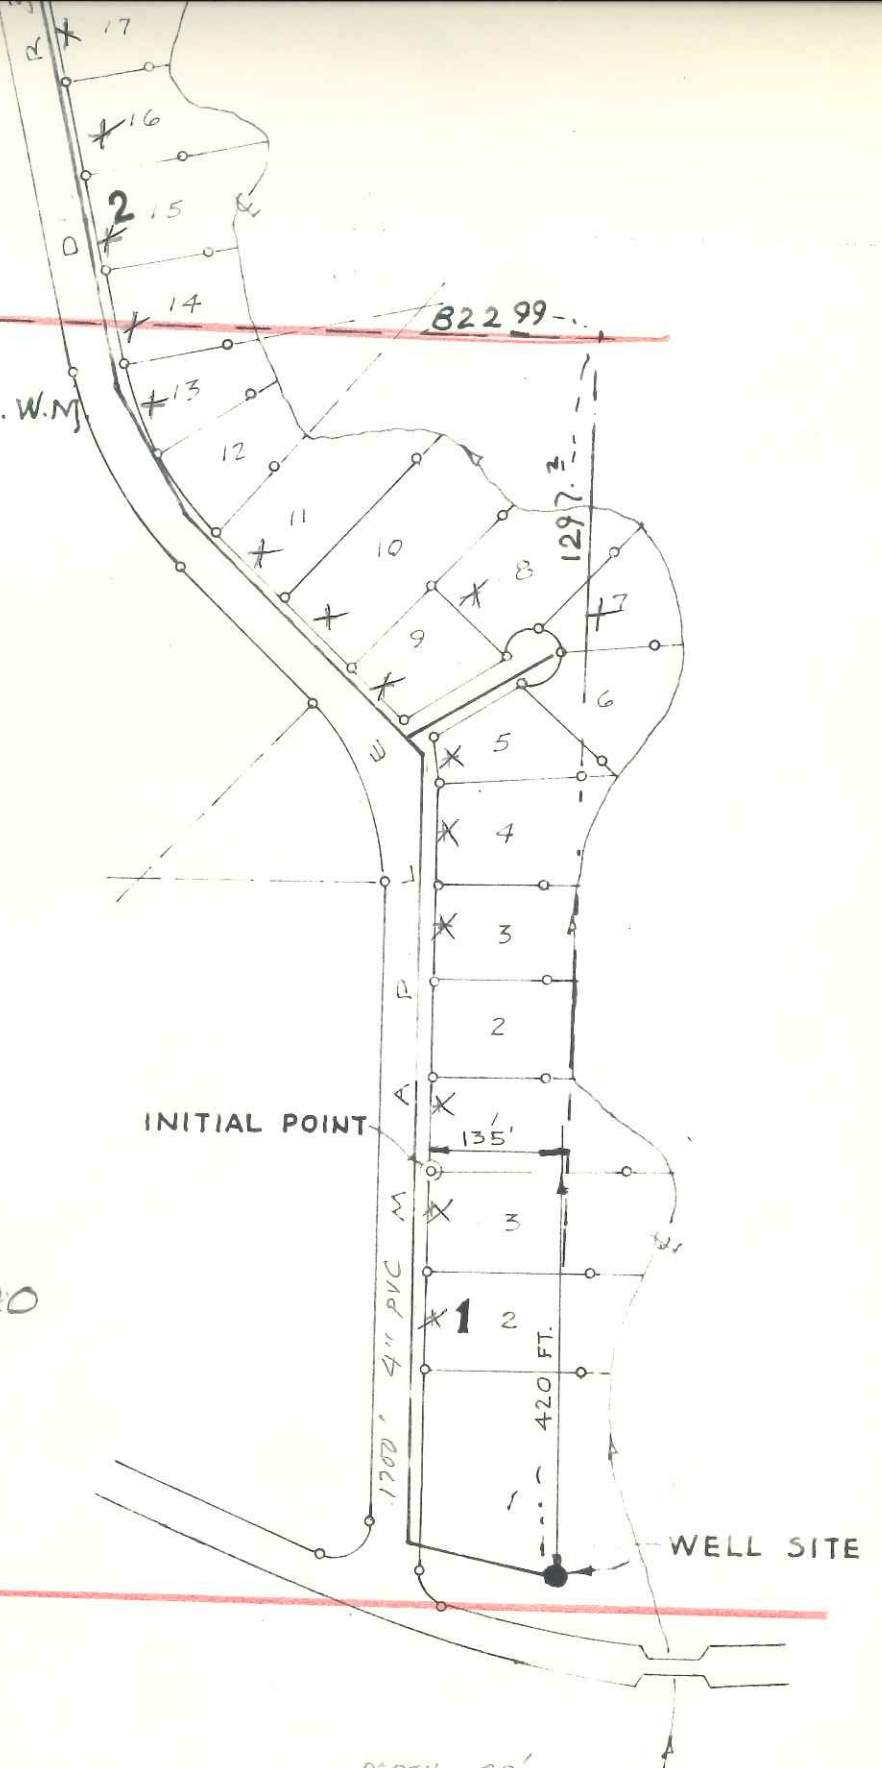

1/4 COR
 CENTER SEC. 28
 N 5N - R 7W WM

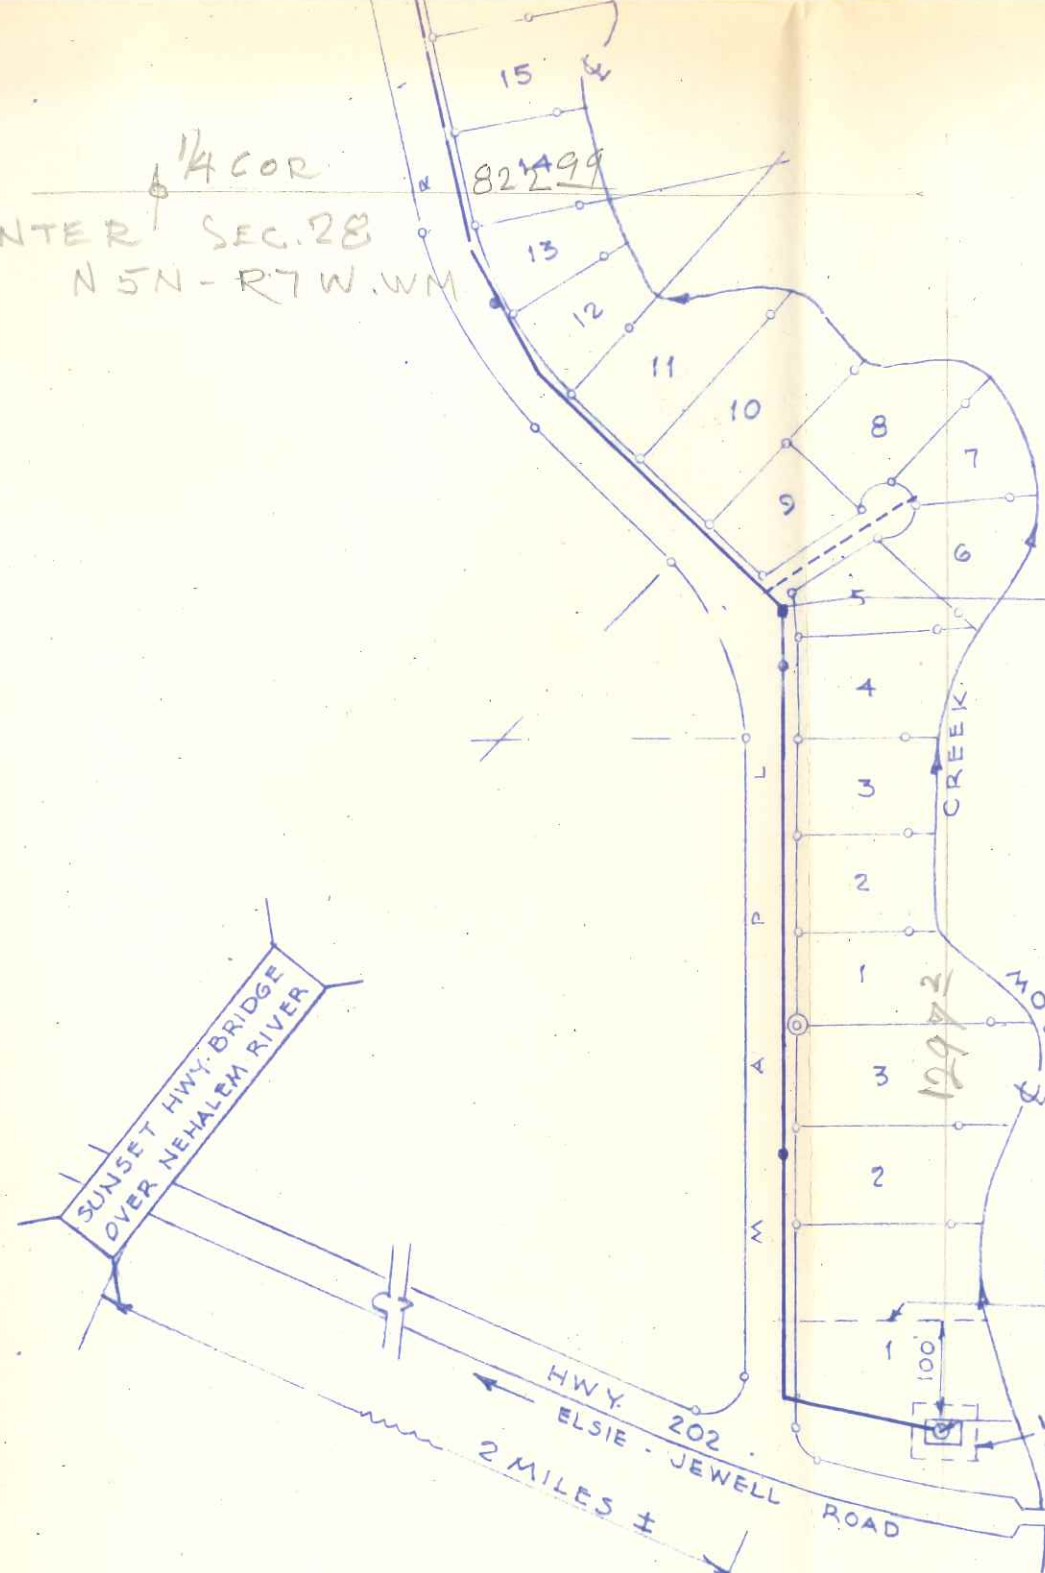

CONCRETE THRUST BLOCKS
 AT ALL PIPE ANGLES

LEGEND:

- 4" CARLON PVC #40
- 3" " " "
- 2' " " "
- 2" SP 2" STAND PIPE

NOTE:

NO SEWAGE DISPOSAL
 CLOSER THAN 100 FT.

EVERGREEN ACRES
 SECT. 28 T5N R7W WM - CLATSOP CO.



1" = 200'

Application No. G-3843
 Permit No.

MARCH 3, 1967



GEORGE H. OTTEN & SON
 ENGINEERS
 P.O. BOX 213 - BEAVERTON