

WATERMASTER DISTRICT NO. 15
COUNTY COURTHOUSE
ROSEBURG 97470
TEL. 672-3311



STATE OF OREGON
STATE ENGINEER
WATER RESOURCES DEPARTMENT

March 20, 1967

WATER DISTRIBUTION
HYDROGRAPHIC SURVEYS
SNOW SURVEYS

REFER TO 18025
FILE NO. 28074

Chris L. Wheeler
State Engineer
516 Public Service Building
Salem, Oregon 97310

RECEIVED
MAR 22 1967
STATE ENGINEER
SALMON

Attention: Marvin B. Bennett, Assistant

Dear Mr. Bennett:

I am currently plotting the water rights in my district on assessor maps. I believe I have found two rights covering the same lands.

Application #18025, Permit #13694, Certificate #137⁸⁰60 is for the irrigation of 0.1 acres in the NE $\frac{1}{4}$ NW $\frac{1}{4}$, 0.4 acres in the SW $\frac{1}{4}$ NW $\frac{1}{4}$, and 9.5 acres in the SE $\frac{1}{4}$ NW $\frac{1}{4}$. There was a final proof map made for this right July 10, 1940.

Application #28074, Permit #23104, Certificate #27514 is for the irrigation of 4.7 acres in the SE $\frac{1}{4}$ NW $\frac{1}{4}$ and 7.2 acres in the SE $\frac{1}{4}$ NW $\frac{1}{4}$. The map was prepared from data furnished by the applicant. No survey was made by our office.

It is possible that these rights lie on the same land. Even if they do not, there is a definite overlap indicated by the maps sent me.

What would be the best way to correct this situation. I believe there should not be any overlapping of water rights.


Enclosed is a map (copied from an assessor map) of the two rights.

Yours truly,

M. John Youngquist
Watermaster, Dist. 15

MJY:emb
Incls. 1 map

WATERMASTER DISTRICT NO. 15
COUNTY COURTHOUSE
ROSEBURG 97470
TEL. 672-3311

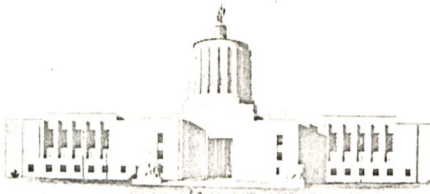

STATE OF OREGON
STATE ENGINEER
WATER RESOURCES DEPARTMENT

March 20, 1967

WATER DISTRIBUTION
HYDROGRAPHIC SURVEYS
SNOW SURVEYS

REFER TO FILE NO. 18025

Chris L. Wheeler
State Engineer
516 Public Service Building
Salem, Oregon 97310

RECEIVED
MAR 22 1967
STATE ENGINEER
SALMON

Attention: Marvin B. Bennett, Assistant

Dear Mr. Bennett:

I am currently plotting the water rights in my district on assessor maps. I believe I have found two rights covering the same lands.

Application #18025, Permit #13694, Certificate #13760⁸⁰ is for the irrigation of 0.1 acres in the NE $\frac{1}{4}$ NW $\frac{1}{4}$, 0.4 acres in the SW $\frac{1}{4}$ NW $\frac{1}{4}$, and 9.5 acres in the SE $\frac{1}{4}$ NW $\frac{1}{4}$. There was a final proof map made for this right July 10, 1940.

Application #28074, Permit #23104, Certificate #27514 is for the irrigation of 4.7 acres in the SE $\frac{1}{4}$ NW $\frac{1}{4}$ and 7.2 acres in the SE $\frac{1}{4}$ NW $\frac{1}{4}$. The map was prepared from data furnished by the applicant. No survey was made by our office.

It is possible that these rights lie on the same land. Even if they do not, there is a definite overlap indicated by the maps sent me.

What would be the best way to correct this situation. I believe there should not be any overlapping of water rights.

Enclosed is a map (copied from an assessor map) of the two rights.

Yours truly,


A handwritten signature in cursive script, appearing to read "M. John Youngquist".

M. John Youngquist
Watermaster, Dist. 15

MJY:emb
Incls. 1 map

T 265 R6W. W.M.

RECEIVED
MAR 22 1967
STATE ENGINEER
SALEM OREGON

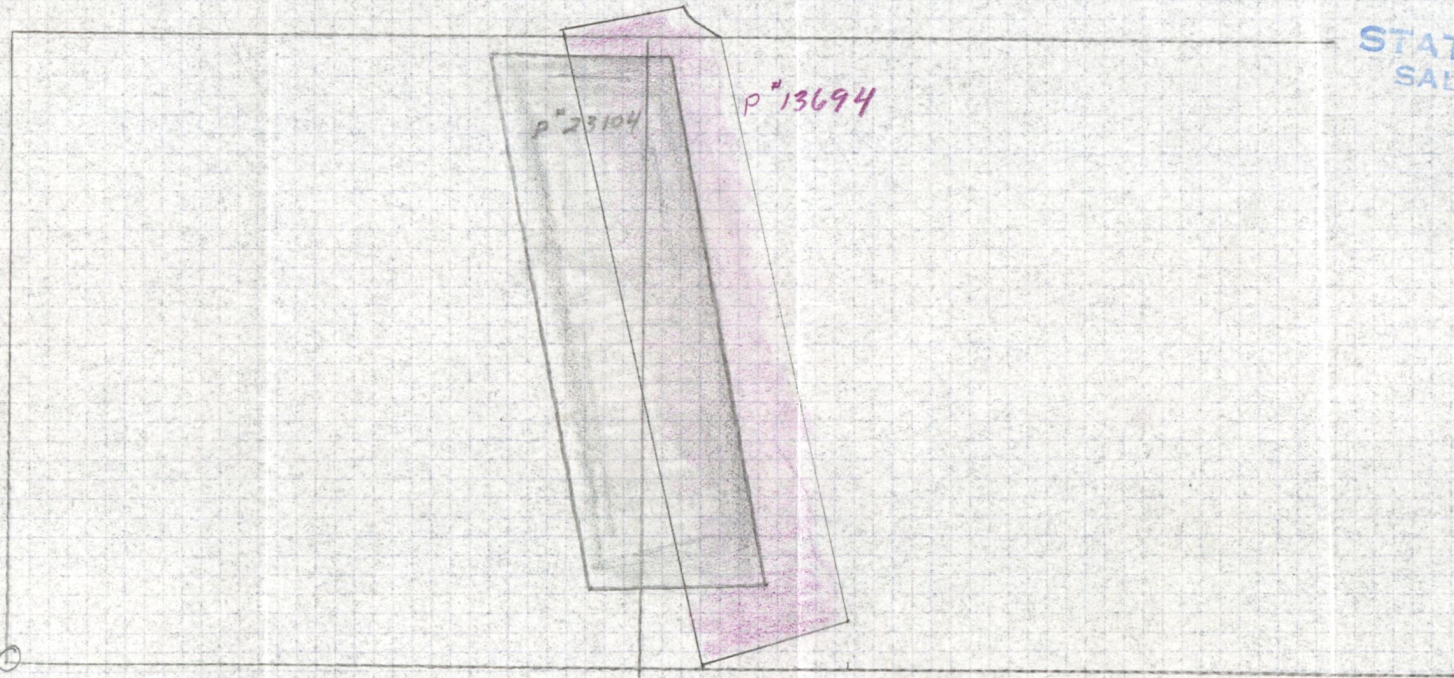

W 1/4 cor.
Sec 33