

Polk County Map



	City Limits		Taxlots
	Urban Growth Boundaries		

R-88740

RECEIVED

SEP 04 2019

OWRD

RECEIVED

AUG 22 2019

OWRD

Date: 8/19/2019



This map was produced from the Polk County geographic databases to support its governmental activities. This product is for informational purposes and may not have been prepared for, or be suitable for legal, engineering, or surveying purposes. The county is not responsible for any map errors, possible misuse, or misinterpretation. To report a map error, please call (503)623-0713.

Riddle Farms

1" = 1320'

Tax Lot:

Township 8 South, Range 5 West, Section 13 & 24, Tax Lot 600

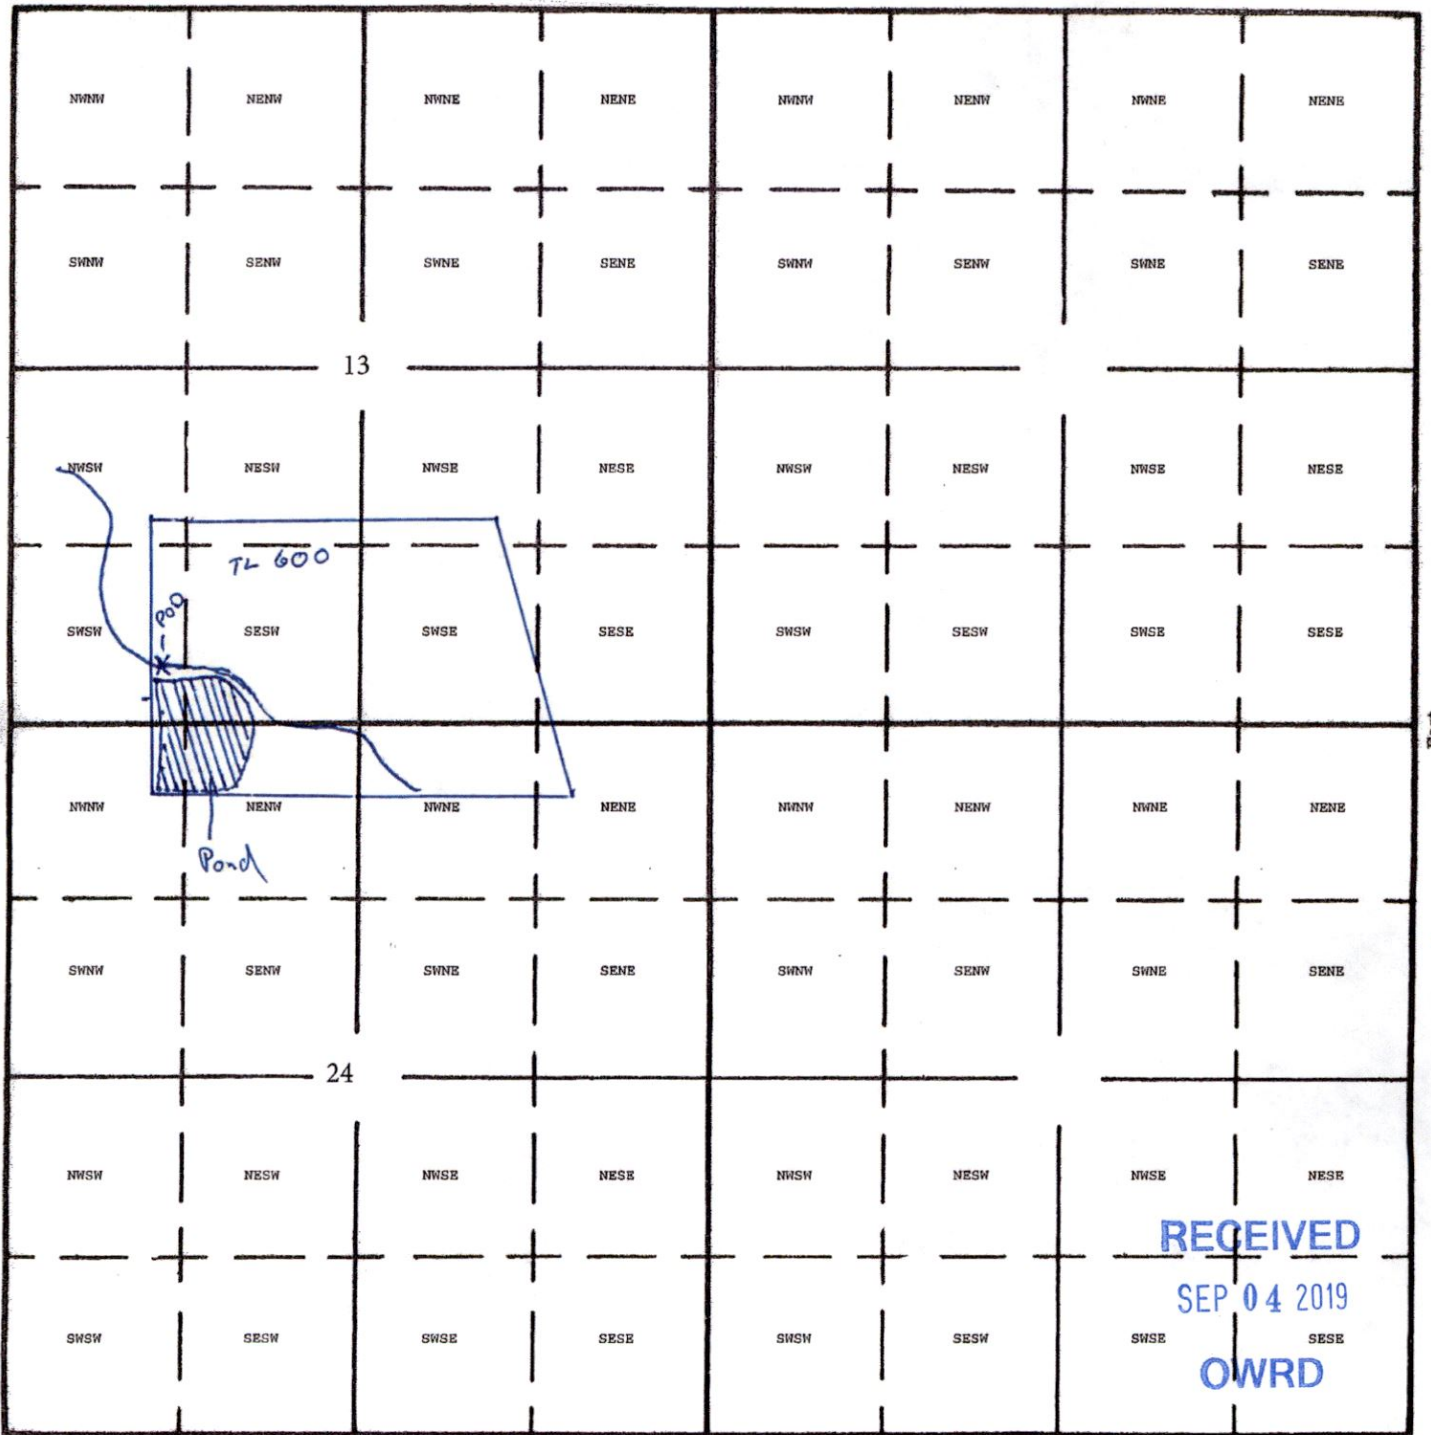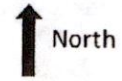

RECEIVED

SEP 04 2019

OWRD

POD: 1150 East 400 North from SW corner Sec 13
POD:

RECEIVED
AUG 22 2019
OWRD

R-88740