



Oregon Water Resources Department
 725 Summer Street NE, Suite A
 Salem, Oregon 97301
 (503) 986-0900
 www.wrd.state.or.us

Request for Assignment

If the Department determines that the application is incomplete, fees have not been paid, or the required documents are not acceptable, the application and all fees submitted will be returned to the applicant.

If for multiple rights, a separate form and fee for each right will be required.

I, Earl Van V. Thompson
 (Name of Current Holder of Record)
5295 Davis St SE Sumner OR 97392 5035880896
 (Mailing Address) (City) (State) (Zip) (Phone #)

- hereby assign all my interest in and to the entire application/permit/transfer/limited license/groundwater statement; (example, sold all the land authorized under the right)
- hereby assign all my interest in and to a portion of application/permit/transfer/limited license/groundwater statement; *(You must include a map showing the portion of the application/permit/transfer order/limited license/groundwater statement to be assigned. Example, sold a portion of the land authorized under the right)*
- hereby assign a portion of my interest in and to the entire application/permit/transfer/limited license/groundwater statement; (example, adding an additional person)

Application # 6-12961 ; Permit # ~~6~~ 6-77487 Transfer # _____ ;
 Limited License # _____ ; Groundwater Statement # _____

as filed in the office of the Water Resources Director, to:

Kay and Robert Freund
 (Name of New Owner)
3535 Vitae Springs Rd S, Salem OR 97306 512-789-2671
 (Mailing Address) (City) (State) (Zip) (Phone #)

Note: If there are other owners of the property described in the application, permit, transfer order, limited license, or groundwater statement, you must provide a list of all other owners' names and mailing addresses and attach it to this form. Write the initials (first letters) of your first and last names at the spot indicated below _____.

_____ I hereby certify that I have notified all other owners of the property described in this application, permit, transfer order, limited license, or groundwater statement of this Request of Assignment.

Witness my hand this 10th day of September, 2019.
 (Day) (Month) (Year)

Signature of Current Holder of Record Earl Van V. Thompson

Failure to provide any of the required information will result in the return of your application.

part. assign. - approve
 [Signature] 9-23-19

This certifies assignment and record change at Oregon Water Resources Department effective 8:00 a.m. on date of receipt at Salem, Oregon.
 Fee receipt # 130799
 For Director by Mary F. Bjork, Program Analyst in Water Rights Division. [Signature]

The completed "Request for Assignment" form *must* be submitted to the Department along with the recording fee of \$100.

RECEIVED



SEP 12 2019

OWRD

T8S, R3W, S18 SE & SW
Permit # G-17487
Earl Van Volkinburg

Wells from S 1/4 Corner of Section 18
Well 1 is located 525'N & 820'W
Well 2 is located 1450'N & 175'W

1" = 1320'
N ↑

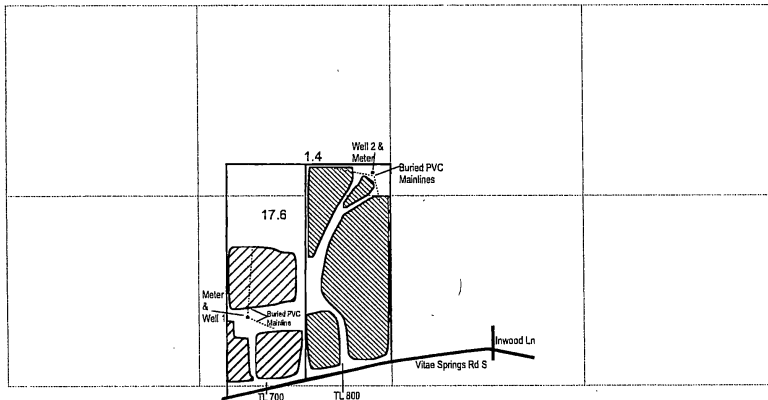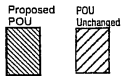

RECEIVED

SEP 12 2019

OWRD