



Oregon Water Resources Department
 725 Summer Street NE, Suite A
 Salem, Oregon 97301
 (503) 986-0900
 www.wrd.state.or.us

Ownership Update For Certificated Rights Only

NO FEES ARE REQUIRED TO SUBMIT THIS FORM

NOTICE: A certificate of water right typically stays with the land. In order to track water right ownership, the Department requests that this form be submitted to the Department. **To update multiple rights, a separate form is required for each right.**

If you have any questions about this form, please contact your local watermaster, or call the Water Resources Department at (503) 986-0900.

This form is not for Applications, Permits, Transfers, Groundwater Registrations, or Limited Licenses. To notify the Department of changes in ownership to these types of authorizations, an Assignment is required.

Current Landowner Information

Name: JACK CRAWFORD
 Mailing Address: 35674 ZEPHYR WAY
 City: PLEASANT HILL State: OR Zip: 97455
 Phone (Home): _____ Work: 541-729-2131 Other: _____

Property Description

County: LANE Township: 17 SOUTH Range: 1 Section: 27
 Taxlot Number(s): MAP 17-01-27-00 TL'S 00101, 00102, 00103, 00106
 Street Address of water right property: _____

Water Right Information: Application: R-42579 Permit: R-4833 Certificate #: 31785

Are all the lands associated with this water right owned by the requester? Yes No _____ If No, include a map showing the portion of the right involved.

Name of individual completing this form: JAMES H. BOOKOUT Phone: 210-560-6221

Signature of requestor: [Signature] Date: 8/26/2019

The Department does not change names on certificates. This form will be placed in the file for future reference only. The Department does not provide acknowledgement that this form has been received.

RECEIVED
 OCT 01 2019
 WR
 OWRD

STATE OF OREGON

COUNTY OF LANE

CERTIFICATE OF WATER RIGHT

This Is to Certify, That JACK CRAWFORD

of Route 2, Box 166, Springfield, State of Oregon, has made proof

to the satisfaction of the STATE ENGINEER of Oregon, of a right to store the waters of an unnamed drainageway, tributary of Willamette River, appropriated under application number 41441, permit number 31785

irrigation for the purposes of under Reservoir Permit No. R-4833 of the State Engineer. and that said right to store said waters has been perfected in accordance with the laws of Oregon; that the priority of the right hereby confirmed dates from August 2, 1966

that the amount of water entitled to be stored each year under such right, for the purposes aforesaid, shall not exceed 5.0 acre feet

The reservoir is located in

NE 1/4 NW 1/4 As projected within Storment DLC 40 Section 27 T. 17 S., R. 1 W., W. M.

RECEIVED OCT 01 2019 OWRD

WITNESS the signature of the State Engineer, affixed this date. December 29, 1971

CHRIS L. WHEELER

State Engineer

STATE OF OREGON
COUNTY OF LANE
CERTIFICATE OF WATER RIGHT

This Is to Certify, That JACK CRAWFORD

of Route 2, Box 166, Springfield, State of Oregon, has made proof to the satisfaction of the STATE ENGINEER of Oregon, of a right to the use of the waters of an unnamed drainage way, McKenzie River, and reservoir constructed under application number R-42579, permit number R-4833 a tributary of Willamette River for the purpose of irrigation of 47.7 acres

under Permit No. 31785 of the State Engineer, and that said right to the use of said waters has been perfected in accordance with the laws of Oregon; that the priority of the right hereby confirmed dates from August 2, 1966

that the amount of water to which such right is entitled and hereby confirmed, for the purposes aforesaid, is limited to an amount actually beneficially used for said purposes, and shall not exceed 0.60 cubic foot per second from drainage way and reservoir with any deficiency in the available supply from unnamed drainage way to be made up by appropriation from McKenzie River provided that the total quantity diverted from both sources shall * or its equivalent in case of rotation, measured at the point of diversion from the stream.

The point of diversion is located in the River - Lot 1 (NE $\frac{1}{4}$ SE $\frac{1}{4}$), Section 23, Reservoir and Drain - NE $\frac{1}{4}$ NW $\frac{1}{4}$ as projected within Storment DLC 40, Section 27, T. 17 S., R. 1 W., W. M. Diversion points located below:

The amount of water used for irrigation, together with the amount secured under any other right existing for the same lands, shall be limited to one-eightieth of one cubic foot per second per acre, or its equivalent for each acre irrigated from direct flow and shall be further limited to a diversion of not to exceed $2\frac{1}{2}$ acre feet per acre for each acre irrigated during the irrigation season of each year from direct flow and storage from reservoir constructed under permit number R-4833,

and shall conform to such reasonable rotation system as may be ordered by the proper state officer.
A description of the place of use under the right hereby confirmed, and to which such right is appurtenant, is as follows:

0.1 acre SW $\frac{1}{4}$ SE $\frac{1}{4}$
As projected within Storment DLC 40
Section 22

19.1 acres NW $\frac{1}{4}$ NE $\frac{1}{4}$
23.8 acres NE $\frac{1}{4}$ NW $\frac{1}{4}$
4.7 acres NW $\frac{1}{4}$ NW $\frac{1}{4}$

All as projected within Storment DLC 40
Section 27
T. 17 S., R. 1 W., W. M.

* not exceed 0.60 cubic feet per second.

Diversion points located: Re-diversion from Walterville Canal - 1860 feet East and 180 feet South; Reservoir - 2160 feet East and 460 feet South; both from NW Corner, Section 27.

The right to the use of the water for the purposes aforesaid is restricted to the lands or place of use herein described.

WITNESS the signature of the State Engineer, affixed


this date. December 29, 1971

CHRIS L. WHEELER

State Engineer

RECEIVED
OCT 01 2019
OWRD

T.17 S.R.1W.W.M.

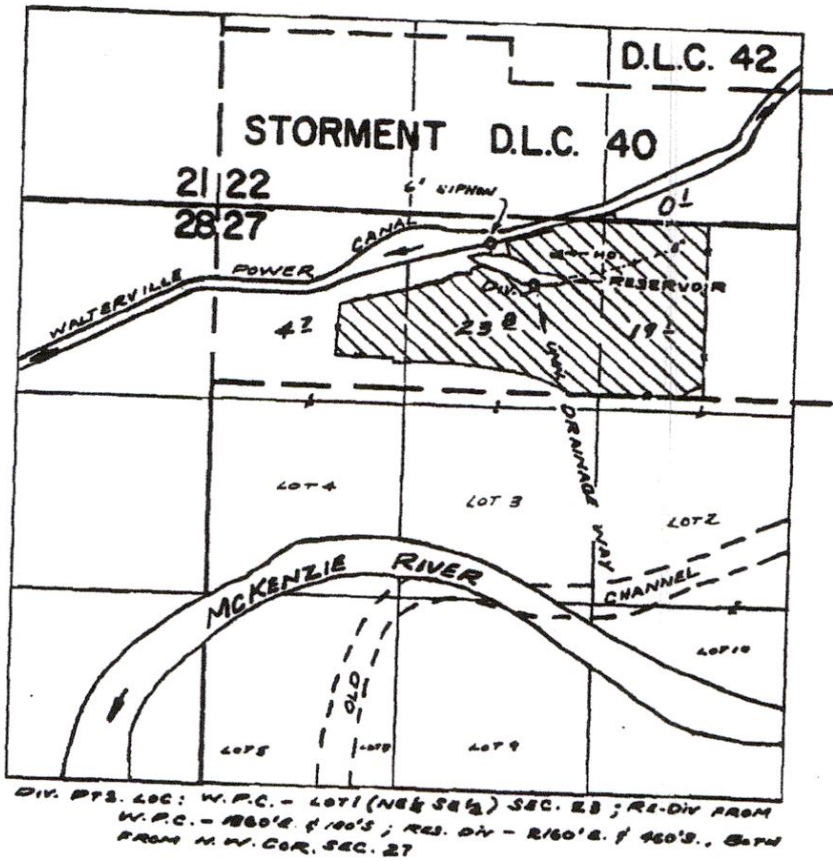

RECEIVED
OCT 01 2019
OWRD

FINAL PROOF SURVEY
UNDER

Application No. ⁴¹⁴⁴¹ R-42579. Permit No. ³¹⁷⁸⁵ R-4233.
IN NAME OF

JACK CRAWFORD

Surveyed Oct. 15, 1970, by R. MUCKEN.

CEIVED
1 2019
OWRD