


TR S QQ
8. 5. 20. SW-SE
SW

1" = 300ft

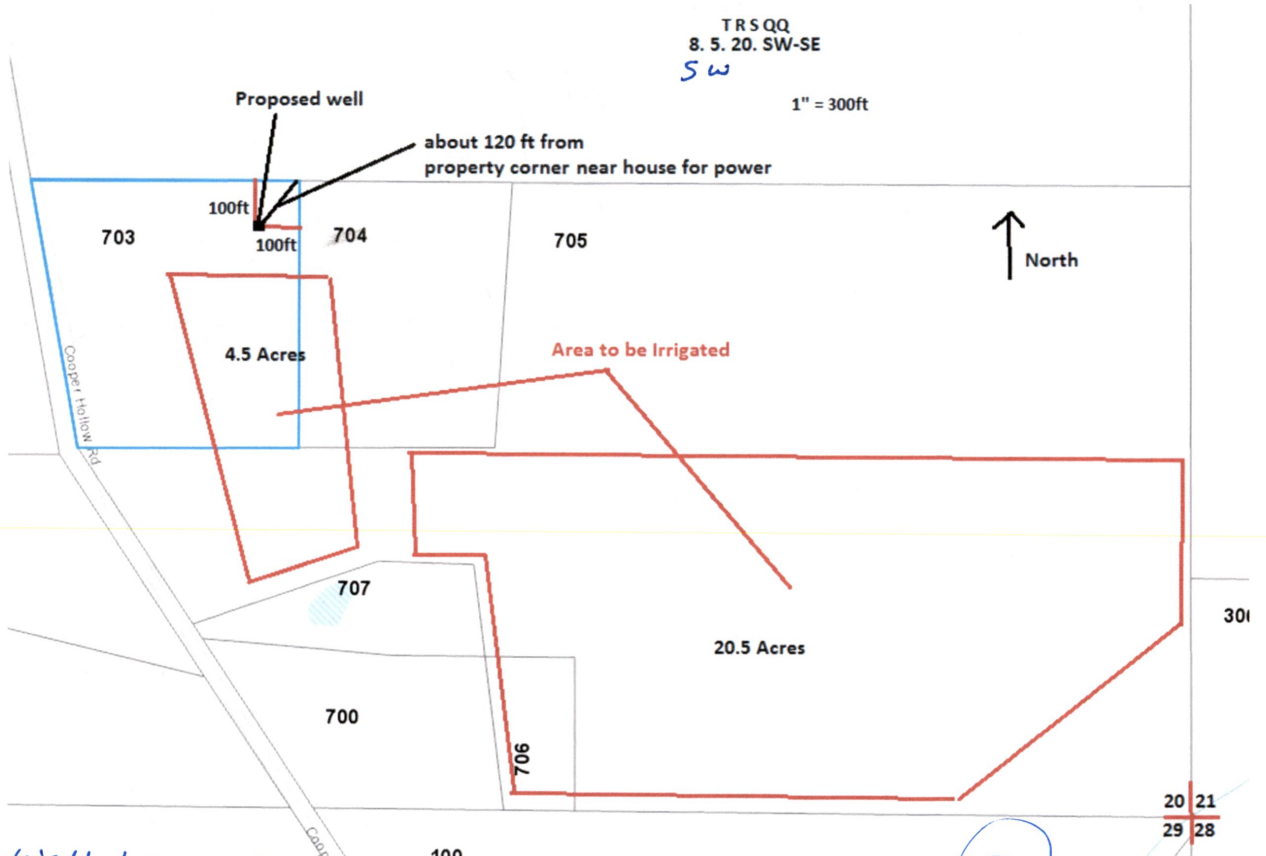

Proposed well

about 120 ft from property corner near house for power



703

704

705

100ft

100ft

4.5 Acres

Area to be Irrigated


707

20.5 Acres

30'

700

706

20 21
29 28

Well Loc. - 1240' N + 1910' W from SE, corner sec 20

SW

RECEIVED
OCT 03 2019
OWRD