



Oregon Water Resources Department
 725 Summer Street NE, Suite A
 Salem, Oregon 97301-1266
 (503) 986-0900
 www.wrd.state.or.us

Request for Assignment

By Proof of Ownership
(If Permit/Transfer Holder is Not Available)

If for multiple rights, a separate form and fee for each right will be required.

I, GAYLYNN AND RONALD J KRAMER
 (Name of Party Requesting Assignment)

5619 LITTLE RIVER RD. OR 97443 760.604.3551
 (Mailing Address) (City) (State) (Zip) (Phone #) *leave message!*

- ...hereby request assignment of application/permit/transfer;
- ...hereby request assignment of a portion of application/permit/transfer;
 (You must include a map showing the portion of the application/permit/transfer to be assigned.)

I have attached proof of ownership that may include but not be limited to: a copy of the deed to the land, a copy of a land sales contract, a court order or decree, documentation of survivorship of property held jointly. The Department cannot accept a copy of a tax statement. (Remember to include \$5 for each additional page.)

Application # S-74076 ; Permit # S 52577 ; Transfer# _____
 -OR-

GR Statement # _____ ; GR Certificate of Registration # _____

Water
JERRY + CYNTHIA MEDLAR
 (Name of Permit/Transfer Holder of Record)

3275 HUMPHREY RD LOOMIS CA 95650 (916)652-0687
 (Mailing Address) (City) (State) (Zip) (Phone #)

Note: You are required to furnish proof acceptable to the Department that notice of the assignment has been given or attempted for each identified property owner not a party to the assignment. ORS 537.220(2) Failure to submit this proof will result in the return of your request. (Proof may include but not be limited to: a copy of returned certified mailing, copy of a Death Certificate, or a court order.)

- 1) I certify that I am the current owner of the property described in this application, Permit or Certificate of Registration.
- 2) I have the legal right to request assignment under OAR 690-310-0280 and 690-320-0060.
- 3) I have not been able to contact the owner(s) of record for the above referenced application or water right.
- 4) I further certify that the information provided herein is true and correct to the best of my knowledge.

Witness my hand this 11 day of JUNE, 2007.

Party Requesting Assignment Gaylynn Kramer

Party Requesting Assignment Ronald J. Kramer

O.K. ASSIGN PARTIAL BY DEED
 [Signature]
 6/12/2007

DO NOT WRITE IN THIS BOX

This certifies assignment and record change at Oregon Water Resources Department effective 8:00 a.m. on date of receipt at Salem, Oregon.
 Fee receipt # 88090
 For Director by Jerry Sauter, Program Analyst in Water Rights Division *[Signature]*

The completed "Request for Assignment form must be submitted to the Department along with the appropriate recording fees:

- \$25 for the first page, and
- \$5 for each additional page [as required by ORS 536.050(1)(d)]

RECEIVED
 WR JUN 12 2007
 WATER RESOURCES DEPT
 SALEM OREGON

RECEIVED
FEB 17 1995
WATER RESOURCES DEPT.
SALEM, OREGON


App # 74076
Permit # 52577

27 26
34 35

WATER RIGHT APPLICATION MAP

APPLICATION S 74076

T26S, R3W, WM
DOUGLAS COUNTY
SCALE 1" = 400'

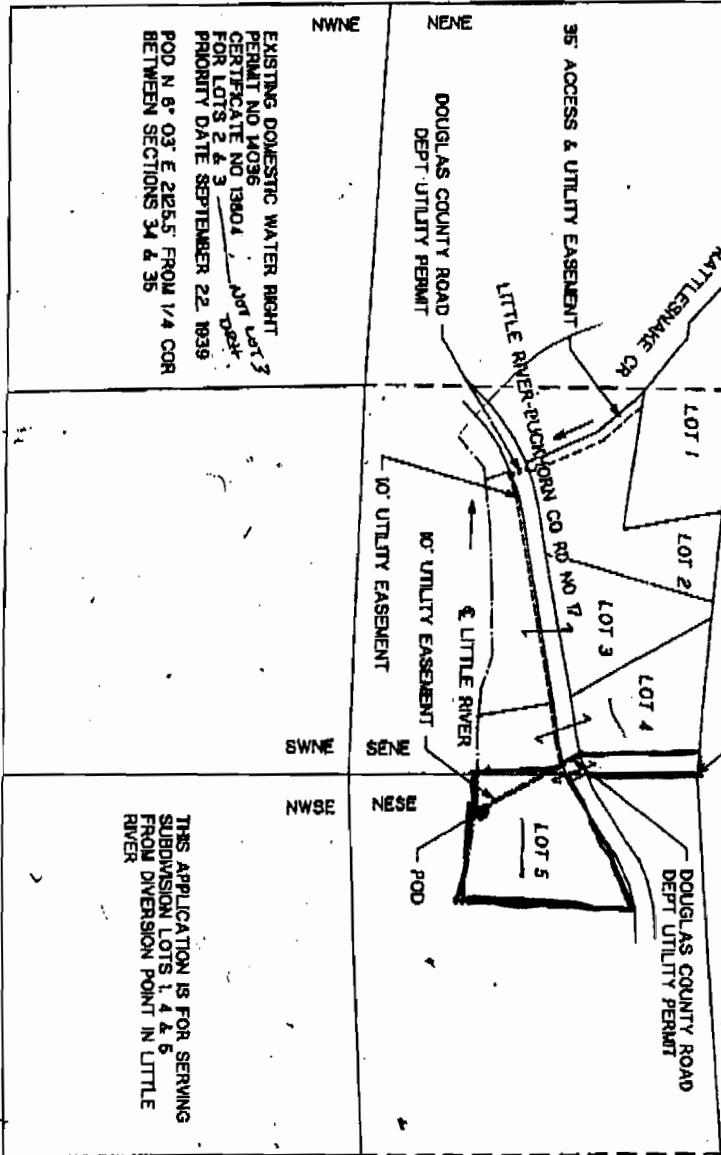


EXISTING DOMESTIC WATER RIGHT
PERMIT NO M036
CERTIFICATE NO 13604
FOR LOTS 2 & 3
PRIORITY DATE SEPTEMBER 22, 1939
POD N. 87° 03' E. 2125.5' FROM 1/4 COR
BETWEEN SECTIONS 34 & 35

THIS APPLICATION IS FOR SERVING
SUBDIVISION LOTS 1, 4 & 5
FROM DIVERSION POINT IN LITTLE
RIVER

POD IS 130 FT S AND 760 FT W FROM THE E 1/4 COR SEC 34

THIS IS A LOCATION MAP FOR A WATER RIGHT APPLICATION BY
RICHARD SUMNER AND MARCIA SUMNER. THIS MAP IS FOR THE
PURPOSE OF IDENTIFYING THE LOCATION OF THE WATER RIGHT
ONLY AND IS NOT INTENDED TO PROVIDE LEGAL DIMENSIONS OR
LOCATIONS OF PROPERTY OWNERSHIP LINES.

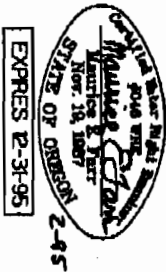


RECEIVED

JUN 12 2007

WATER RESOURCES DEPT
SALEM OREGON

52577