


T. 26 S., R. 3 W., W.M.

SECTION II

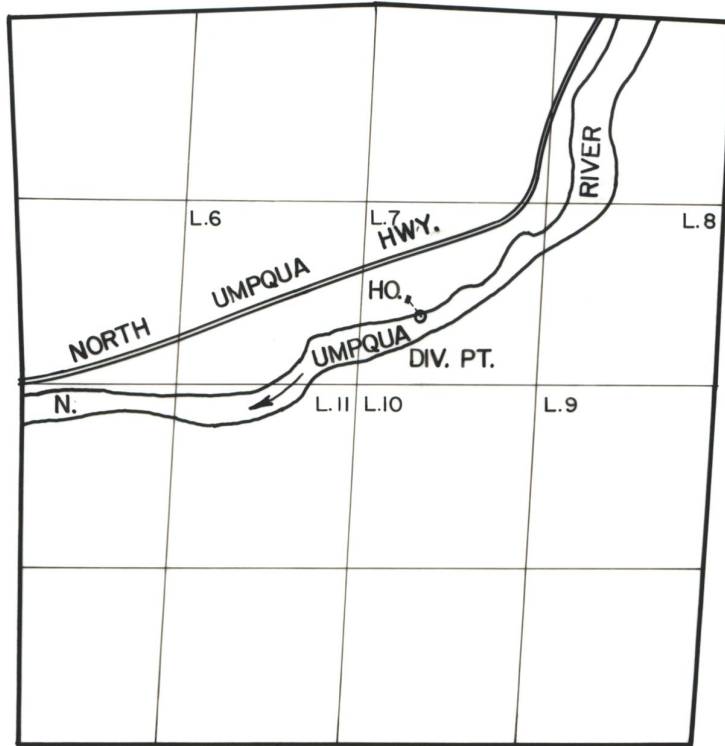

DIV. PT. IS LOCATED 490' N. & 2900' E. FROM W. 1/4 CORNER SEC. II

SCALE: 4" = 1 MILE

FINAL PROOF SURVEY UNDER

Application No. ..65305.. Permit No. ..47687.....
IN NAME OF

.....**JAMES & JEANNE WALLACE**.....

Surveyed .SEPT..18. 19.86, by .J.M...SCHMORDE..