


# Township 9 South, Range 46 East.

## DITCHES and WATER-USERS

- Green Ditch  
Green
- Howell Ditch  
C. Brooks  
Bert Masterson  
Luther Mathews  
M. Olsen  
T. Siegle
- Kay Young  
B. Evans  
E. Griggs  
J. Hartly  
I.L. Holcomb
- Nameless
- Newt Young  
J.L. Coffinbery  
D.H. Conrad  
E. Griggs  
I.L. Holcomb  
E. Shumaker  
E. Sullivan
- Siegle  
Luther Mathews  
T. Siegle
- Tom Pierce  
Bert Masterson
- Weaver  
Chas. Harvel

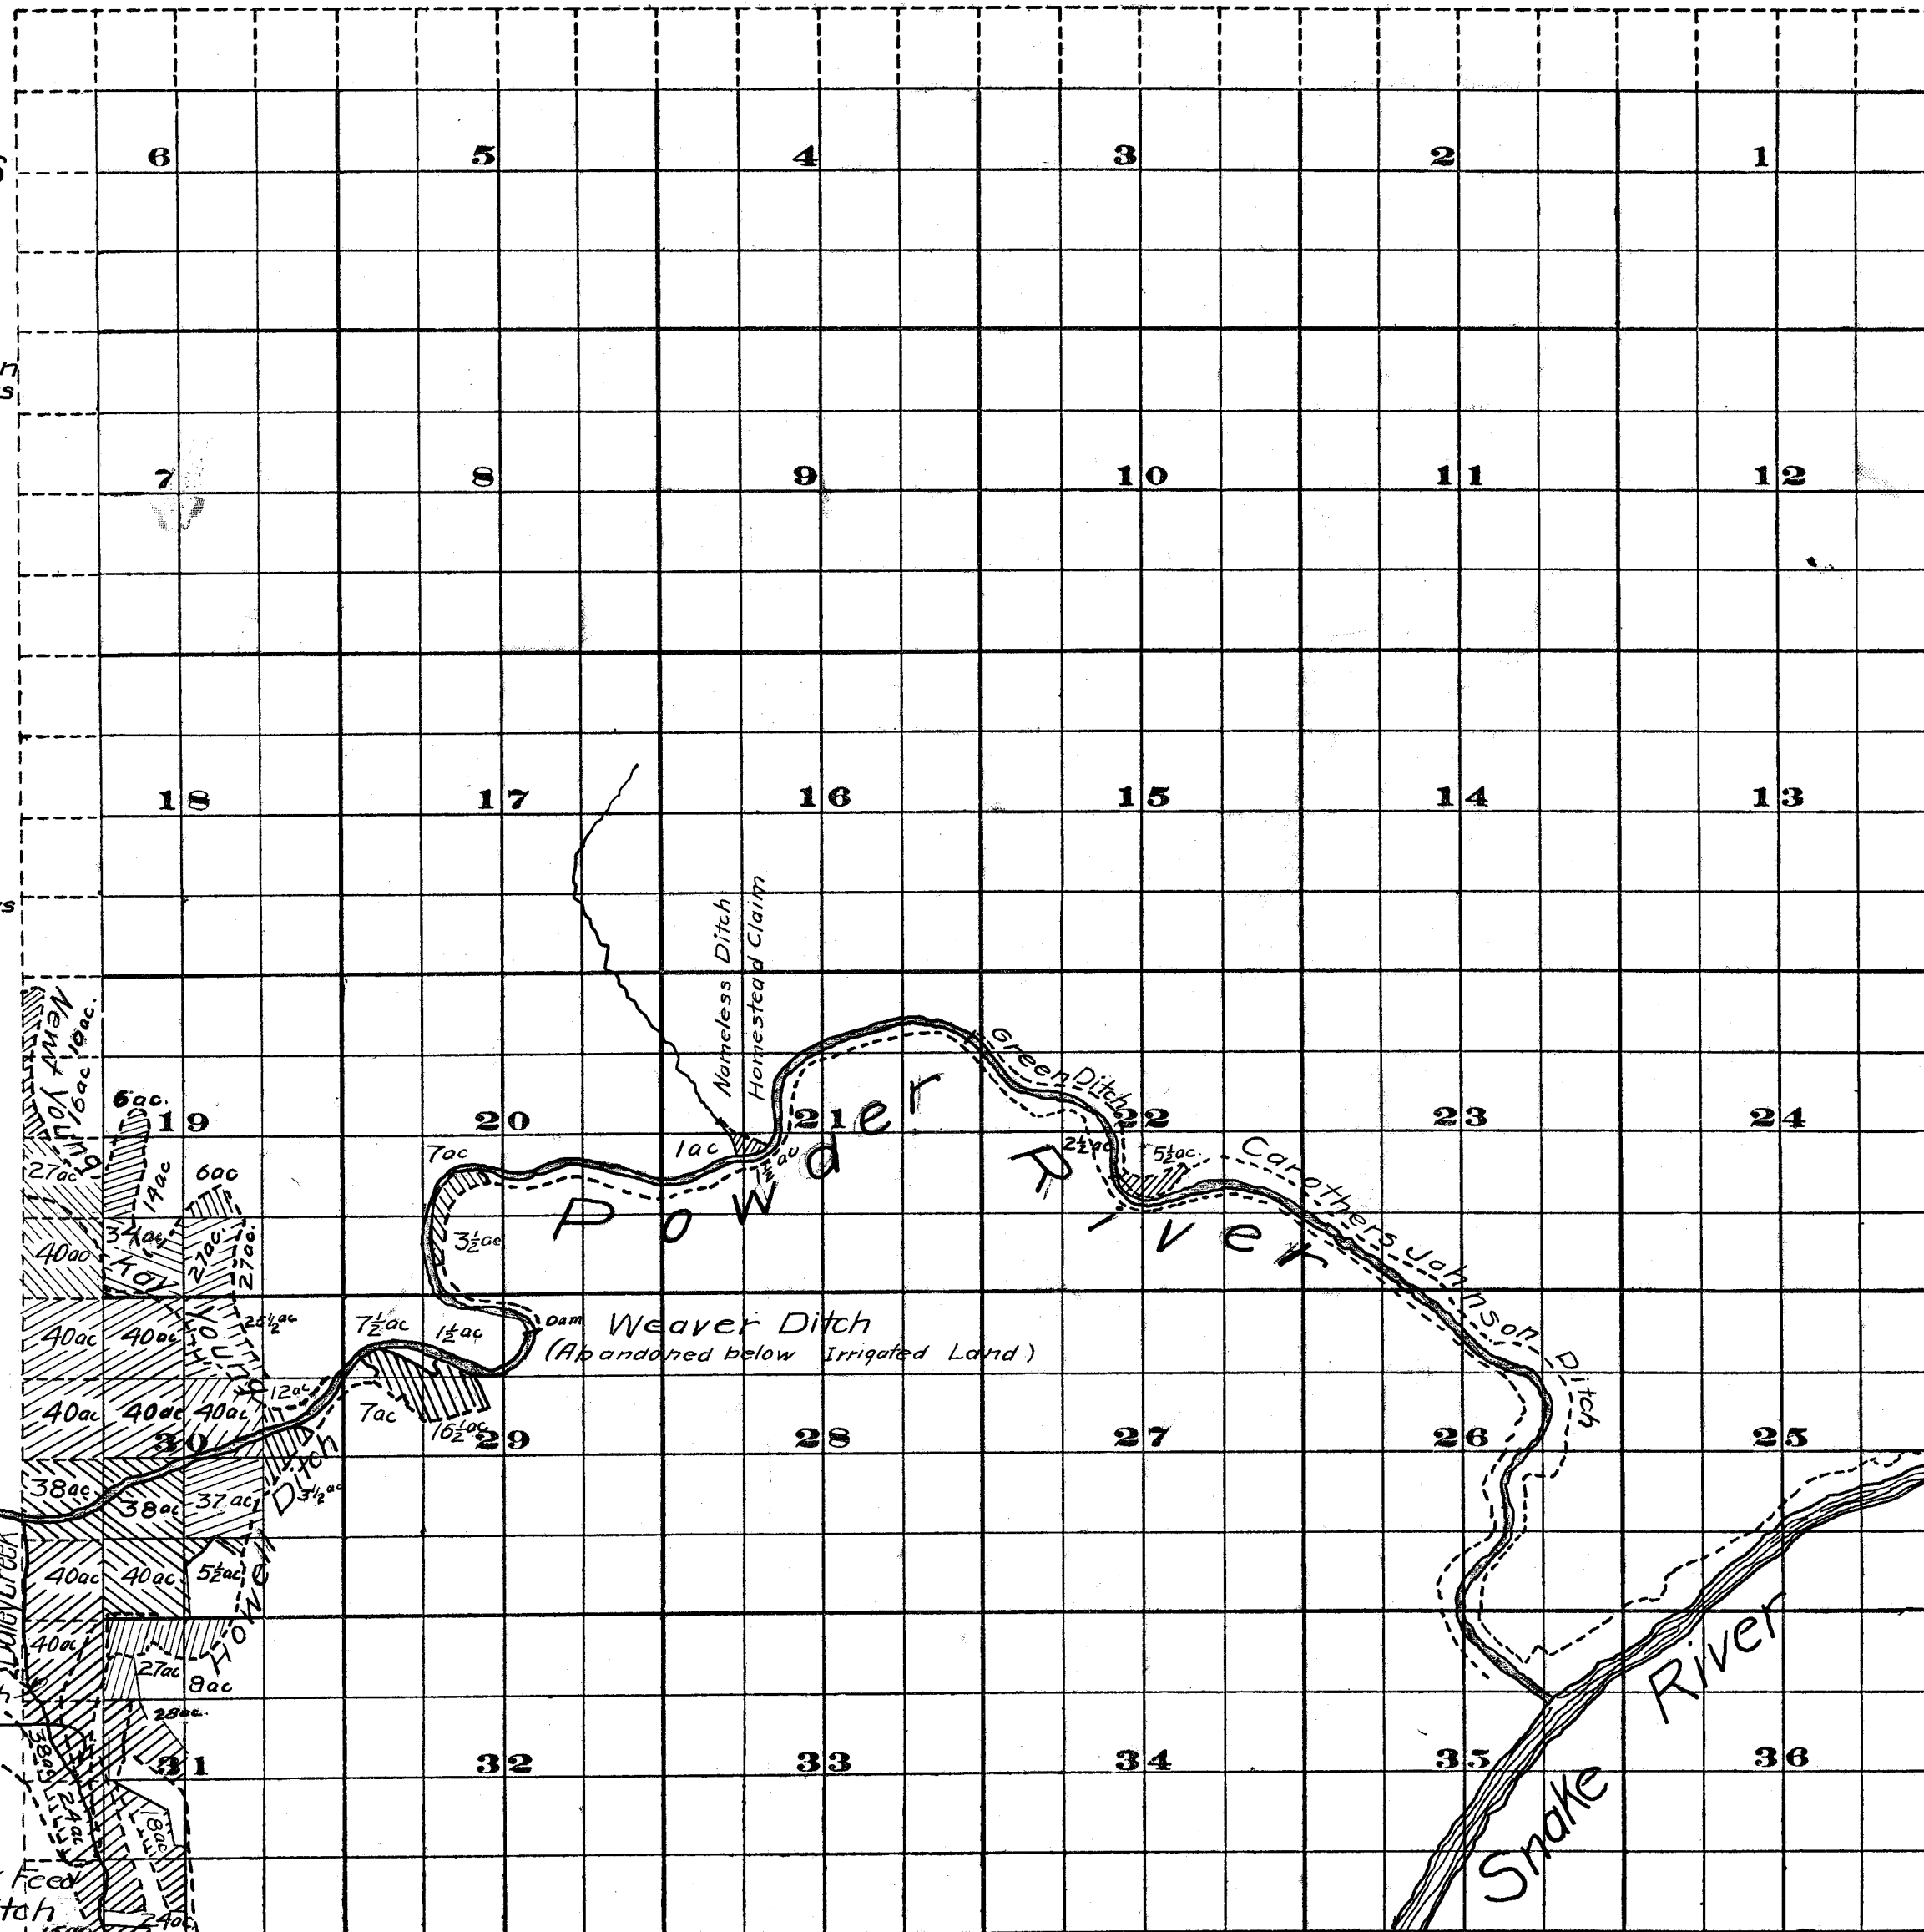

Survey By Rhea Luber May 1911  
Scale of Feet.

- Irrigated land with area
- Ditches
- Streams

FROM OFFICE OF THE STATE ENGINEER, SALEM, OREGON

Powder River Adjudication  
John H. Lewis S  
Examined June 5 1912