


Davis Reservoir 4 South 12 East Section 19

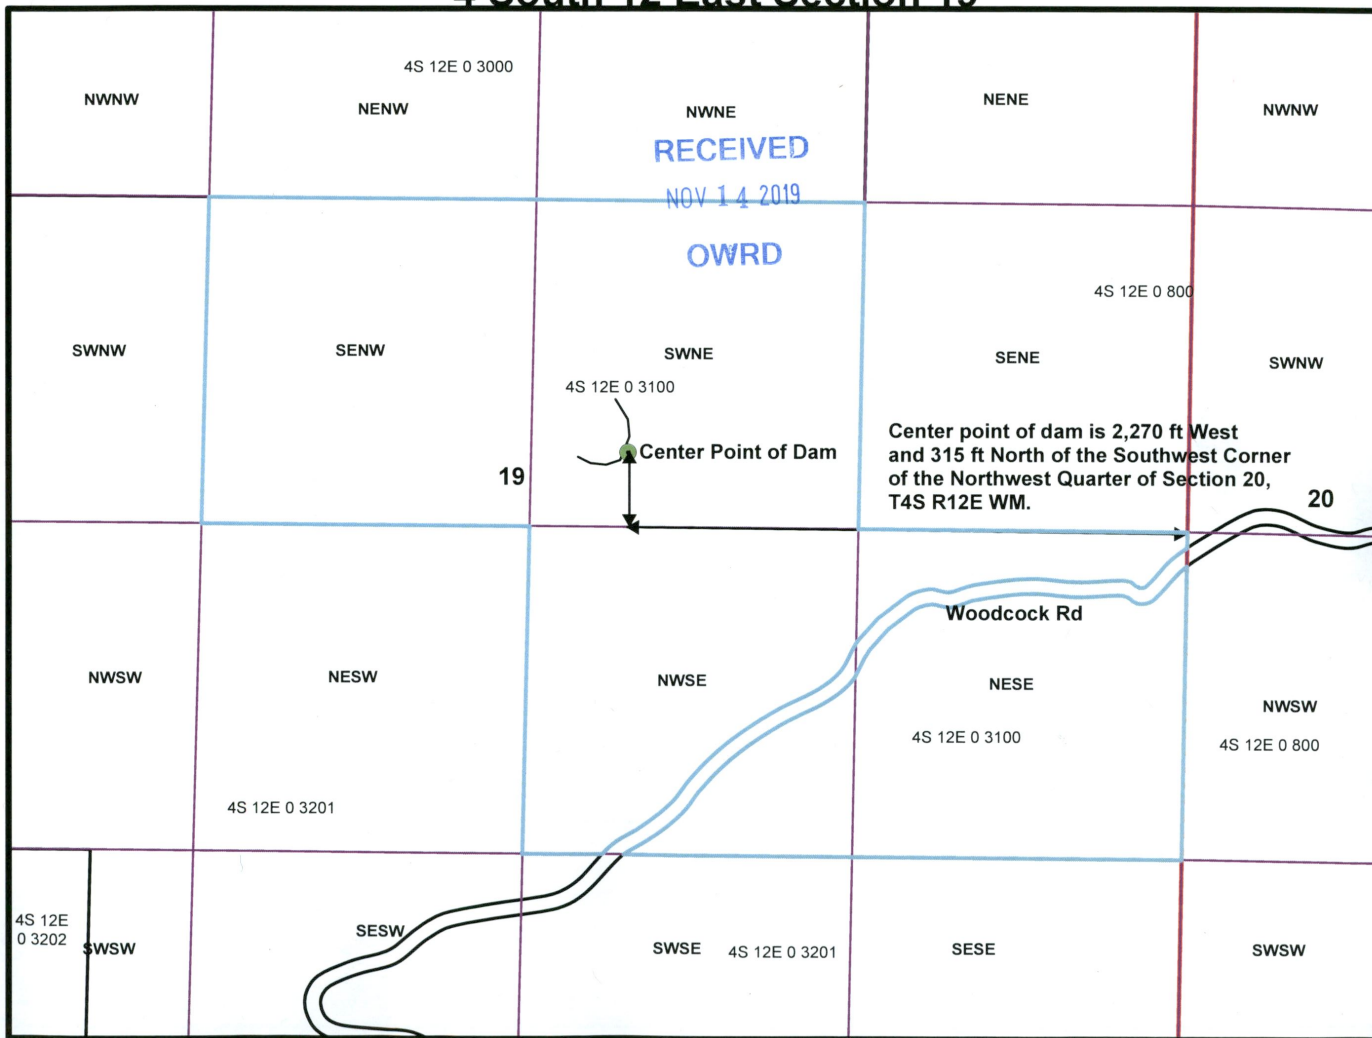

RECEIVED

NOV 14 2019

OWRD

Blue Border is Tax Lot 3100

