


1" = 1320'

Tax Lot:

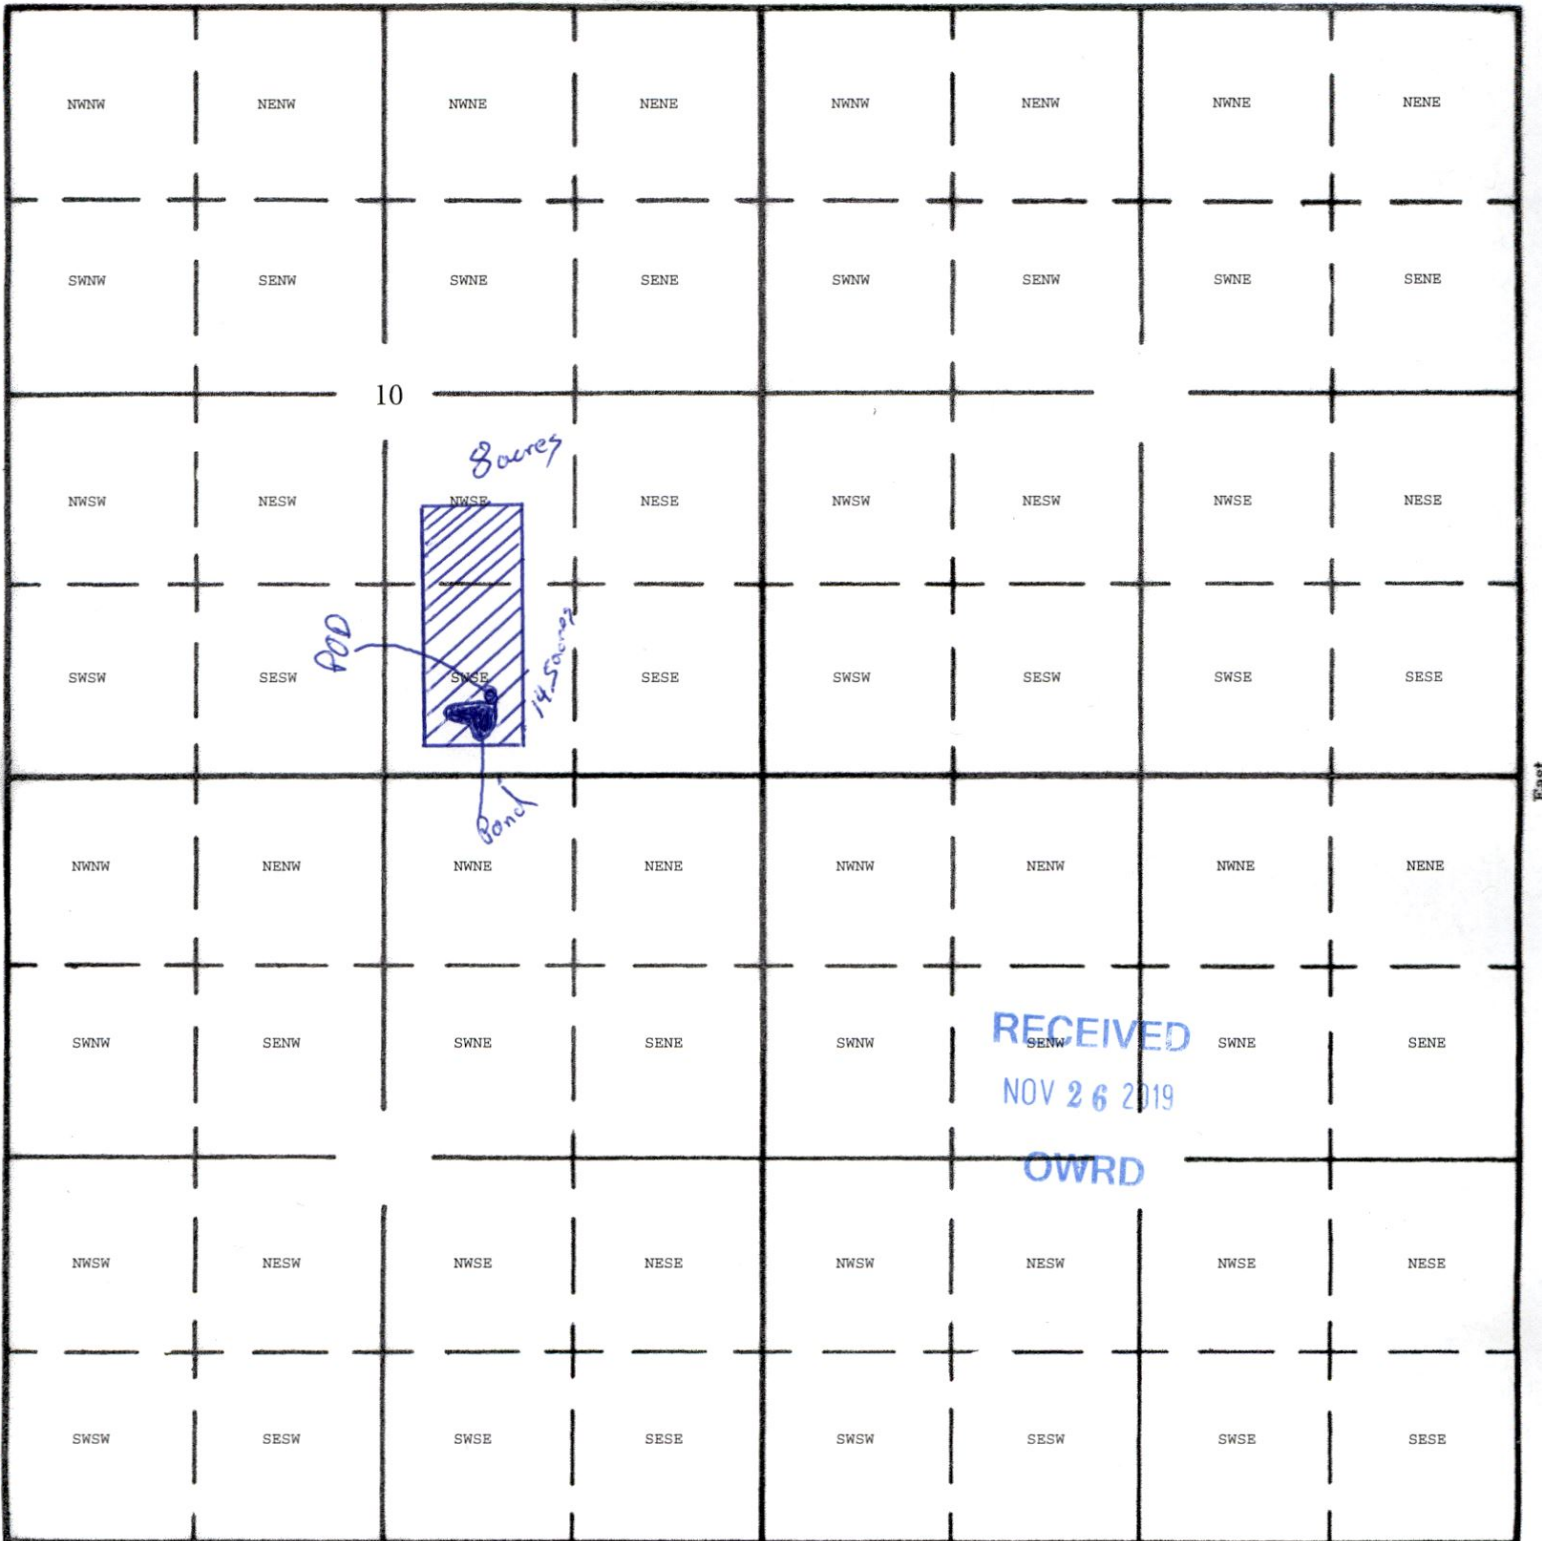

Township 7 South, Range 5 West, Section 10, Tax Lot 801 & 802



POD: 610 feet North and 1825 feet West, from SE Corner Section 10

Total Acres = 22.5


S-00702


 11/26/19 

THIS MAP IS FOR ASSESSMENT AND TAXATION PURPOSES ONLY

SEC. 10 T.7S. R.5W. W.M.
Polk County
1" = 400'

7.5.10

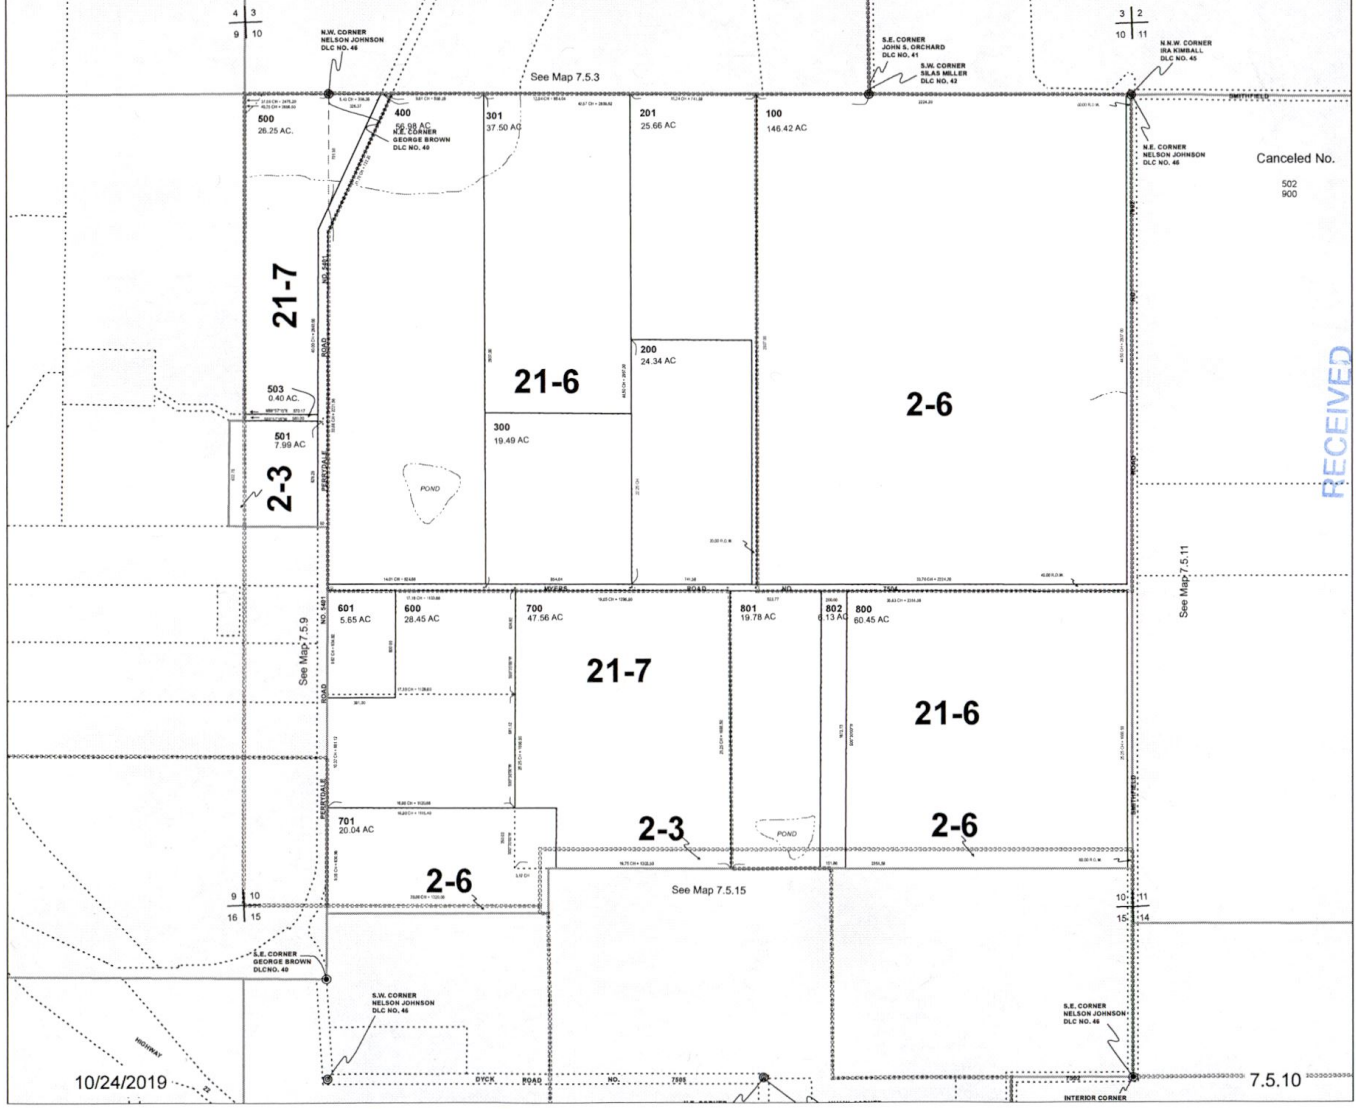

10/24/2019

7.5.10

RECEIVED

NOV 26 2019

OWRD

S-80702