


THIS MAP IS NOT INTENDED TO PROVIDE LEGAL DIMENSIONS OR LOCATIONS OF PROPERTY OWNERSHIP LINES.

Application Map for Township 15S Range 5W Section 9 Benton County Tax Lot 155090000700

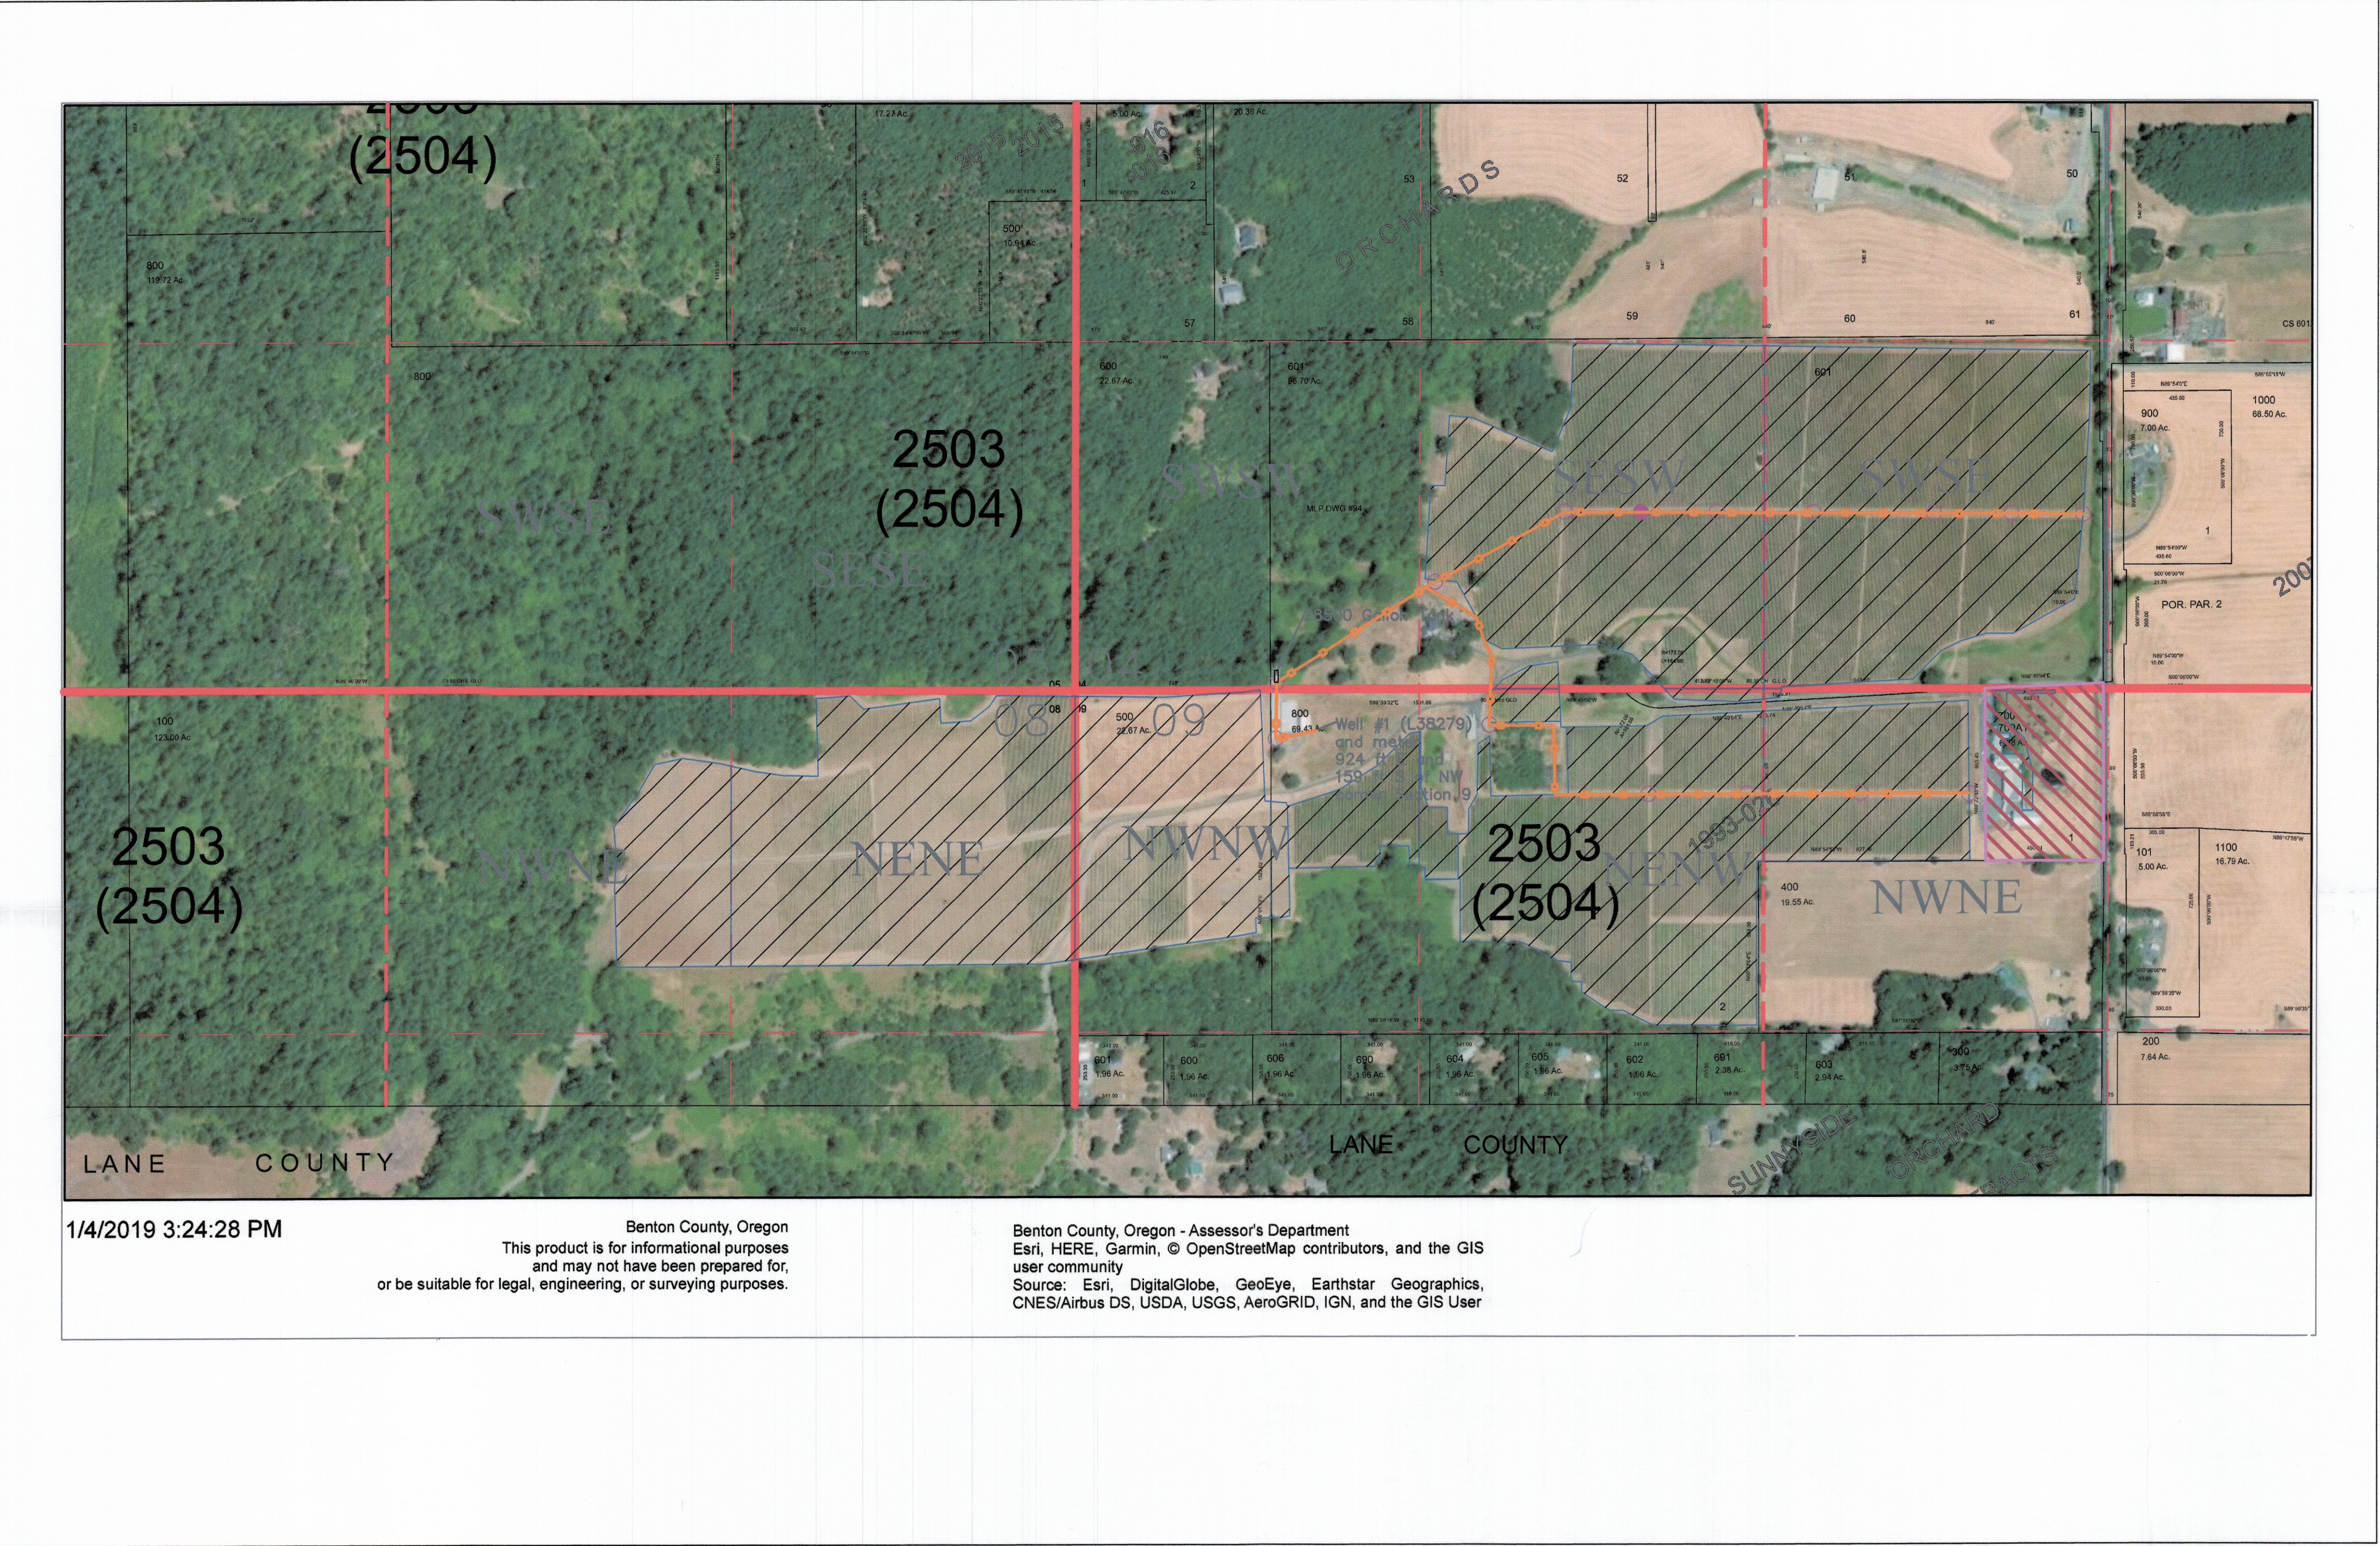

Area of Application
Winery Operations
Benton County Tax Lot
155090000700
T15S, R3W, NWNE Sec 9
6.88 Acres

Area of Claim of Beneficial
Use for Permit G15300,
Application G15218.

Burried
2" PVC
Line

Tax Lot
Boundaries

Section
Lines

Quarter
Section
Lines

Quarter
Quarter
Lines

400' 0 400' 800'
1 inch = 400 feet

RECEIVED
DEC 12 2019
OWRD

Certified Water Right Examiner
76773WRE
Steven I Recca
June 29, 2007
STATE OF OREGON

EXPIRATION DATE:12/31/20