

POINTS OF DIVERSION

| No. | Description | Corner Tie |
|-----|-------------|---|
| 1 | Spring | 710 ft. North & 660 ft. East of the SW corner of Section 17 |

RECEIVED

SEP 28 1998

WATER RESOURCES DEPT.
SALEM, OREGON

LEGEND

Spring



Scale: 1" = 400 ft.
(Same as Assessor Plat)


**FINAL PROOF SURVEY OF A
PERMIT TO APPROPRIATE SURFACE WATER**
in the E 1/2 E 1/2 of Section 18 & in the SW 1/4 of
Section 17, T 20 S, R 10 W, W. M., Douglas
County, Oregon

Application No. S-73398

Permit No. 51554

For: J. Grant Dunn & Daniel J. Dunn
P. O. Box 623
Reedsport, Oregon 97467

By: Shaner Engineering, Inc.
P. O. Box 1430
Roseburg, Oregon 97470

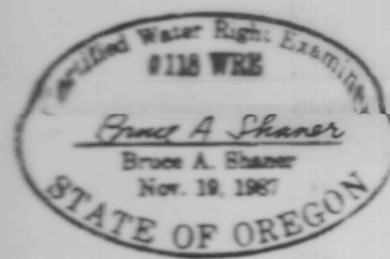

September 25, 1998