



Oregon Water Resources Department
 725 Summer Street NE, Suite A
 Salem, Oregon 97301
 (503) 986-0900
www.wrd.state.or.us

Request for Assignment

RECEIVED

DEC 02 2019

OWRD

If the Department determines that the application is incomplete, fees have not been paid, or the required documents are not acceptable, the application and all fees submitted will be returned to the applicant. If for multiple rights, a separate form and fee for each right will be required.

I, Stan Seifer
 (Name of Current Holder of Record)

11045 Waypark NE, Salem, OR 97305 503-508-4434
 (Mailing Address) (City) (State) (Zip) (Phone #)

- hereby assign all my interest in and to the entire application/permit/transfer/limited license/groundwater statement; (example, sold all the land authorized under the right)
- hereby assign all my interest in and to a portion of application/permit/transfer/limited license/groundwater statement; (You must include a map showing the portion of the application/permit/transfer/limited license/groundwater statement to be assigned. Example, sold a portion of the land authorized under the right)
- hereby assign a portion of my interest in and to the entire application/permit/transfer/limited license/groundwater statement; (example, adding an additional person)

Application # _____; Permit # G-12983; Transfer # _____;

Limited License # _____; Groundwater Statement # _____;

as filed in the office of the Water Resources Director, to:

Northwest Farm Credit Services, FLCA 650 Hawthorne Ave SE, Suite 210, Salem, OR 97301-5895
 (Name of New Owner) (Mailing Address) (City) (State) (Zip)

and

Joseph G. Ruef and Darcy J. Ruef, co-Trustees of the Joseph and Darcy Ruef Family Trust, UTD 02/11/2015
 (Name of New Owner)

12305 Ruef Lane Mt. Angel, OR 97362 971-563-1694
 (Mailing Address) (City) (State) (Zip) (Phone #)

Note: If there are other owners of the property described in this application, permit, transfer order, limited license, or groundwater statement, you must provide a list of all other owners' names and mailing addresses and attach it to this form. Write the initials (first letters) of your first and last names at the spot indicated below _____.

SVS I hereby certify that I have notified all other owners of the property described in this application, permit, transfer order, limited license, or groundwater statement of this Request for Assignment

Witness my hand this X 22nd day of X NOVEMBER, 20X 19
 (Day) (Month) (Year)

Signature of Current Holder of Record X Stan Seifer
 Stan Seifer

Failure to provide any of the required information will result in the return of your application.

This certifies assignment and record change at Oregon Water Resources Department effective 8:00 a.m. on date of receipt at Salem, Oregon.

Fee receipt # 131529
 For Director by Mary F. Bjork, Program Analyst in Water Rights Division. Mary F. Bjork

The completed "Request for Assignment" form *must* be submitted to the Department along with the recording fee of \$100.




Part. Assign - Approve
 KBB 12-16-19

T. 6 S. R. / W. W. M.

RECEIVED

APR 19 1995

WATER RESOURCES DEPT.
SALEM, OREGON

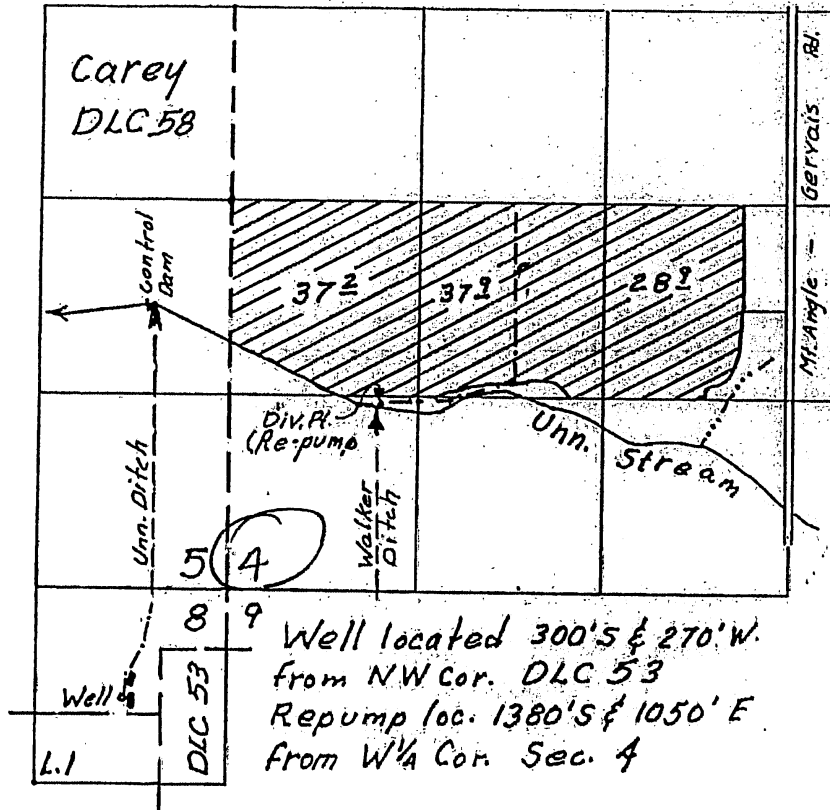


Scale
4" = 1 Mi.

RECEIVED
DEC 13 2019
OWRD

WATER RIGHT MAP FOR
Stanley V. & Beverly A.
SEIFER

APPLICATION: G-13290

THIS MAP WAS PREPARED FOR THE PURPOSE OF IDENTIFYING THE LOCATION OF A WATER RIGHT ONLY AND IS NOT INTENDED TO PROVIDE LEGAL DIMENSIONS OR LOCATION OF PROPERTY OWNERSHIP LINES.

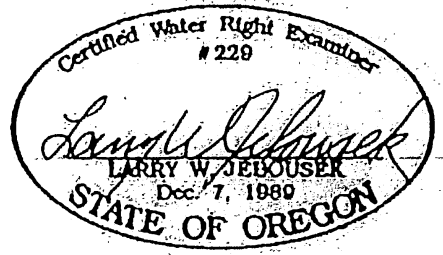



Oregon

Kate Brown, Governor

Water Resources Department

North Mall Office Building

725 Summer St NE, Ste A

Salem, OR 97301

Phone: 503-986-0900

Fax: 503-986-0904

www.Oregon.gov/OWRD

November 4, 2019

Northwest Farm Credit Services
650 Hawthorne Ave SE, Ste 210
Salem, OR 97301

Reference: Application G-13290, Permit G-12983

The assignment from Stan Seifer to Joseph G. and Darcy J. Ruef, and Northwest Farm Credit Services, FLCA has been recorded in the records of the Water Resources Department.

The Departments records will now show Joseph G. and Darcy J. Ruef, and Northwest Farm Credit Services, FLCA as the permit holders of record.

Our records have been changed accordingly and the original request is enclosed. Receipt number 131178 covering the recording fee is also enclosed.

A permit is not a perfected water right, and has conditions and timelines that must be satisfied prior to a Certificate of Water Right being issued. Please review the permit to be familiar with the conditions and timelines contained in the permit.

Sincerely,

Mary F. Bjork
Water Rights Program Analyst
Water Right Services Division

Enclosure: Original Request and Receipt #131178

cc: Stan Seifer – 11045 Waypark NE, Salem, OR 97305
Joseph G. and Darcy J. Ruef – 12305 Ruef Lane, Mt. Angel, OR 97362
Data Center, OWRD (cover letter & request)
File

