


Permit # 54709

T.28S. R.6W. W.M.
DOUGLAS COUNTY
Scale 1" = 500'

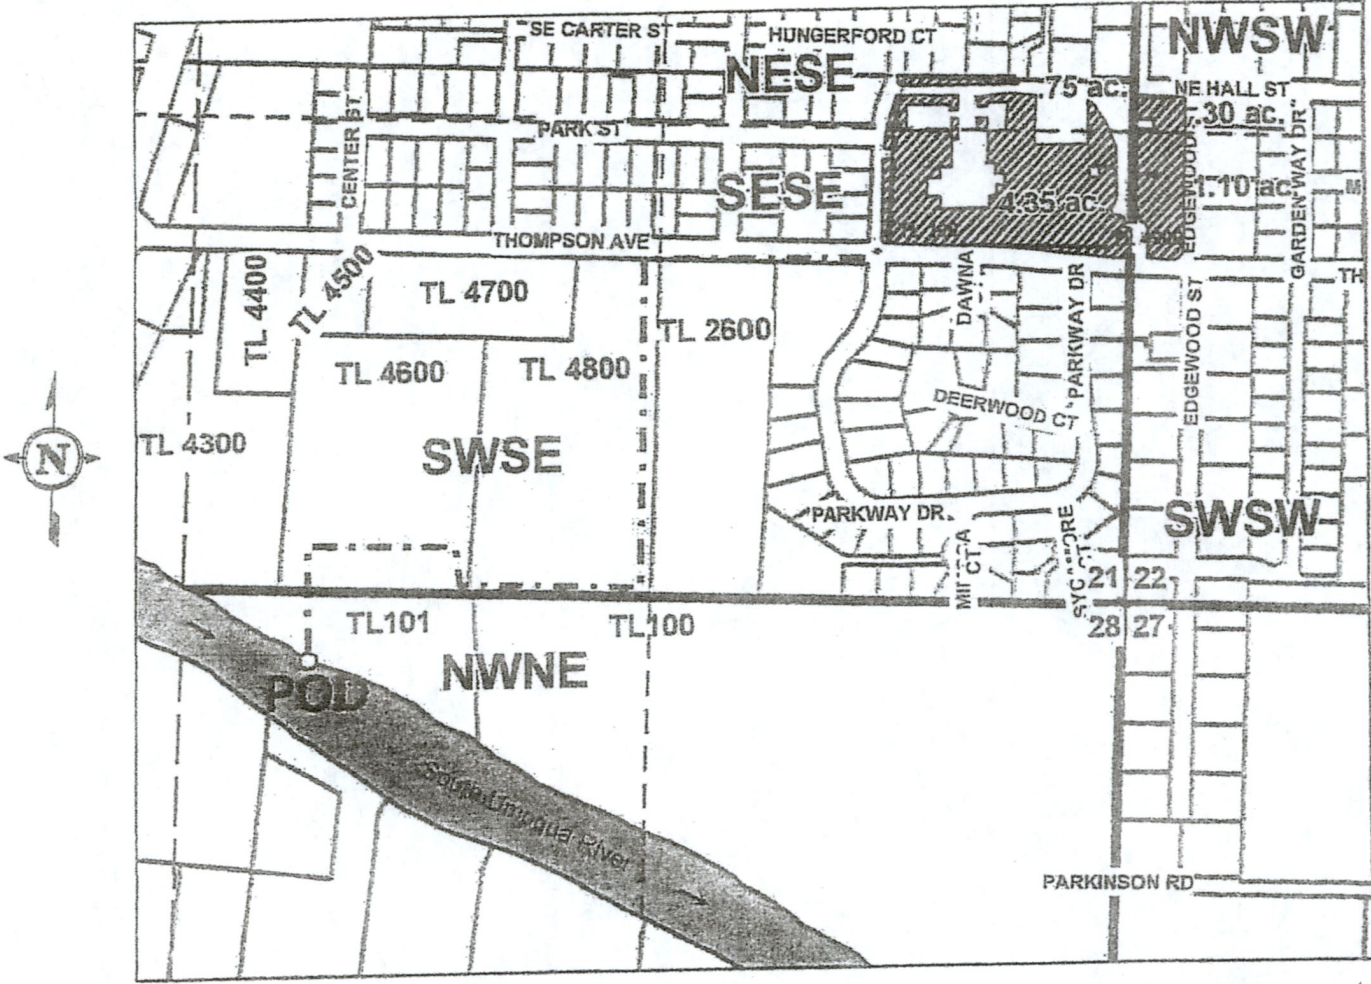

Point of Diversion is located 140 ft. S. and 2290 ft. W.
from the Northeast corner of Section 28.

RECEIVED
JAN 13 2020
OWRD

S-00793