


T30S R12W
Portion
Sec 23

Application No. 59262
Permit No. 44499

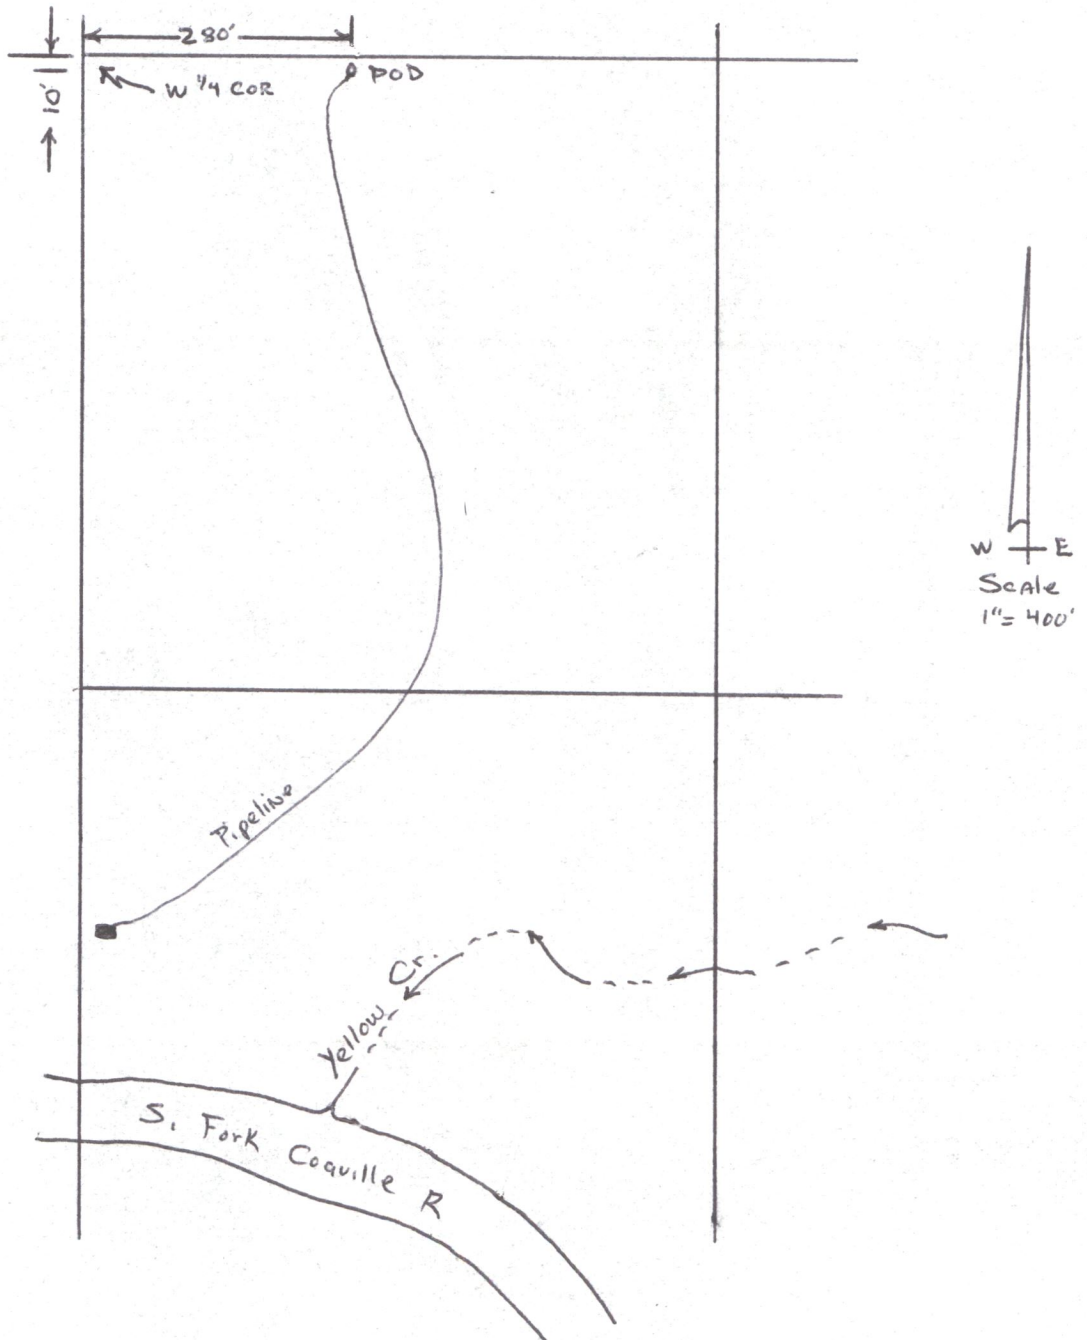


THIS MAP PREPARED BY: J P DROLET, DIST
FROM INFORMATION FURNISHED BY THE
APPLICANT,

RECEIVED
JUL 26 1979
WATER RESOURCES DEPT
SALEM, OREGON

FIG. 1-12-2
SECTION

Application No.
Permit No. 114791

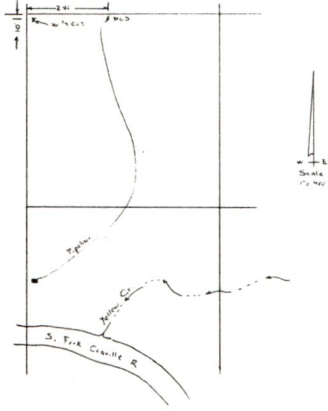

THIS MAP PREPARED BY: F. DEARLE, DIST. OF
FROM INFORMATION FURNISHED BY THE
APPLICANT.

RECEIVED
JUL 26 1979
WATER RESOURCES DEPT
SALEM, OREGON

Copy