


T255 R12W Sec 27
1" = 400'

RECEIVED
DEC 5 1968
STATE ENGINEER
SALEM OREGON

RECEIVED
NOV 25 1968
STATE ENGINEER
SALEM OREGON

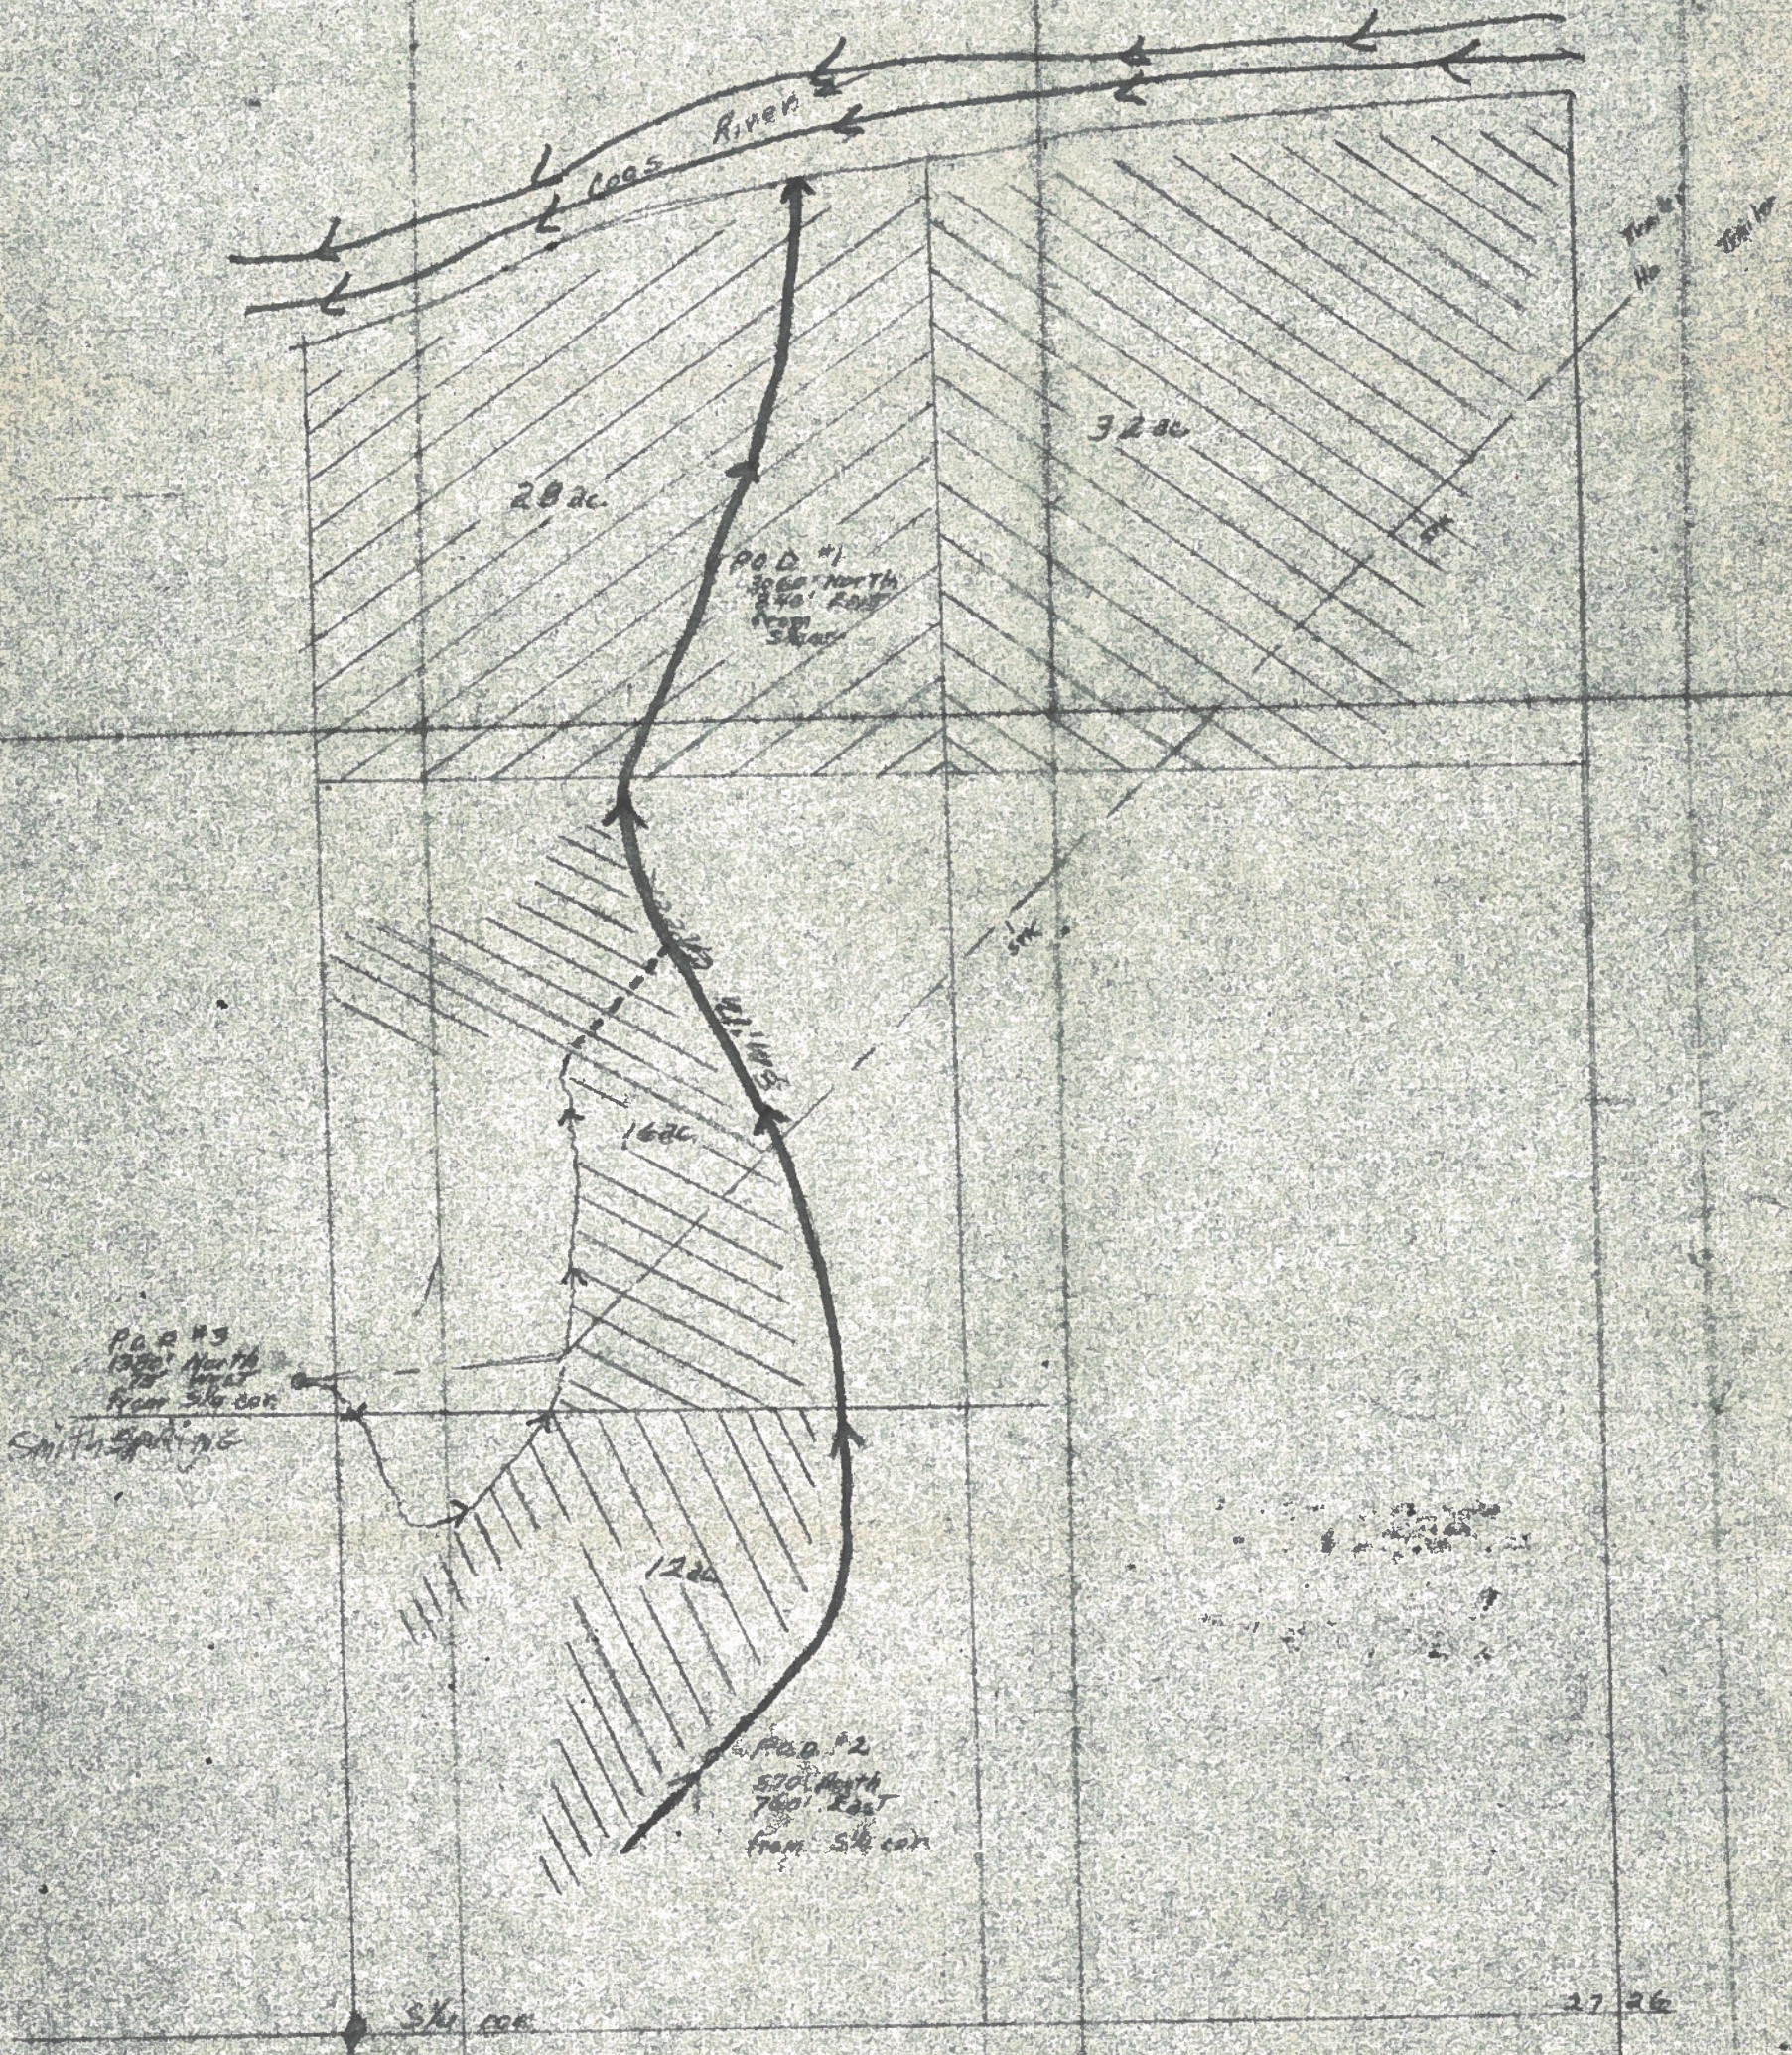

Application No. 45606
Permit No. 33989

27 26

do-jan-1968