


T25S R12W Sec. 27
1" = 400'

RECEIVED
DEC 5 1968
STATE ENGINEER
SALEM OREGON

RECEIVED
NOV 25 1968
STATE ENGINEER
SALEM OREGON

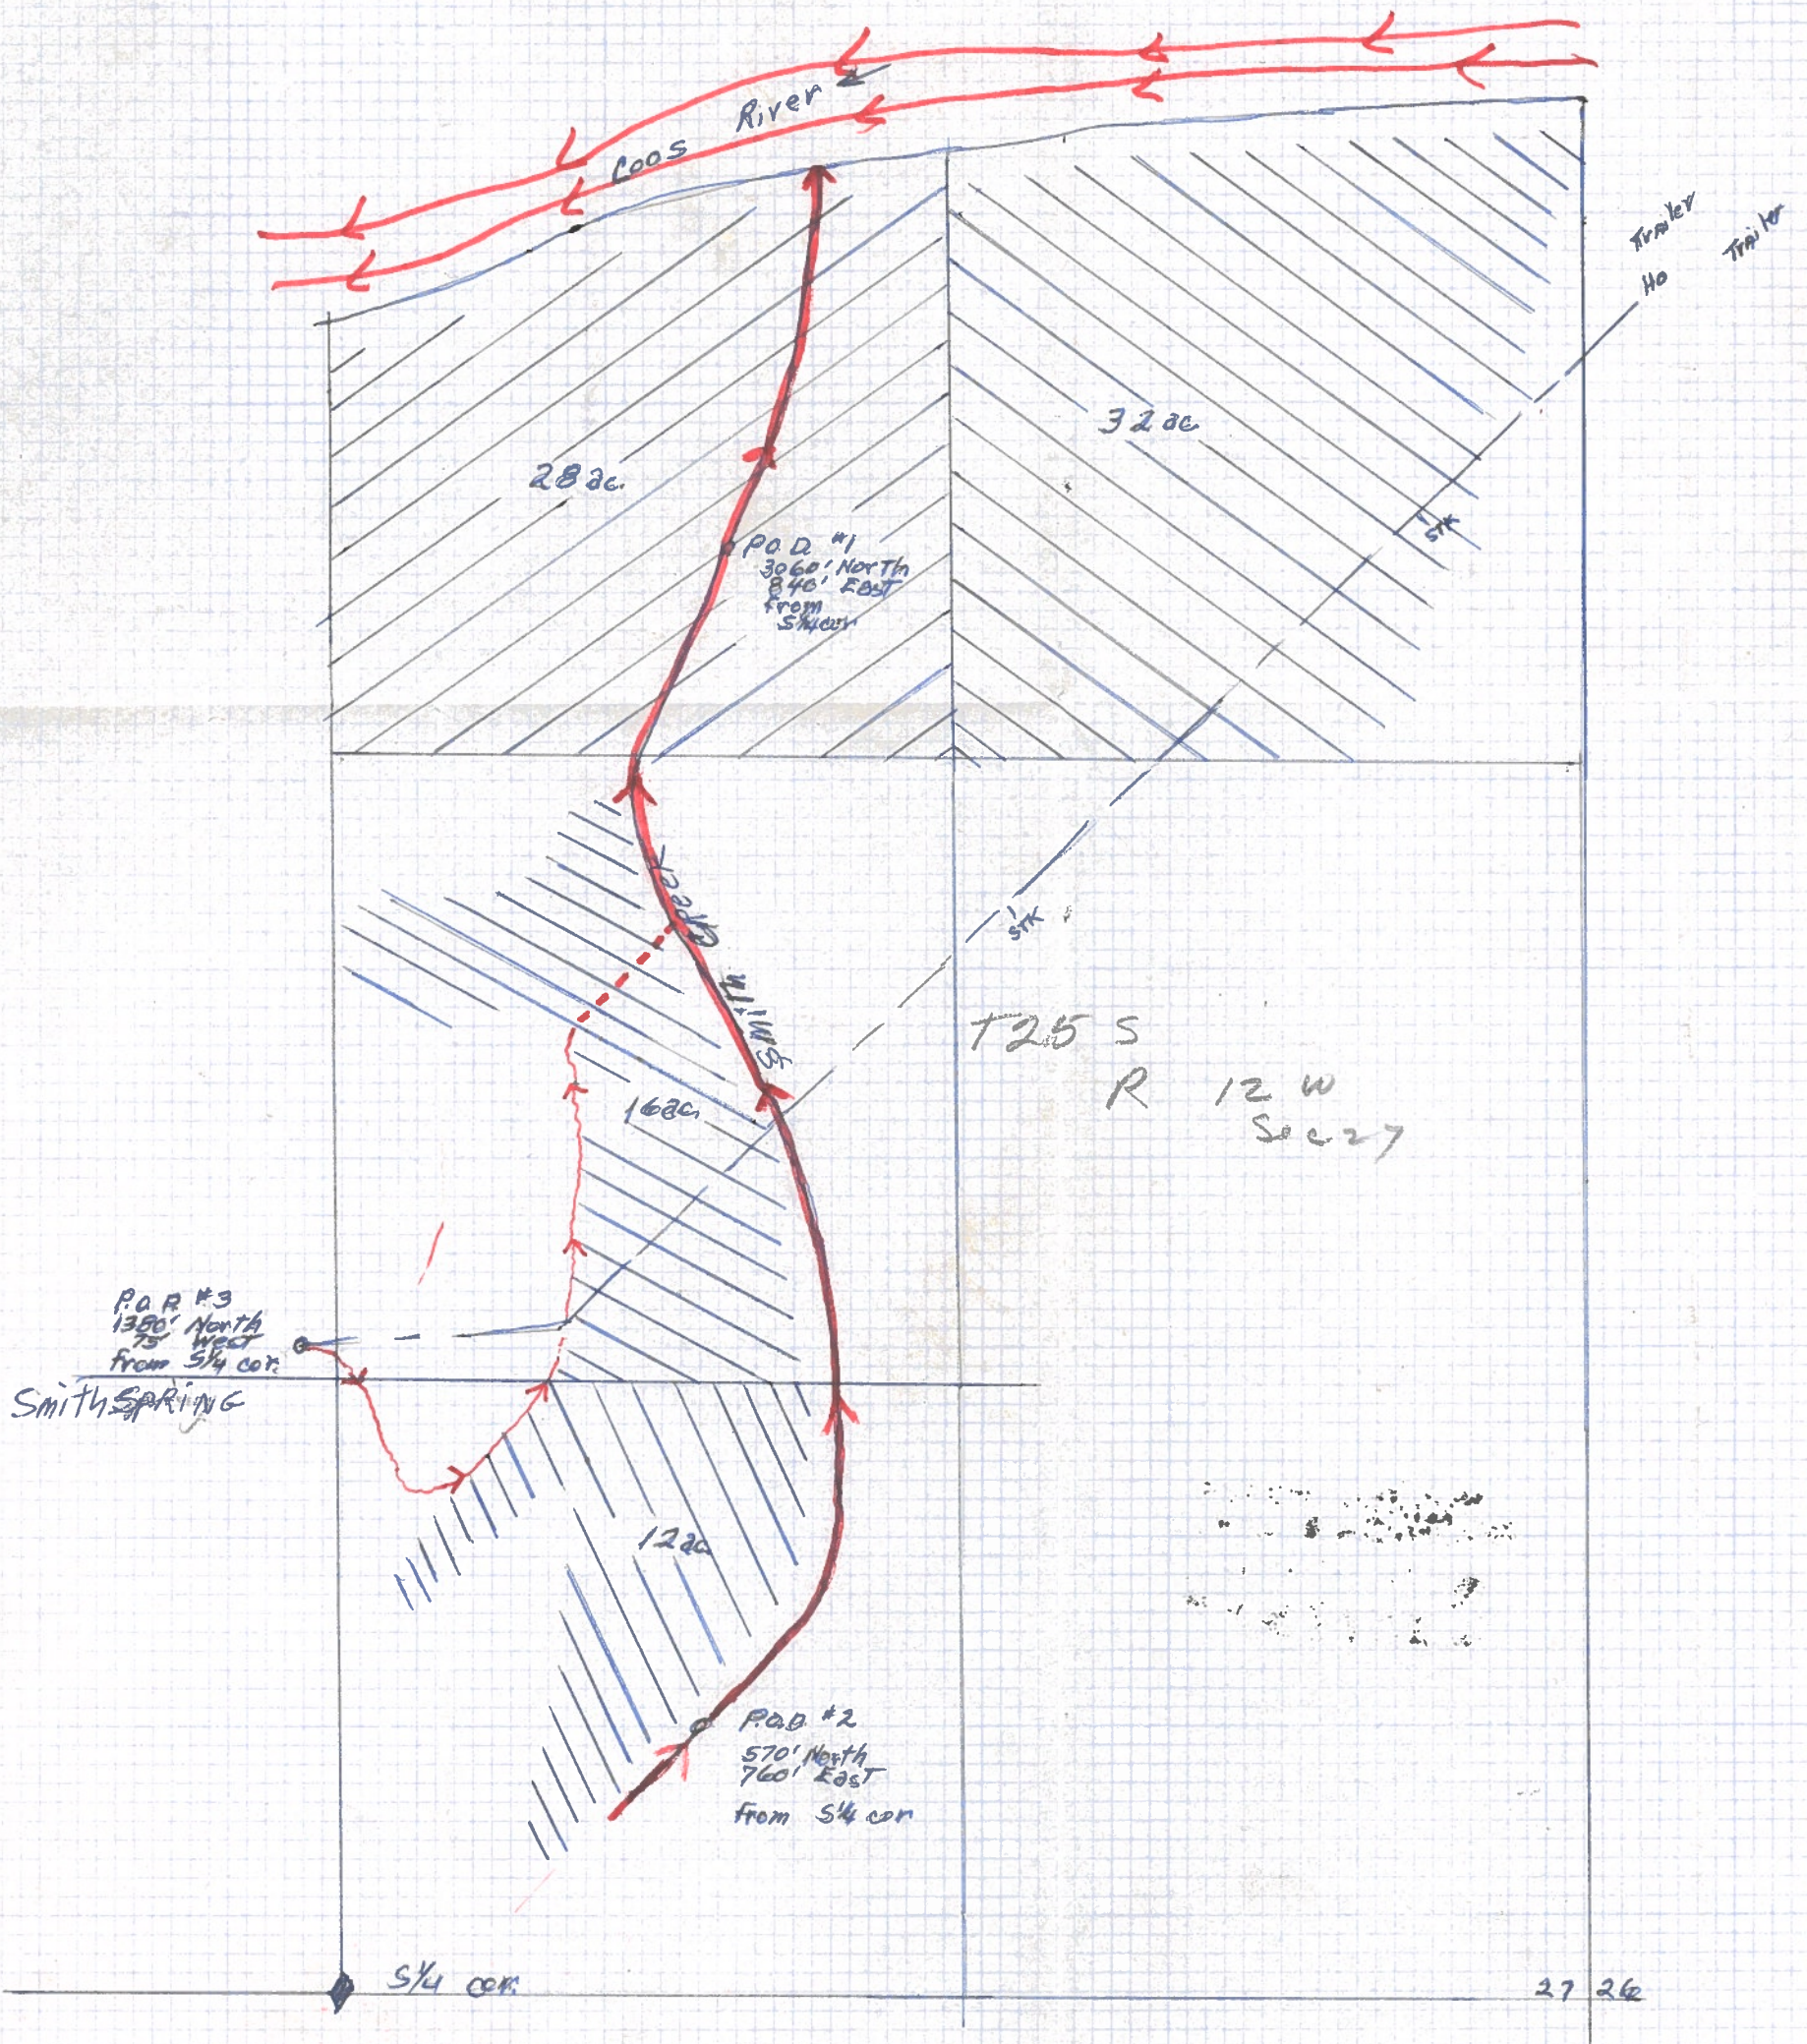

Application No. 45606
Permit No. 33989

George W. Smith